

# Lloyd's Register of British and Foreign Shipping.

(Report on Vessel No.

Port

50.

## SHIP FORGINGS ~~OR CASTINGS~~

I have to report that the undermentioned Iron ~~or Steel Forging~~ ~~or Castings~~ manufactured by *Macpherson Willard & Co.* *Bordentown N.J.* for the Vessel No. *444*, being built *The Newport News S.B.C. of Newport News Va.* been inspected by me as set forth below, and found to be, so far as can be seen, *good and sound forging of good material.*

*R.M.M. Laren*

*Surveyor.*

STERN FRAME.

~~RUDDER FRAME.~~

~~STEM.~~

*Iron Scrap billets*


*Forged.*

*11 x 7 1/2*

Inspection *Before welds were made & when forging was completed*

Inspected *21<sup>st</sup> July } 1902.*  
*11 Aug.*

OF FRAMES SHOWING POSITION AND DESCRIPTION OF WELDS OF FORGINGS, OR PARTICULARS OF TESTS APPLIED TO CASTINGS.

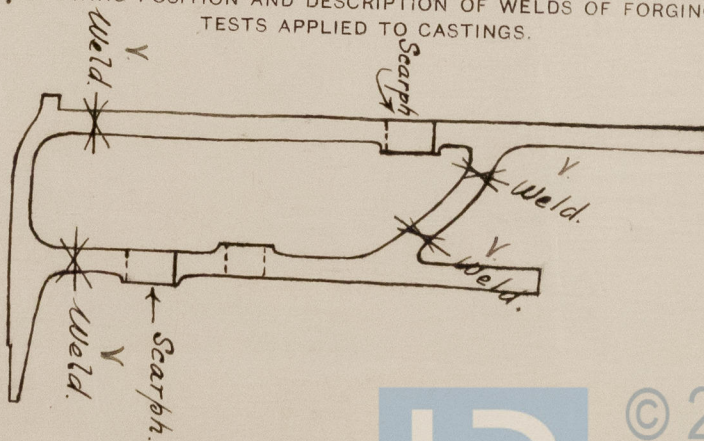

(any chargeable) *\$30.00.*

paid at *Philadelphia. Nov 20<sup>th</sup> 1902.*

\* If of Iron, state whether scrap or puddled Iron.



© 2021

Lloyd's Register  
Foundation

W1351-0163



No. 414



© 2021

Lloyd's Register  
Foundation