

SECTION THRO' WING COMB^N CHAMBER
SHOWING GIRDER STAY BOLTS.

533.

3 BOILERS FOR № 533.

SCALE:- 1" = 1 FOOT.

Dunsmuir & Jackson

Boilers nos 533. 215lbs.

Lloyd Royal Belge St no 5

N^o 15426
LLOYD TEST

430 LBS

WP 215 --

13-8-20

J.E.

N^o 15430
LLOYD TEST

430 LBS

WP 215 --

16-8-20

A.T.T.

N^o 15437
LLOYD TEST

430 LBS

WP 215 --

17-8-20

A.T.T.

S. Asier


GLASGOW REPORT No. 40412.

RETAIN

© 2021
W1351-0209



Lloyd's Register
Foundation

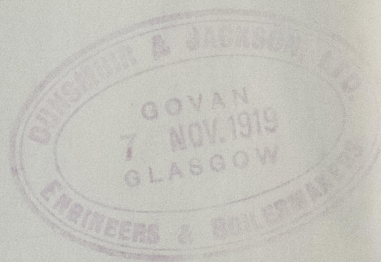

W1351-0209



© 2021

Lloyd's Register
Foundation