


PROFILE AND DECK.

N^{os} 577 & 595.

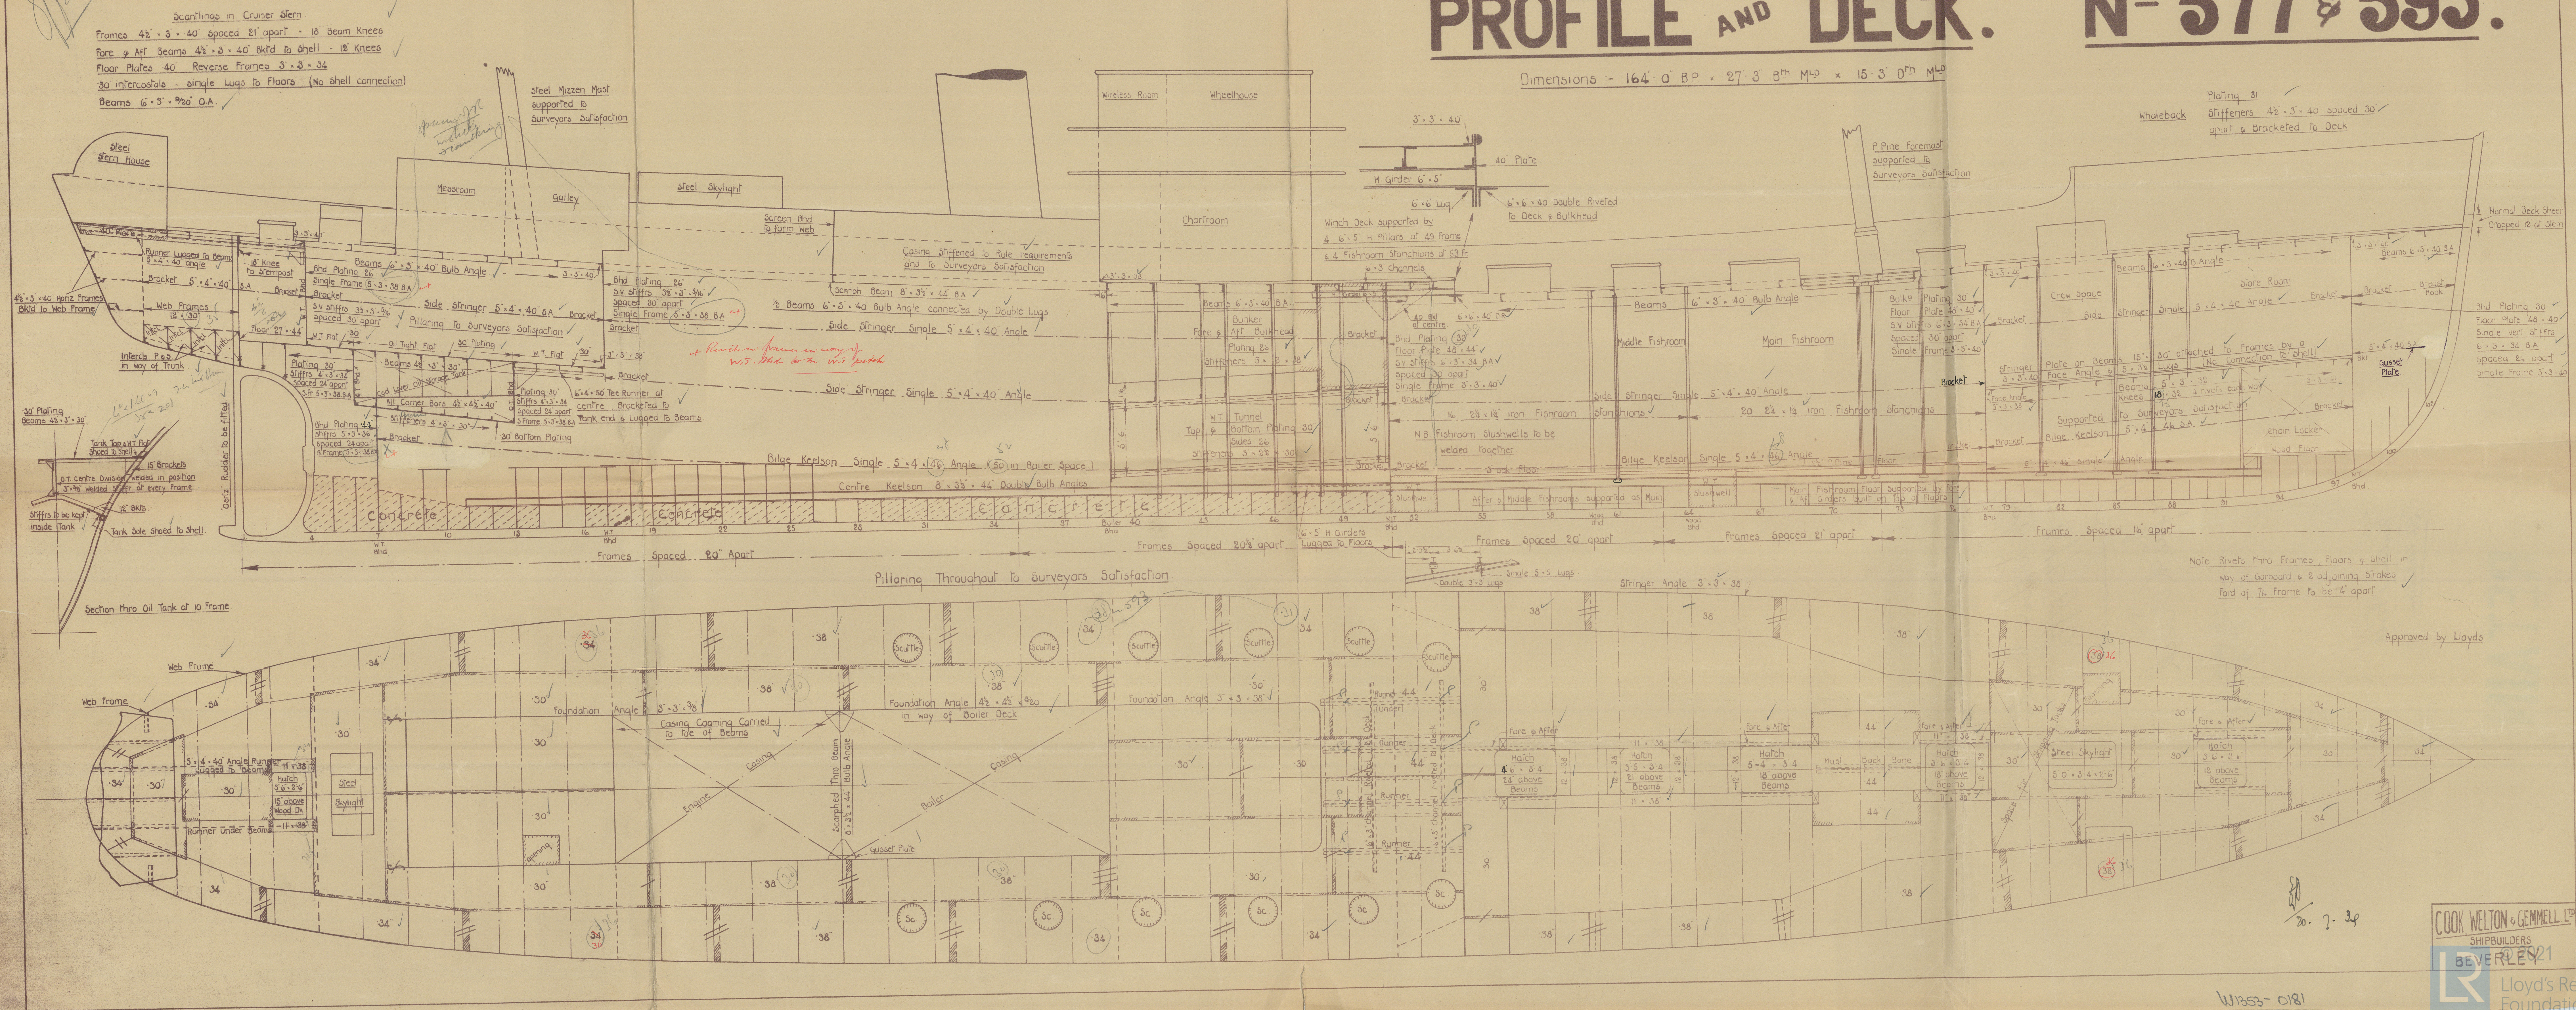

Book, Dalton & Gummel's
544-595

(1)

Profile & Deck

GEN. BOX NO

~~174~~

Pentland Firth

Pentland Firth

"St. Achilles"

RETAIN

W1353-0181



© 2021

Lloyd's Register
Foundation