

Office Catalog

S. 408


Takelrifs.

1/100.

$$L \times (B + C) = 23441$$

Bemerkung.

Alles stehende Gut aus verzinkten
42 drahtigen Stahlseil.

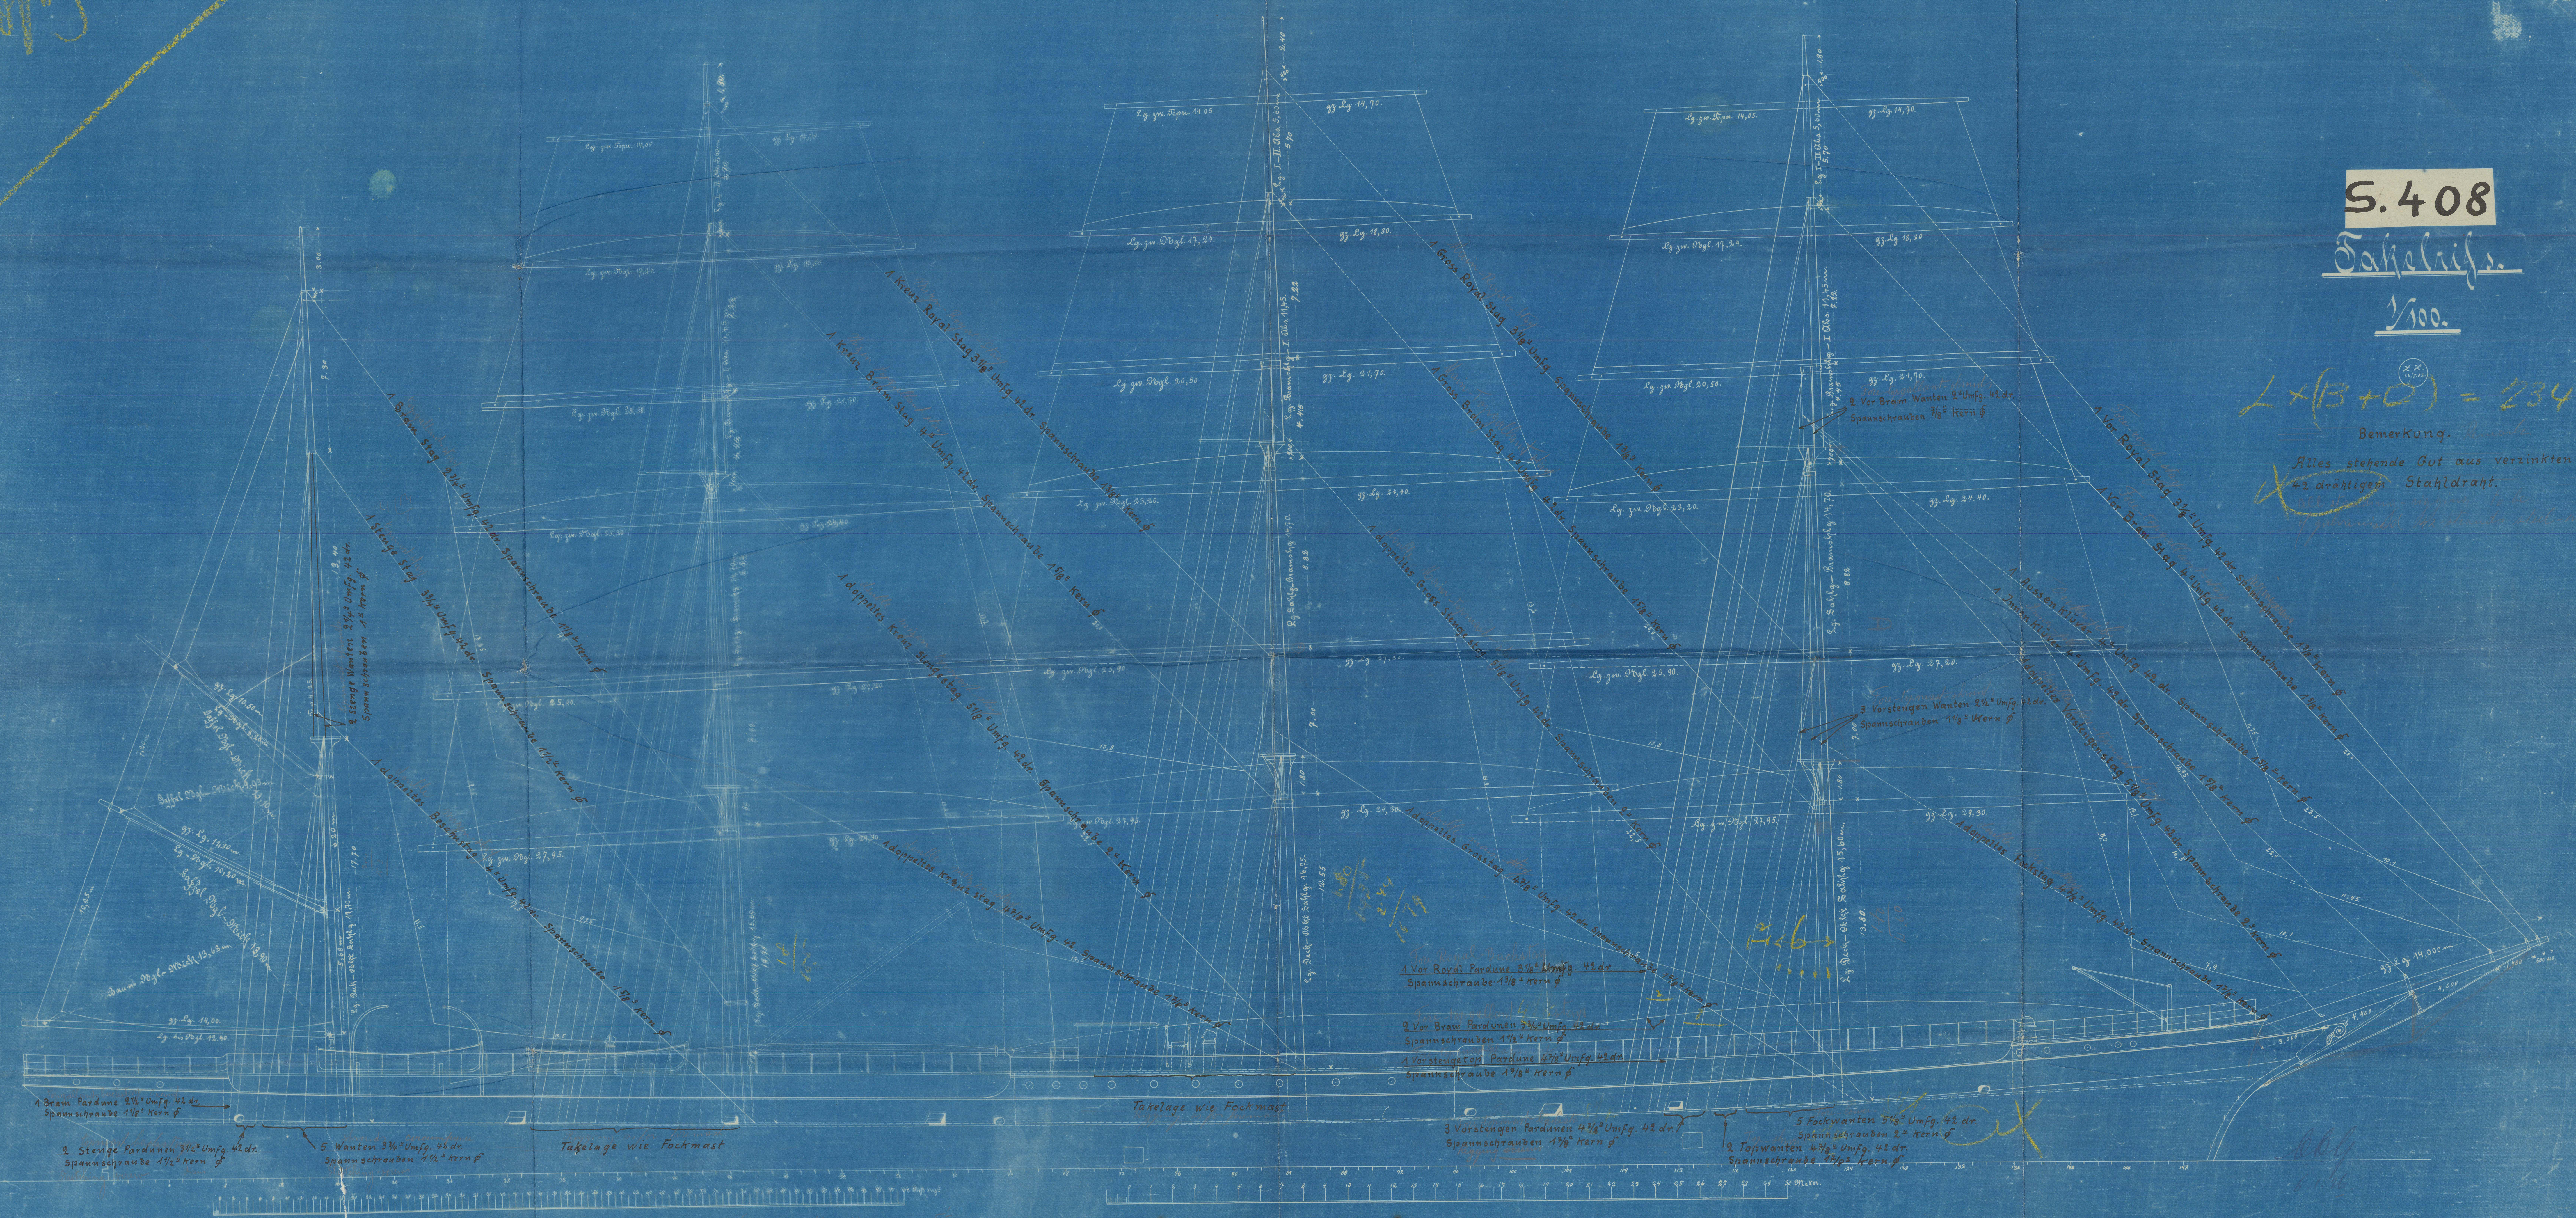

GEN. BOX NO 774

Rigging plan.

S. Padua R/F

RETAIN



© 2021

Lloyd's Register
Foundation

W1355-0198

