

# Lloyd's Register of Shipping.

## SURVEYS FOR FREEBOARD.

RETURN

Computation of Freeboard for Steamer, ~~Sailing Ship, Tanker~~  
 having Complete Superstructure & tonnage opening

Port of Survey \_\_\_\_\_

Date of Survey 13.4.37

Name of Surveyor \_\_\_\_\_

Particulars of Classification 100A1 (shelter deck with freeboard)

(Type of Superstructures.) \_\_\_\_\_

Ship's Name <u>Borbeck</u> <u>ex Derwindmoen</u>	Nationality and Port of Registry <u>German</u> <u>Bremer</u>	Official Number _____	Gross Tonnage _____	Date of Build _____
--	--	-----------------------	---------------------	---------------------

Moulded Dimensions: Length 419.33 Breadth 56.00 Depth 30.5

Moulded displacement at moulded draught = 85 per cent. of moulded depth \_\_\_\_\_ tons

Coefficient of fineness for use with Tables .80 assumed

Depth for Freeboard (D)	Depth correction	Round of Beam correction
Moulded depth ... .. <u>30.50</u>	(a) Where D is greater than Table depth (D - Table depth) R = $(30.54 - 27.95) \times 3 = + 7.77$	Moulded Breadth (B) <u>56.0"</u>
Stringer plate ... .. <u>.04</u>	(b) Where D is less than Table depth (if allowed) (Table depth - D) R =	Standard Round of Beam = $\frac{B \times 12}{50} = 13.44$
Sheathing on exposed deck $T \left( \frac{L-S}{L} \right) =$	If restricted by superstructures	Ship's Round of Beam = <u>12"</u>
Depth for Freeboard (D) = <u>30.54</u>		Difference = <u>1.44 deficient</u>
		Restricted to
		Correction = $\frac{\text{Diff}}{4} \times \left( 1 - \frac{S_1}{L} \right) = \frac{1.44}{4} \times 0.067 = \text{Nil}$

### DEDUCTION FOR SUPERSTRUCTURES.

Mean Covered Length (S)	Equivalent Enclosed Length (S <sub>1</sub> )	Height	Height Correction	Effective Length (E)	Standard Height of Superstructure
Poop enclosed ... .. <u>21.50</u>	<u>21.50</u>	<u>8'-0"</u>		<u>21.50</u>	<u>7.5'</u>
" overhang ... ..					" R.Q.D.
R.Q.D. enclosed ... ..					Deduction for complete superstructure <u>42.00"</u>
" overhang ... ..					Percentage covered $\frac{S}{L} = 100$
Bridge enclosed <u>EQUIV.</u> ... ..					" $\frac{S_1}{L} = 99.33$
" overhang aft ... ..	<u>388.81</u>	<u>8'-0"</u>		<u>388.81</u>	" $\frac{E}{L} = 99.33$
" overhang forward ... ..					Percentage from Table, Line A.
F'cle enclosed ... ..					(corrected for absence of forecastle (if required)) <u>99.18</u>
" overhang ... ..	<u>4.69</u>	<u>3.52</u>		<u>3.52</u>	Percentage from Table, Line B.
Trunk aft ... ..					(corrected for absence of forecastle (if required))
" forward ... ..					Interpolation for bridge less than 2L (if required)
Tonnage opening aft ... ..	<u>4.33</u>	<u>2.75 = 1/2 diff</u>		<u>2.75</u>	Deduction = <u>42 x .9918 = 41.65</u>
" " forward ... ..					
Total ... ..	<u>419.33</u>	<u>416.58</u>		<u>416.58</u>	

### SHEER CORRECTION.

Station	Standard Ordinate	S	Product	Actual Ordinate	Effective Ordinate	S	Product	Mean actual shear aft = Excess
A.P. ... ..	<u>51.93</u>	1	<u>51.93</u>	<u>52.60</u>	<u>58.00</u>	1	<u>58.00</u>	Mean actual shear forward = Excess
1/8 L from A.P. ... ..	<u>23.11</u>	4	<u>92.44</u>	<u>22.91</u>	<u>25.81</u>	4	<u>103.24</u>	Mean standard shear aft
2/8 L " ... ..	<u>5.71</u>	2	<u>11.42</u>	<u>5.71</u>	<u>6.38</u>	2	<u>12.76</u>	Mean standard shear forward
Amidships ... ..		4				4		Length of enclosed superstructure forward of amidships = } C.S.S.
2/8 L from F.P. ... ..	<u>11.43</u>	2	<u>22.86</u>	<u>13.20</u>	<u>15.40</u>	2	<u>30.80</u>	" " aft of " = }
1/8 L " ... ..	<u>46.22</u>	4	<u>184.88</u>	<u>52.93</u>	<u>62.30</u>	4	<u>249.20</u>	
F.P. ... ..	<u>103.87</u>	1	<u>103.87</u>	<u>134.00</u>	<u>140.00</u>	1	<u>140.00</u>	
Total ... ..			<u>467.40</u>	<u>467.40</u>	<u>594.00</u>		<u>594.00</u>	

Correction =  $\frac{\text{Difference between sums of products}}{18} \left( .75 - \frac{S}{2L} \right) = \frac{126.60}{18} \times .25 = -1.76$

If limited on account of midship superstructure. If limited to maximum allowance of 1 1/2 ins. per 100 ft.

Deduction for Tropical Freeboard.	Deduction for Fresh Water.	TABULAR FREEBOARD corrected for Flush Deck (if required)	77.59
Addition for Winter and Winter North Atlantic Freeboard.	Displacement in salt water at summer load water line	Correction for coefficient $\frac{.80 + .68}{1.36} = \frac{1.480}{1.36}$	84.43
Depth to Freeboard Deck = _____ Ft.	Δ = _____	Depth Correction ... ..	7.77
Summer freeboard = _____	Tons per inch immersion at summer load water line	Deduction for superstructures ... ..	- 41.65
Moulded draught (d) = _____	T = _____	Sheer correction ... ..	- 1.76
Deduction for Tropical freeboard and addition for Winter freeboard = $\frac{d}{4}$ inches = _____	Deduction = $\frac{\Delta}{40T}$ inches = _____	Round of Beam correction ... ..	- -
Addition for Winter North Atlantic Freeboard (if required) = _____		Correction for Thickness of Deck amidships ... ..	- -
		Other corrections, scantlings, etc. ... ..	- -
		7.77 43.41	- 35.64
		Summer Freeboard = <u>48.79</u>	

SUMMER FREEBOARD amidships from Centre of Disc to top of Deck Line, ~~Wood, Steel, Deck~~ —

Tropical Fresh Water Line above Centre of Disc ... ..	Tropical Fresh Water Freeboard ... ..
Fresh Water Line " " ... ..	Fresh Water " " ... ..
Tropical Line " " ... ..	Tropical " " ... ..
Winter Line below " " ... ..	Winter " " ... ..
Winter North Atlantic Line " " ... ..	Winter North Atlantic " " ... ..

4'-0 3/4" 4'-0 7/8" as assigned by G.L.S. Register  
see Ann. Rpt. 22255  
Date 16.8.37

PARTICULARS OF PROTECTION TO OPENINGS, ETC.

HATCHWAYS ON FREEBOARD AND SUPERSTRUCTURE DECKS.									
Description of Hatchway	...	...	...	...	...	...	...	...	...
Dimensions of Hatchway	...	...	...	...	...	...	...	...	...
COAMINGS	}	Height above Deck	...	...	...	...	...	...	...
		Thickness	...	...	...	...	...	...	...
		Sides	...	...	...	...	...	...	...
		Ends	...	...	...	...	...	...	...
		Stiffeners	...	...	...	...	...	...	
		Brackets, Stays	...	...	...	...	...	...	
HATCH BEAMS	}	Number	...	...	...	...	...	...	...
		Spacing	...	...	...	...	...	...	...
		Scantling and Sketch	...	...	...	...	...	...	...
		Bearing Surface	...	...	...	...	...	...	...
FORE AND AFTERS	}	Number	...	...	...	...	...	...	...
		Spacing	...	...	...	...	...	...	...
		Unsupported Lengths	...	...	...	...	...	...	...
		Scantling* and Sketch	...	...	...	...	...	...	...
		Bearing Surface	...	...	...	...	...	...	
HATCH COVERS	}	Material	...	...	...	...	...	...	...
		Thickness	...	...	...	...	...	...	...
		How fitted	...	...	...	...	...	...	...
		Bearing Surface	...	...	...	...	...	...	...
Spacing of Cleats	...	...	...	...	...	...	...	...	
Number of Tarpaulins	...	...	...	...	...	...	...	...	

Particulars of fiddle, funnel and ventilator coamings :—

Particulars of Flush Bunker Scuttles :—

Particulars of Companionways :—

Particulars of Ventilators in exposed positions on freeboard and superstructure decks :—

Particulars of Air Pipes in exposed positions on freeboard, raised quarter, or superstructure decks :—

Particulars of Gangway Cargo and Coaling Ports :—

Particulars of Scuppers and Sanitary Discharge Pipes :—

Particulars of Side Scuttles :—

Particulars of Guard Rails :—

Particulars of Gangways, Lifelines, etc. :—


Particulars of Freeing Arrangements.						
	Length of Bulwark	Height of Bulwark	Size of Freeing Ports	Number each side	Area each side	Rule area each side
After Well	...	...	...	...	...	...
Forward Well	...	...	...	...	...	...

State position of each freeing port ... } After Well :—  
(F. and A. position and height above deck edge) } Forward Well :—  
State whether the freeing ports are fitted with shutters, bars, or rails, and give particulars of such :—  
Additional area where sheer is less than standard.

Particulars of Superstructures, Trunks, Casings, Deckhouses.								
	Coaming	Plating	Stiffeners	Spacing	End Attachments of Stiffeners	Size of Openings	Height of Sills	Height of Casings
Poop Bulkhead	...	...	...	...	...	...	...	...
Raised Quarter Deck Bulkhead	...	...	...	...	...	...	...	...
Bridge, After Bulkhead	...	...	...	...	...	...	...	...
Bridge, Forward Bulkhead	...	...	...	...	...	...	...	...
Forecastle Bulkhead	...	...	...	...	...	...	...	...
Trunk, Aft	...	...	...	...	...	...	...	...
Trunk, Forward	...	...	...	...	...	...	...	...
Exposed Machinery Casings on Freeboard or Raised Quarter Decks	...	...	...	...	...	...	...	...
Exposed Machinery Casings on Superstructure Decks	...	...	...	...	...	...	...	...
Machinery Casings within Superstructures not fitted with Class I Closing Appliances	...	...	...	...	...	...	...	...
Deckhouses on Flush Deck Ships	...	...	...	...	...	...	...	...

Particulars of Closing Appliances (state if capable of being manipulated from both sides).								
Poop Bulkhead	...	...	...	...	...	...	...	...
Raised Quarter Deck Bulkhead	...	...	...	...	...	...	...	...
Bridge, After Bulkhead	...	...	...	...	...	...	...	...
Bridge, Forward Bulkhead	...	...	...	...	...	...	...	...
Forecastle Bulkhead	...	...	...	...	...	...	...	...
Exposed Machinery Casings on Freeboard or Raised Quarter Decks	...	...	...	...	...	...	...	...
Exposed Machinery Casings on Superstructure Decks	...	...	...	...	...	...	...	...
Machinery Casings within Superstructures not fitted with Class I Closing Appliances	...	...	...	...	...	...	...	...
Deckhouses on Flush Deck Ships	...	...	...	...	...	...	...	...

Superstructure bulkheads, trunks, deckhouses, casings, cargo and coaling hatchways, extent and thickness of sheathing on the freeboard deck, gangway, cargo and coaling ports, and any other openings, etc., which would affect the seaworthiness of the ship are to be shewn on the following sketches:—

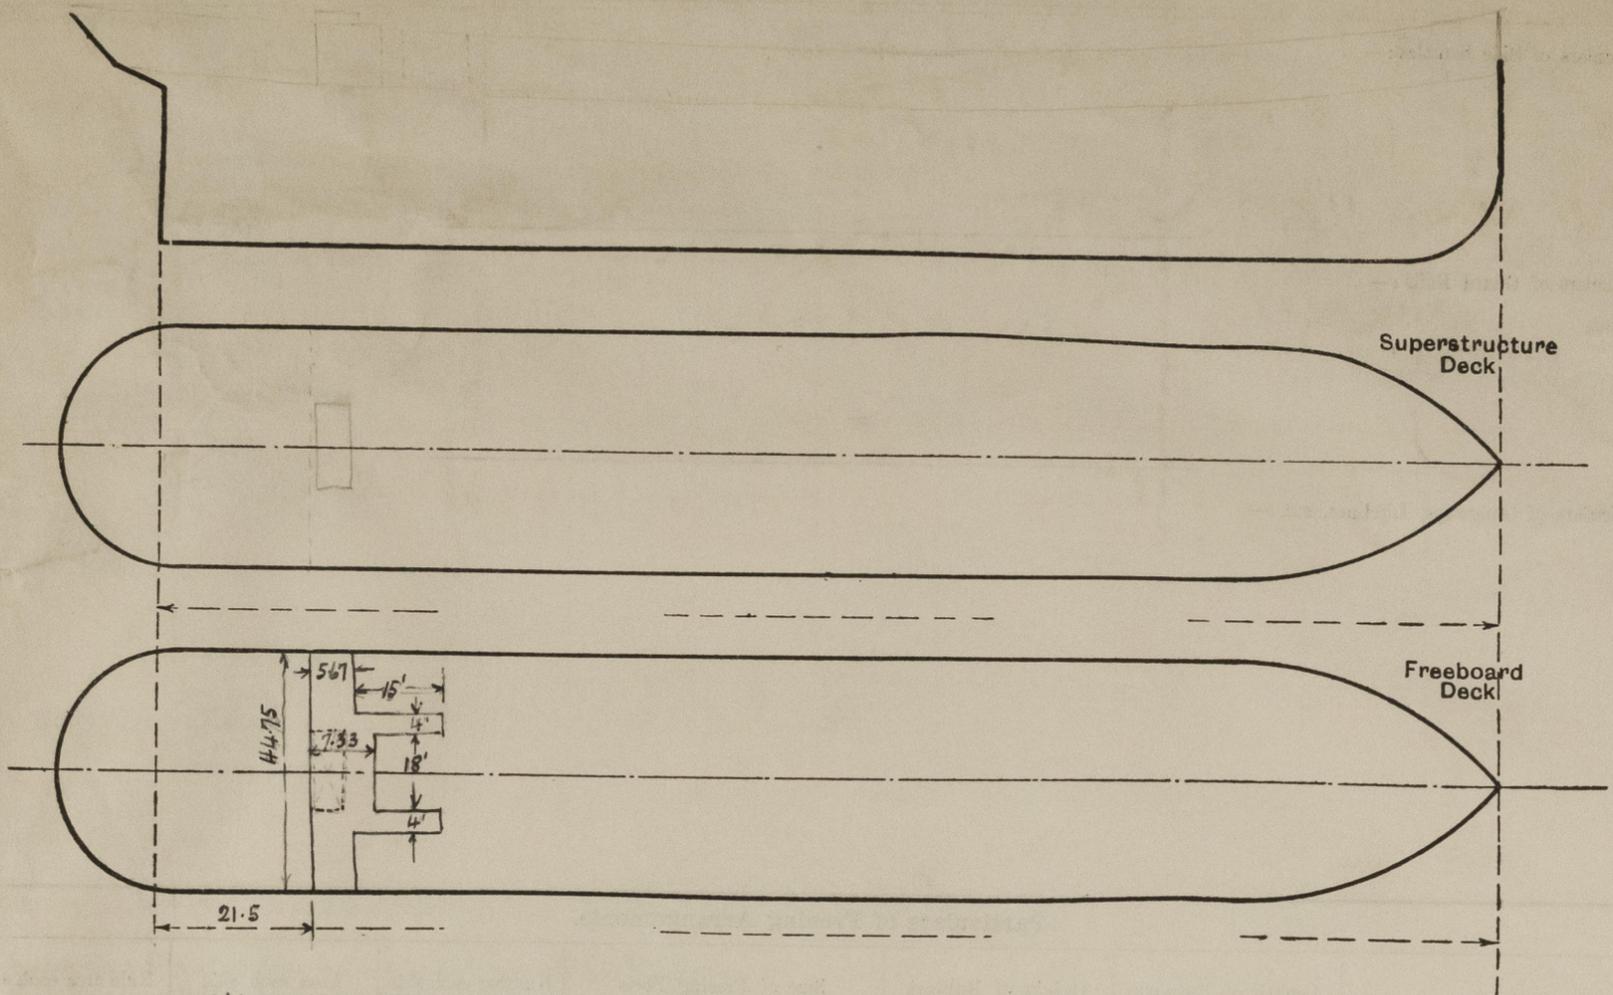

$$\begin{array}{r}
 1.66 \times 18 = 29.88 \\
 8.0 \times 15 = 120.00 \\
 \hline
 149.88 \\
 44.75 \quad = 3.35
 \end{array}$$

State any special features in the construction of the ship:—

419.33	5.67
27.17	21.50
392.16	27.17
3.35	
388.81	3.35
	1.66
	5.01

21.5	
4.33	
25.83	388.81
27.17	4.09 OH
1.84	4.33
3.35	21.5
4.69	419.33

Builder's name and yard number \_\_\_\_\_

Names of sister ships \_\_\_\_\_

Owners \_\_\_\_\_

Fee £ \_\_\_\_\_ Received by me \_\_\_\_\_