

30-9-15

Plan 130 = Shinsen frame
131 = Shinsen frame
132 = Shinsen frame
133 = Shinsen frame

No 130-131 S.S. CARGO STEAMERS MIDSHIP SECTION

SCALE 1/2 IN TO 1 FT

1140 approx 11.8.16
1141 " 2.11.17
1142 " 2.11.17



- EQUIPMENTS
- 3 BOWER ANCHORS STOCKLESS TYPE EACH
 - 1 STREAM ANCHOR EX STOCK
 - 1 KEDGE ANCHOR EX STOCK
 - 270 FATHOMS STUD CHAIN CABLE 2 1/2 DIA
 - 90 STEEL WIRE
 - 12.0 HAWSER & WARP
 - 36.0


Plan 130 = Shinsen frame
131 = Shinsen frame
132 = Shinsen frame
133 = Shinsen frame

PRINCIPAL DIMENSIONS



LENGTH B P	360-0
BREADTH MLD	51-0
DEPTH MLD	28-3
CLASS	100A1

SCANTLING NUMBERS




O	28.45
B	41.50
L	79.46
T NO	360.00
L NO	28602.00

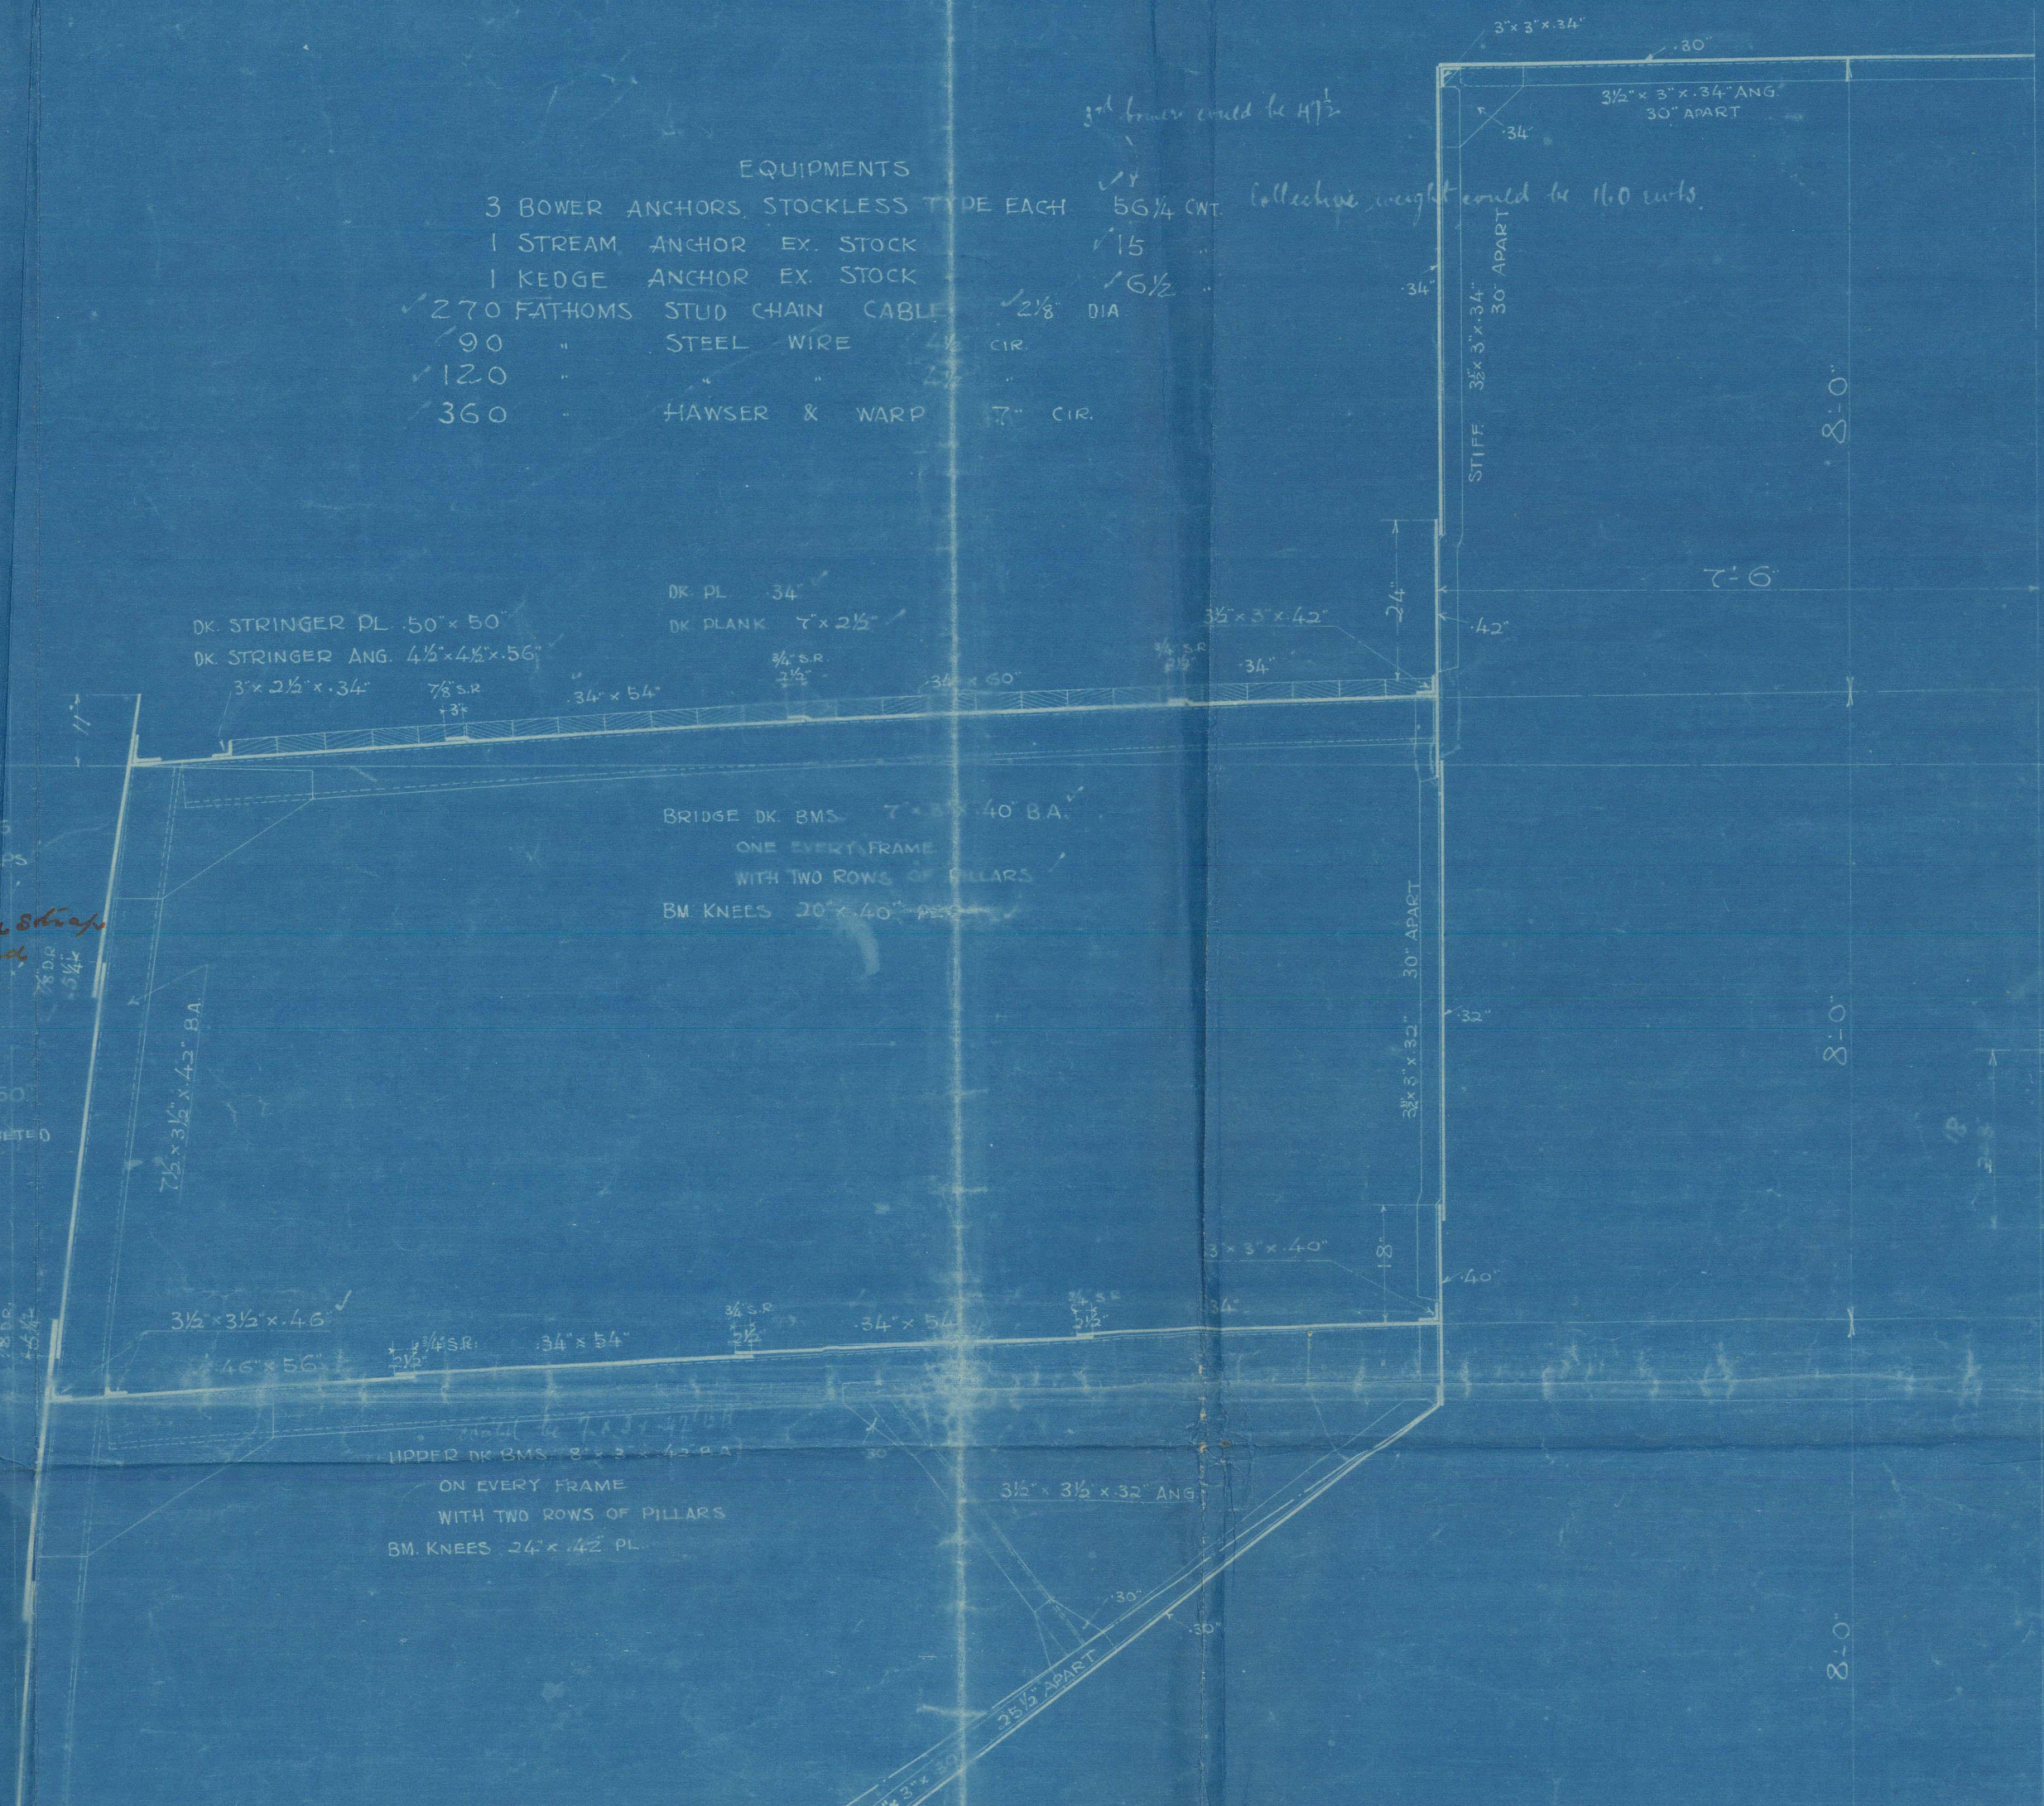

SECTION AT BOILER ROOM

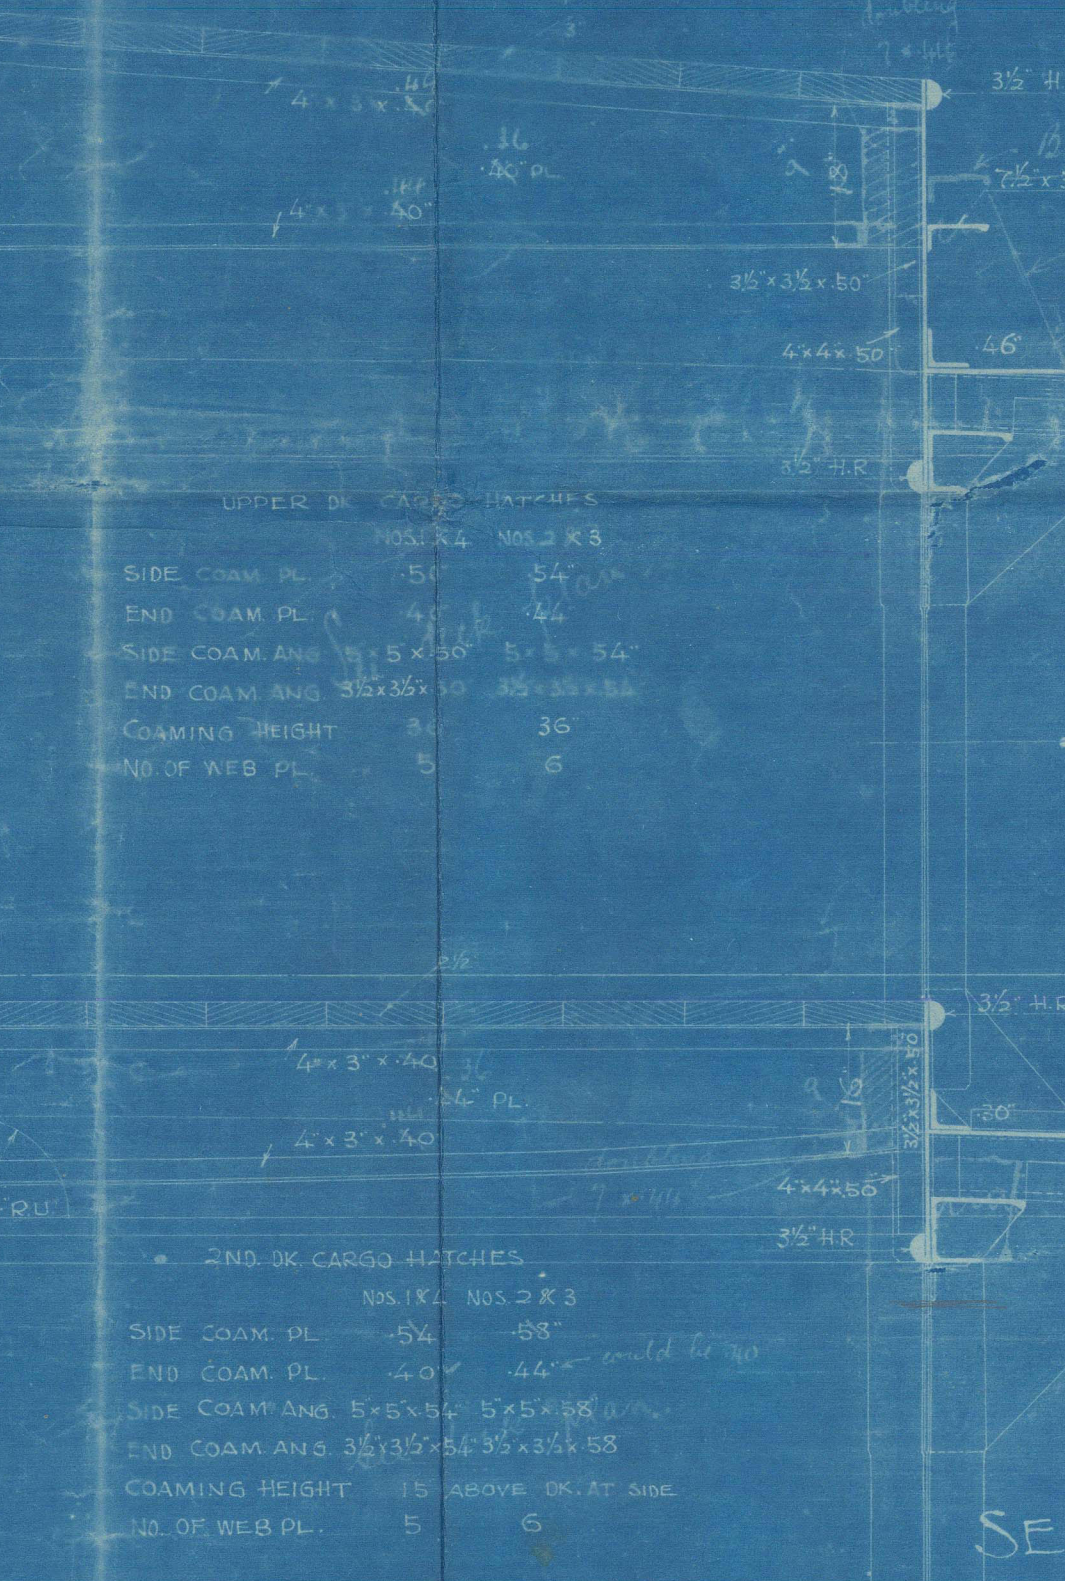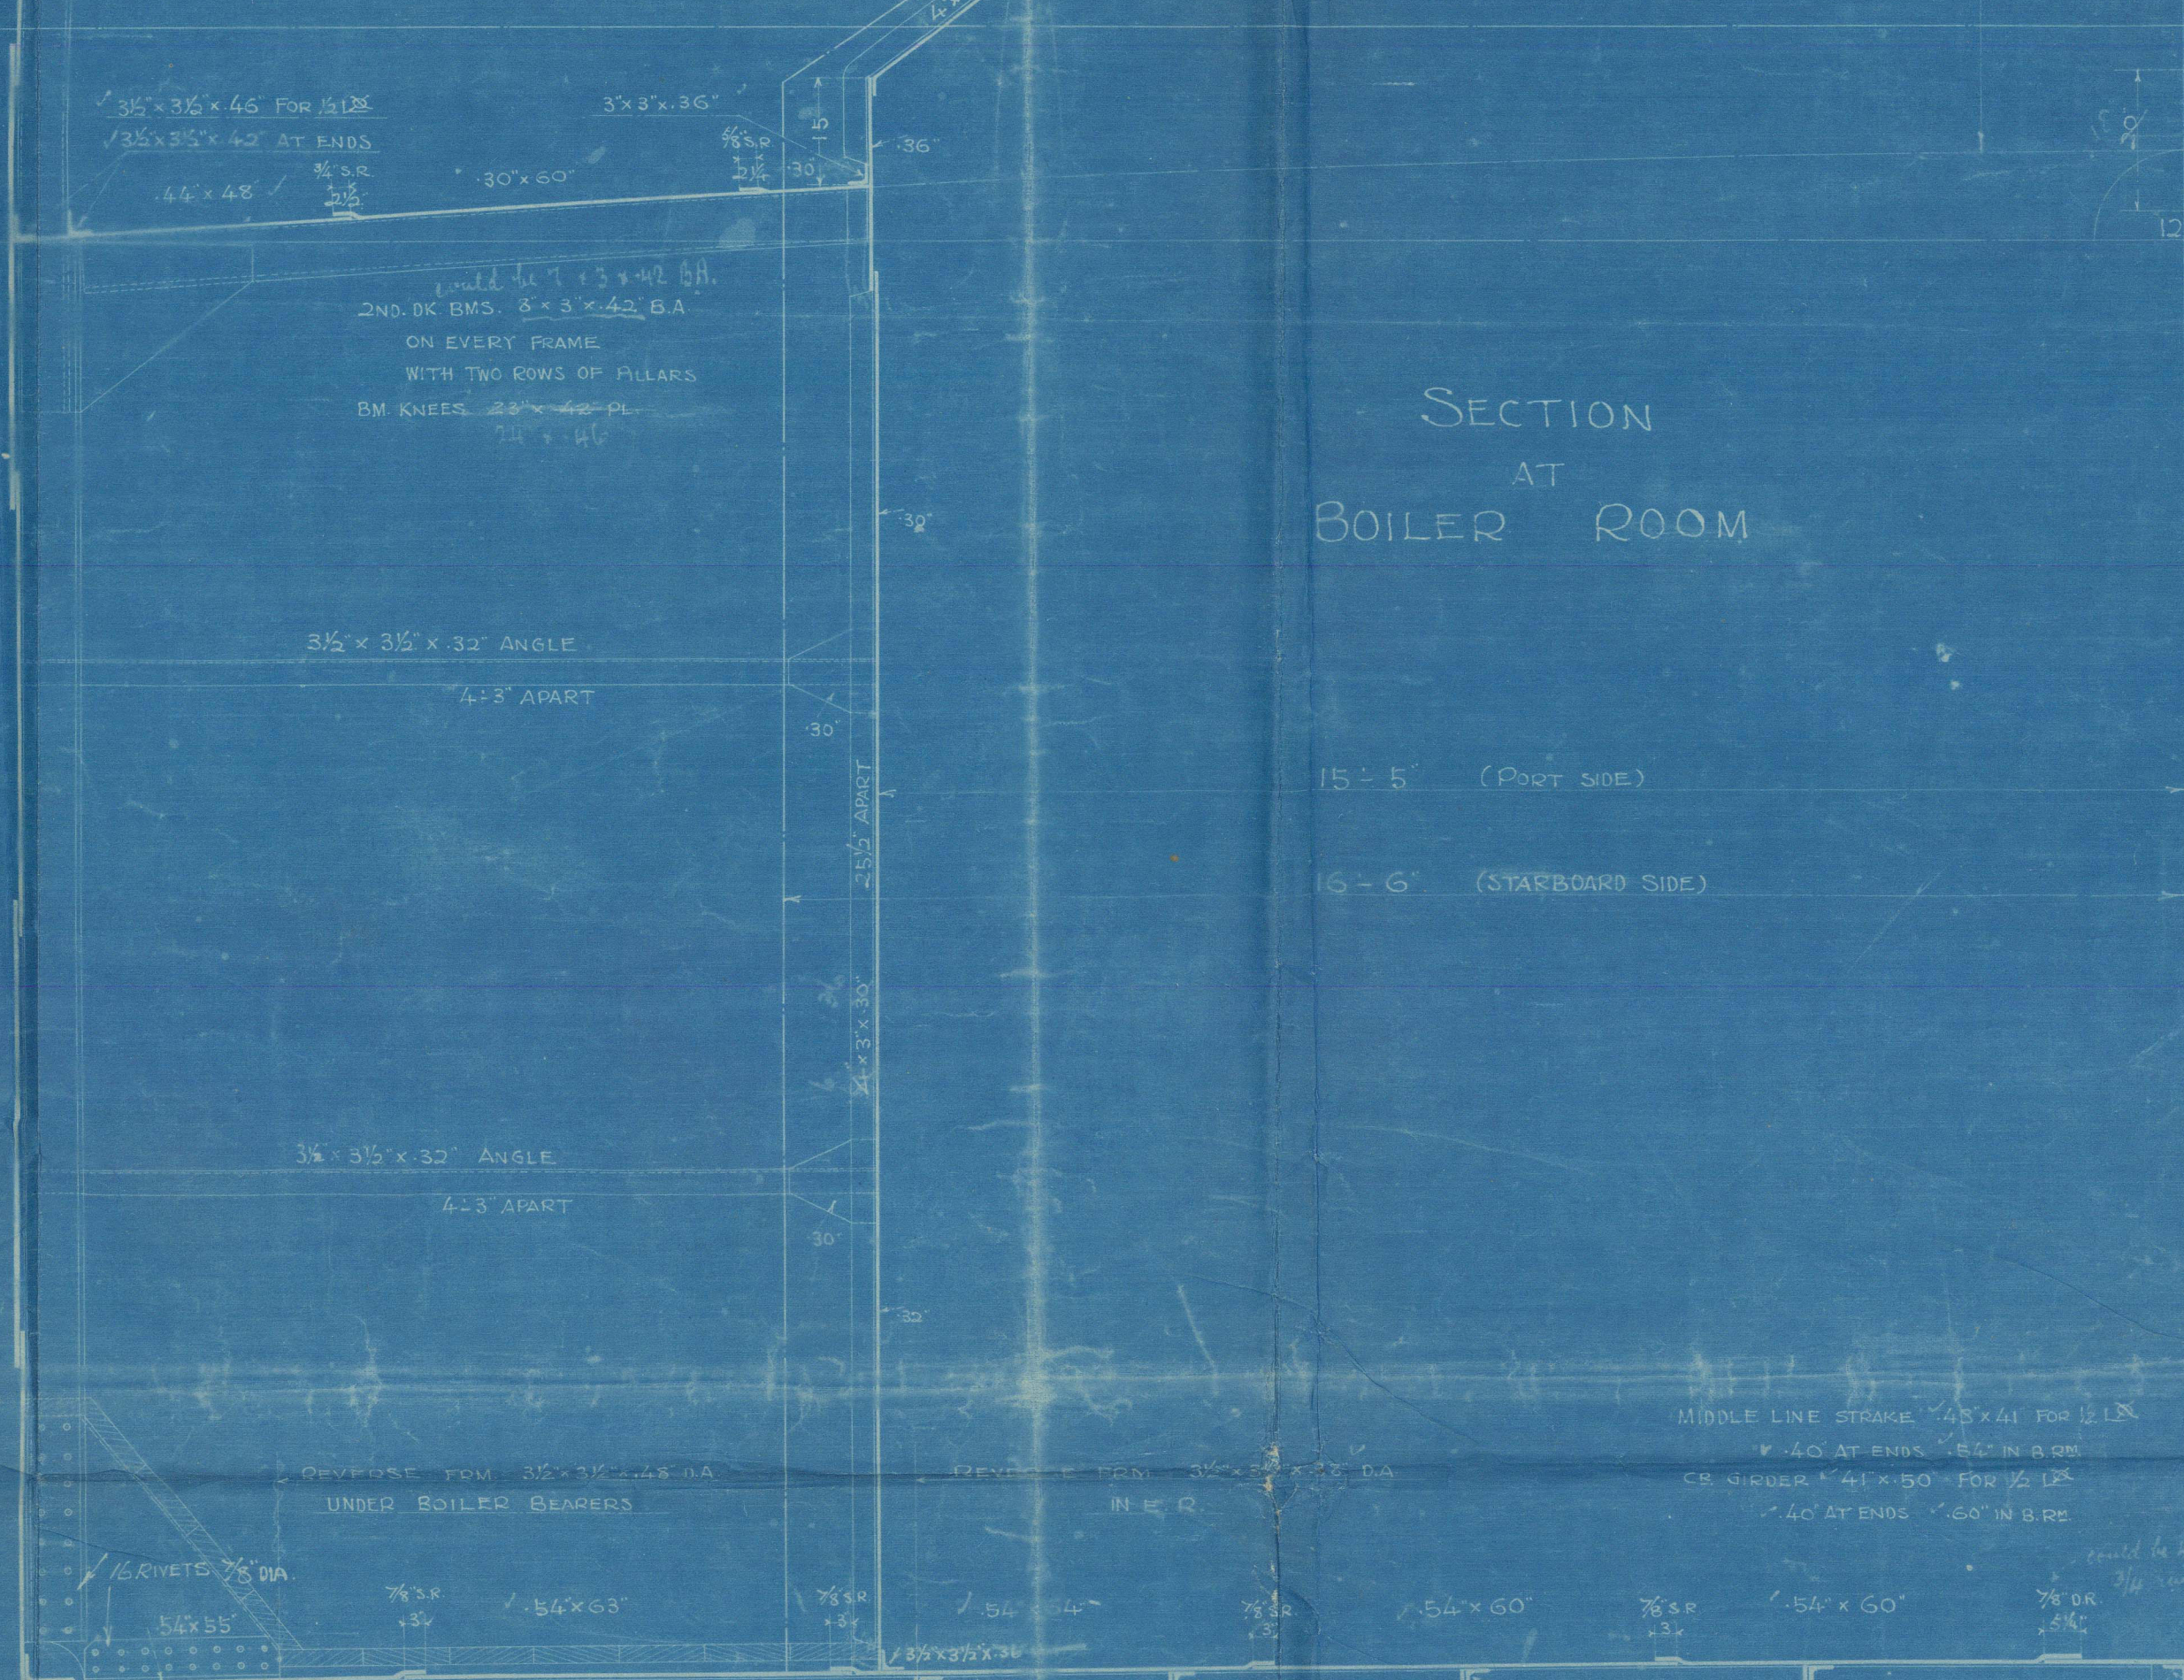

SECTION AT HOLD

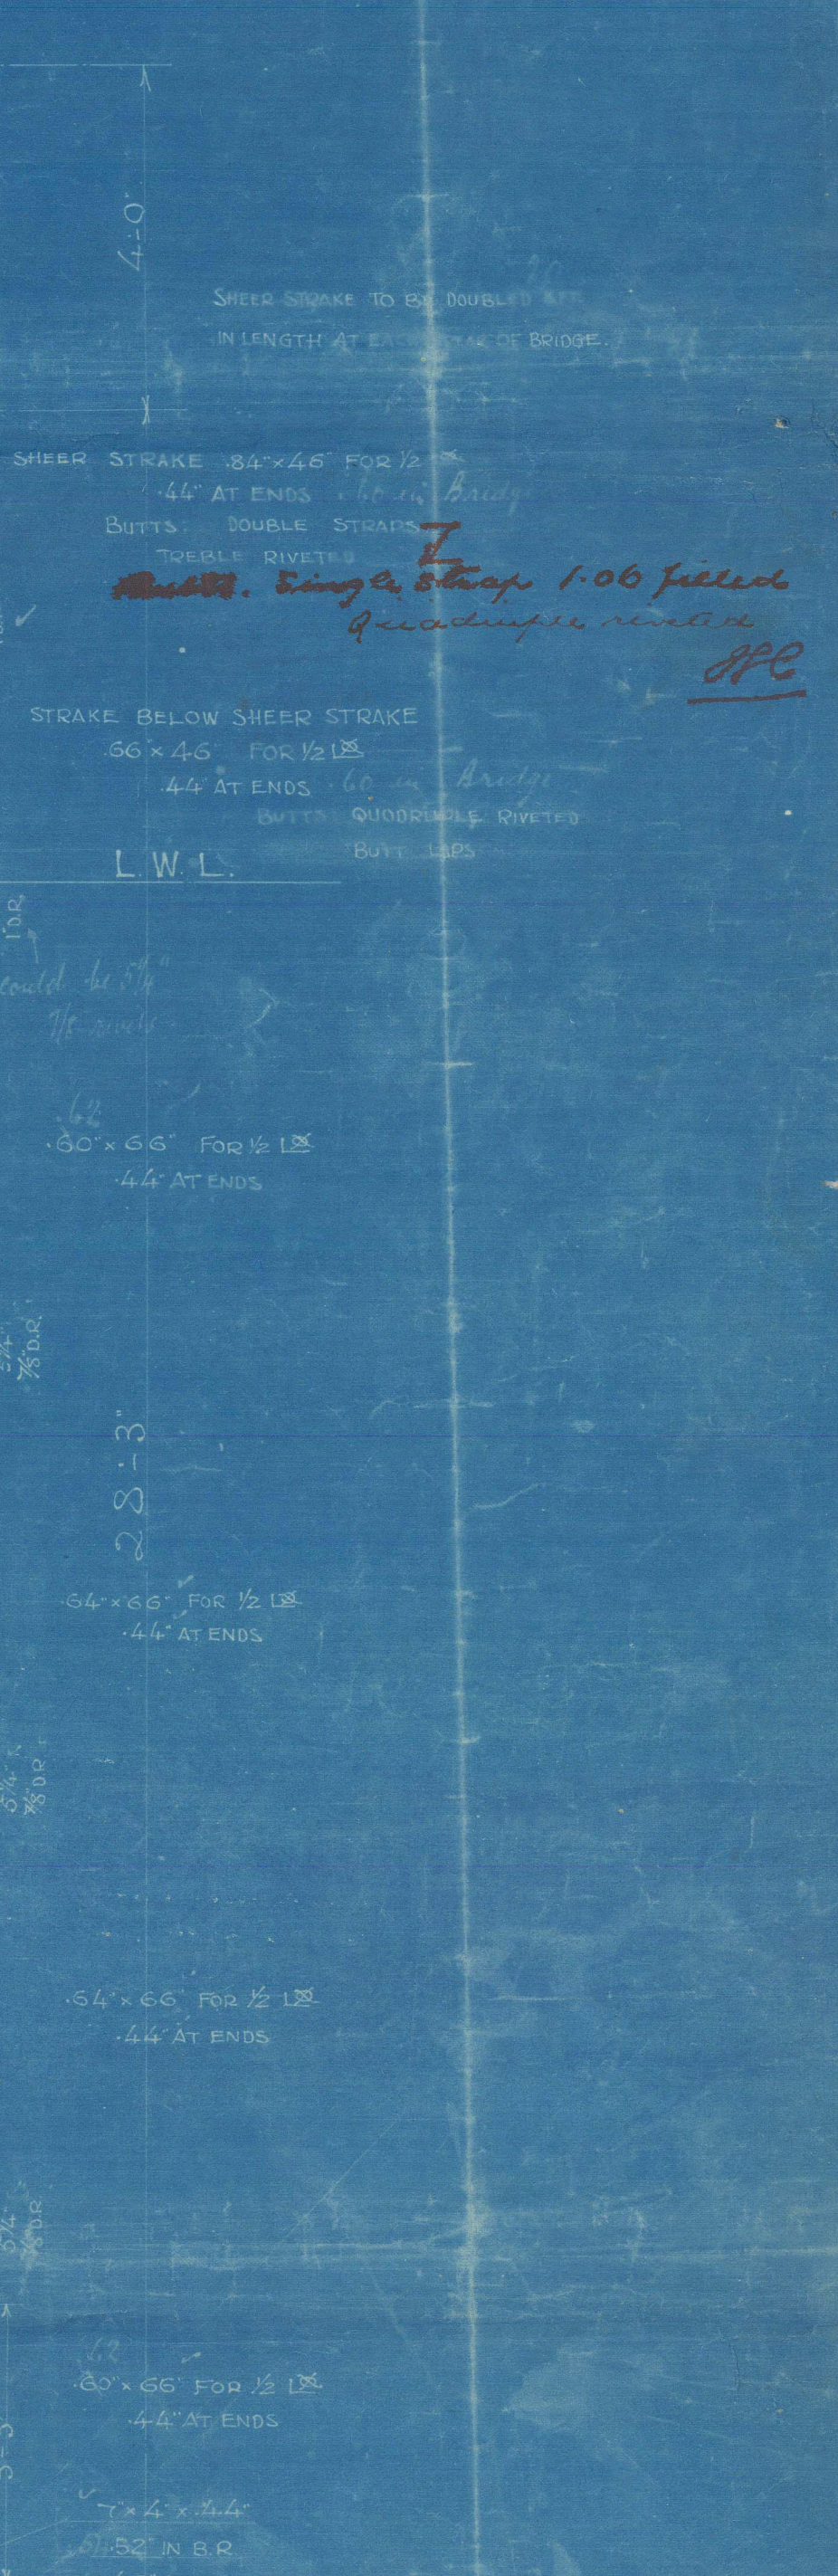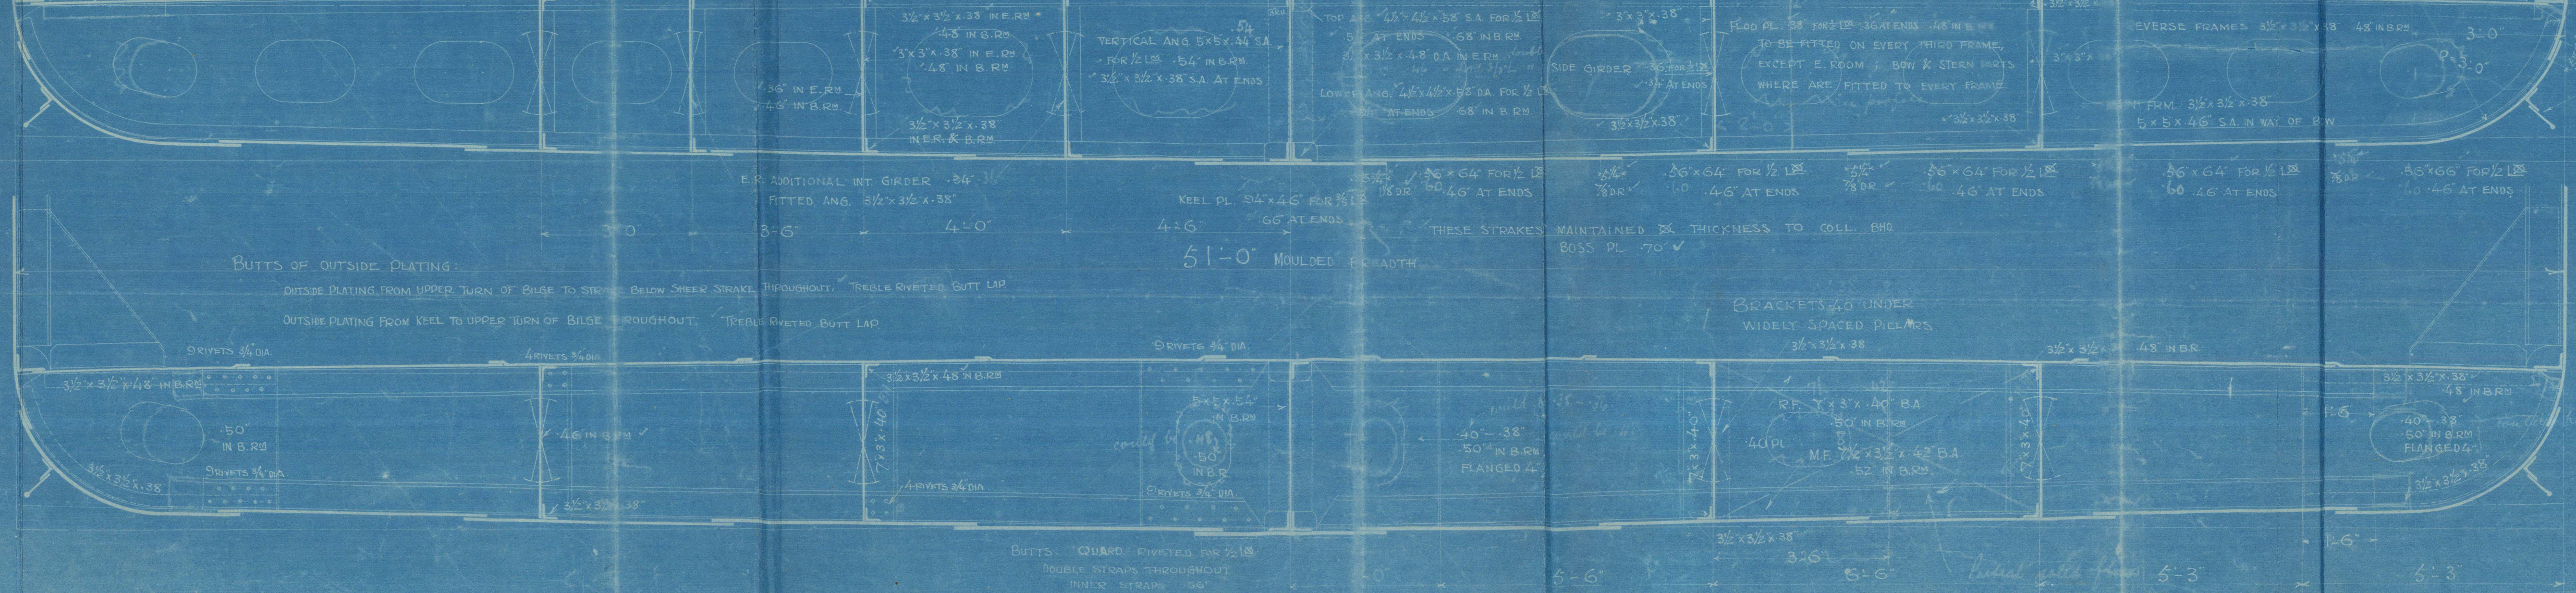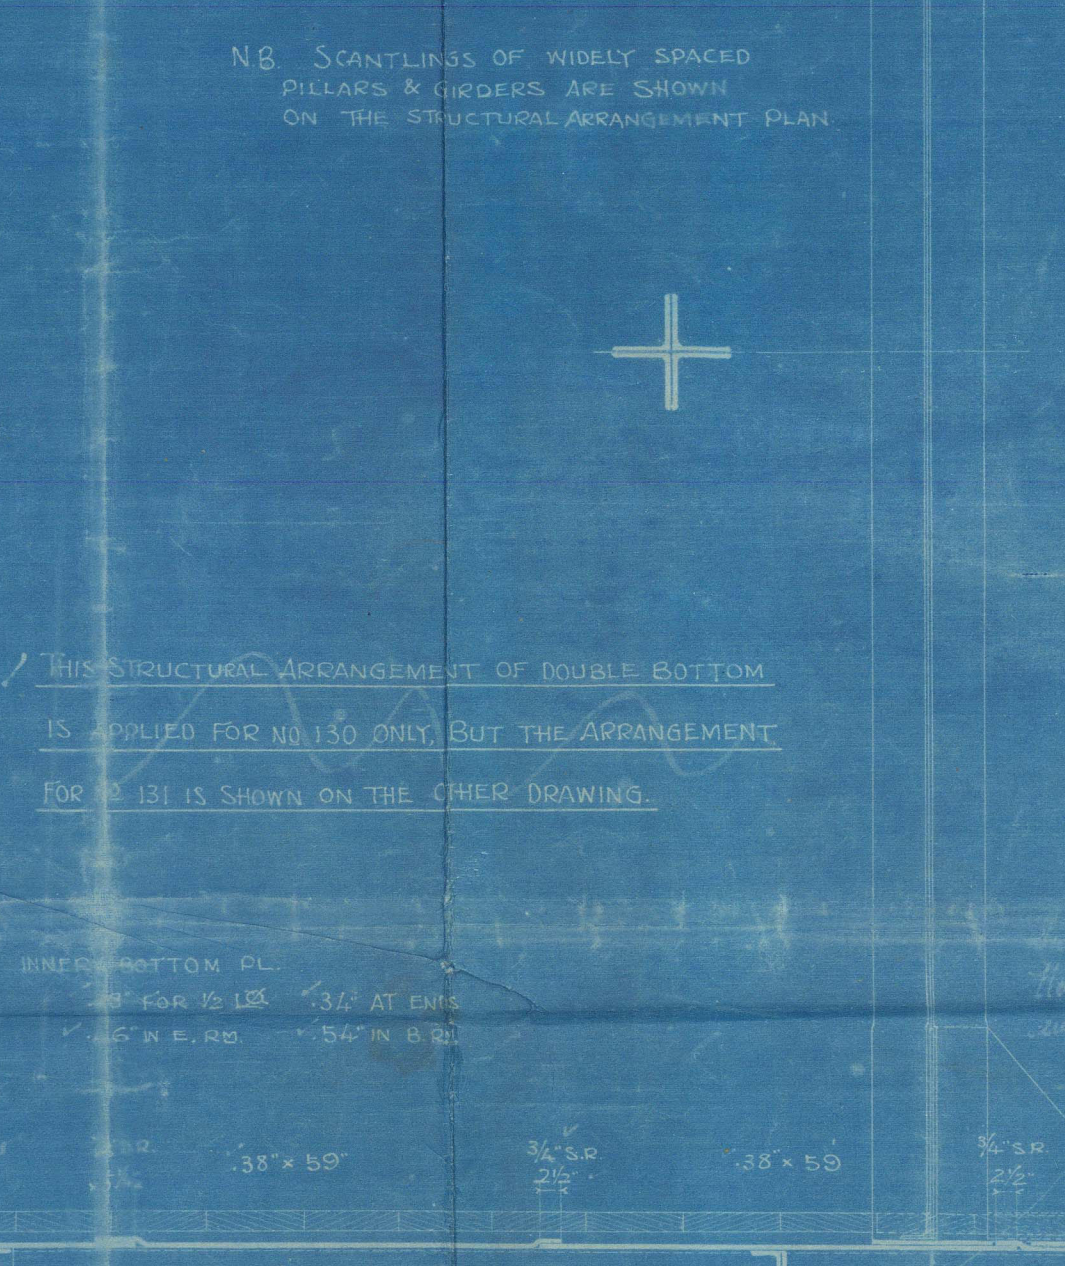

Mud. Section .

S. Shonsei Maru.
Yok. 2251.

Uraga Dock Co. 130-1.

RETAIN




© 2020

Lloyd's Register
Foundation



© 2020

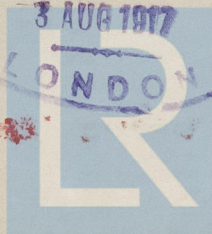

Lloyd's Register
Foundation

W1358-0102