


268. (ALTERATION-IN-BLACK)  
**No 252-3.**  
**PROFILE & DECK PLANS.**  
 SCALE 1/8 INCH TO ONE FOOT.

14.5.15

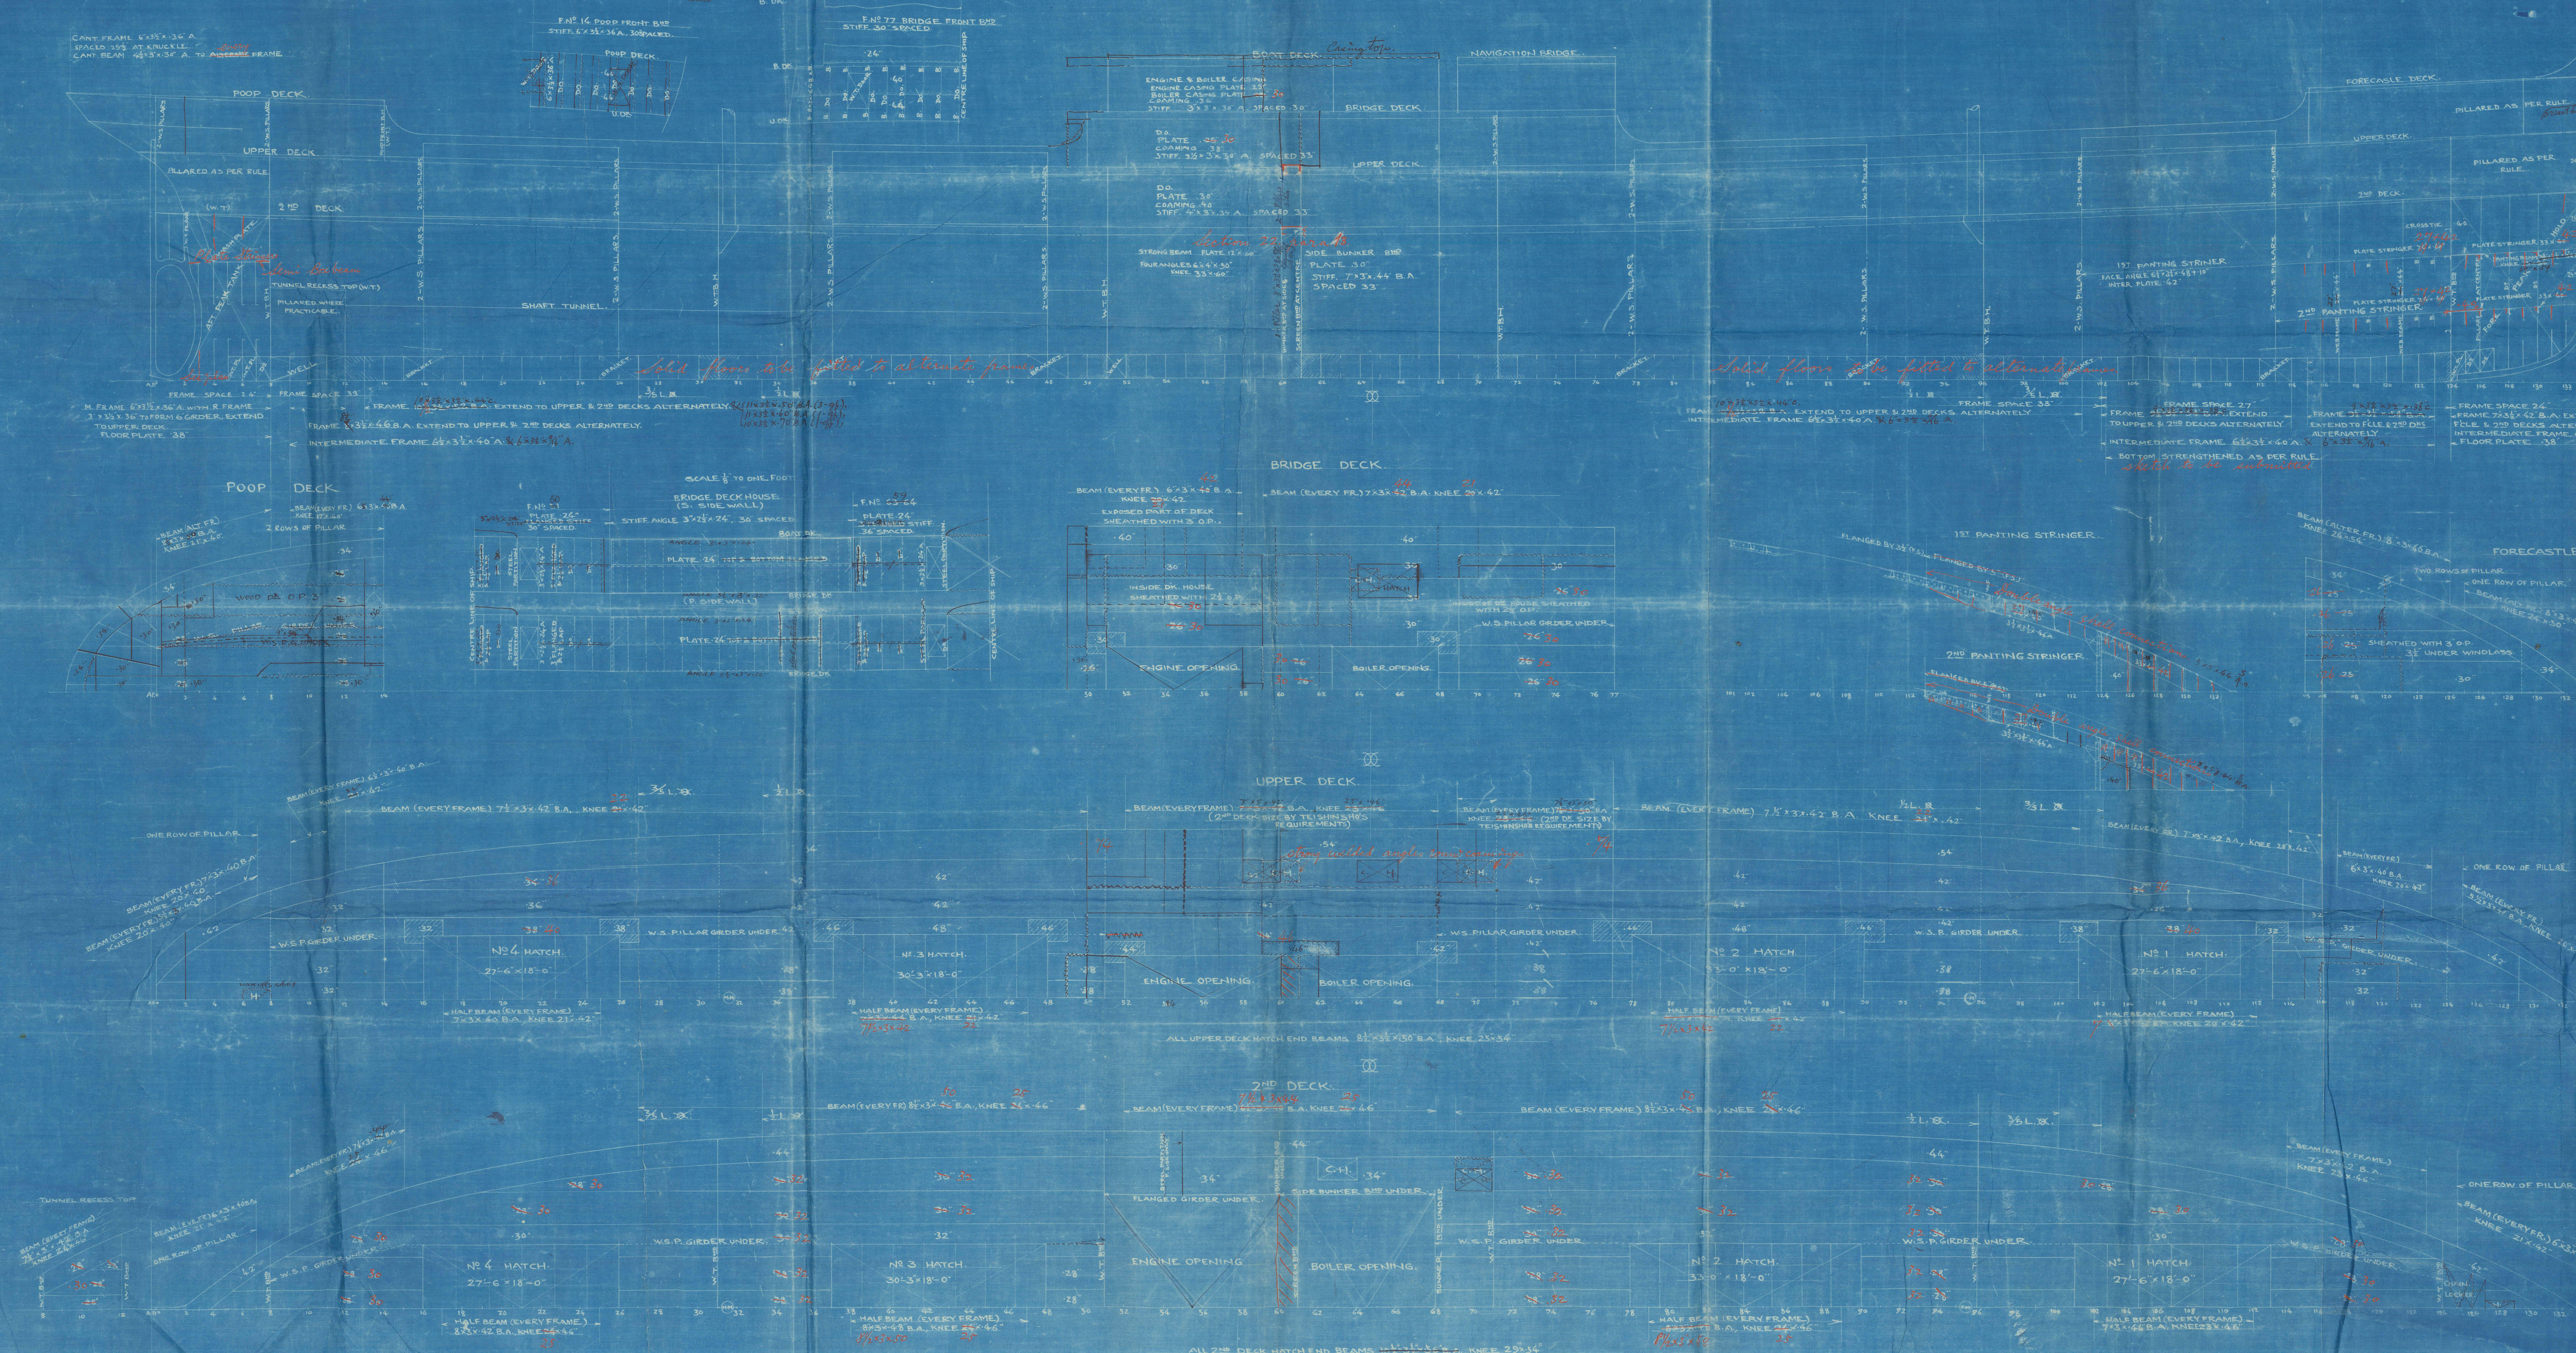

**GIRDERS AT HEADS OF WIDE SPACED PILLARS**

FRAME	S	B	H	SPACING	OF BEAM	OF PILLAR	REMARKS
10-8	16.00	12.22	5	156.4	8	12	34 8x31x30BA
8-14	16.50	14.00	5	130.6	6	12	34 8x31x30BA
68-71	18.24	15.33	5	131.2	7	12	34 51x2x35BA
71-77	16.30	15.33	5	208.7	7	12	34 8x31x30BA
8-16	22.00	12.80	8.75	529.4	7	15	44 11x31x60BA
16-26	22.50	13.25	8	226.9	7	15	44 11x31x60BA
26-31	13.75	15.05	5	146.1	7	15	44 6x31x38BA
31-37	16.50	15.72	5	214.0	7	15	44 6x31x38BA
37-48	30.75	15.80	5	364.9	7	15	44 6x31x38BA
48-51	8.25	16.49	5	56.0	7	15	44 6x31x38BA
68-71	8.25	16.49	7.75	84.4	7	15	44 6x31x38BA
71-78	19.25	16.00	7.50	439.4	7	15	44 6x31x38BA
78-90	35.00	7.97	5	434.0	7	15	44 6x31x38BA
90-96	16.50	15.61	5	219.5	7	15	44 6x31x38BA
96-101	13.75	15.11	5	142.8	7	15	44 6x31x38BA
101-113	22.50	15.20	5	268.5	7	15	44 6x31x38BA
113-124	26.75	10.39	9.00	578.5	7	15	44 6x31x38BA
8-16	22.00	9.45	8.5	387.8	7	15	44 6x31x38BA
16-26	22.50	9.87	8.5	391.6	8	15	44 6x31x38BA
26-31	13.75	15.60	8.5	247.96	8	15	44 6x31x38BA
31-37	16.50	16.22	8.5	373.6	8	15	44 6x31x38BA
37-48	30.75	16.61	8.5	621.9	8	15	44 6x31x38BA
48-51	8.25	16.67	8.5	96.4	8	15	44 6x31x38BA
51-60	24.75	16.85	8.5	424.4	8	15	44 6x31x38BA
60-71	8.25	16.67	8.5	96.4	8	15	44 6x31x38BA
71-78	19.25	16.67	8.5	525.1	8	15	44 6x31x38BA
78-90	35.00	16.61	8.5	1537.5	8	15	44 6x31x38BA
90-96	16.50	16.10	8.5	372.6	8	15	44 6x31x38BA
96-101	13.75	15.39	8.5	267.3	8	15	44 6x31x38BA
101-113	22.50	13.55	8.5	671.1	7	15	44 6x31x38BA
113-124	26.75	9.33	8.5	485.8	7	15	44 6x31x38BA

**WIDE SPACED PILLARS**

FRAME	S	B	H	SPACING	OF BEAM	OF PILLAR	REMARKS
0	13.60	10.22	5	6.9	6.5	3	1st
8	16.25	13.33	5	10.8	6.5	3	1st
71	12.38	13.33	5	9.5	6.5	3	1st
16	26.75	13.60	20.7	6.5	6.5	3	1st
26	20.63	15.22	5	15.7	6.5	3	1st
37	23.38	15.83	5	18.5	6.5	3	1st
48	19.25	16.00	5	15.6	6.5	3	1st
78	26.13	16.44	5.75	23.9	6.5	3	1st
90	26.75	15.78	5	19.5	6.5	3	1st
101	20.63	16.78	5	15.2	6.5	3	1st
113	26.13	23.35	5.75	21.0	6.5	3	1st

**HATCH**

FRAME	S	B	H	SPACING	OF BEAM	OF PILLAR	REMARKS

YOSHIO  
 ZOSSEN KASHA, LTD.  
 SHIP DRAWING OFFICE  
 DRAWING BY  
 CHECKED BY  
 APPROVED BY  
 DATE  
 29.3.15



Profile

N<sup>o</sup> 268

S. S. <sup>th</sup> Lomina Ham

Rept-N<sup>o</sup> 1159

Nagasaki



RETAI



© 2020

Lloyd's Register  
Foundation

W1358-0152