


This Plan is in accordance with the
 drawings and arrangements approved on
 11. 12. 29.

11. 12. 29

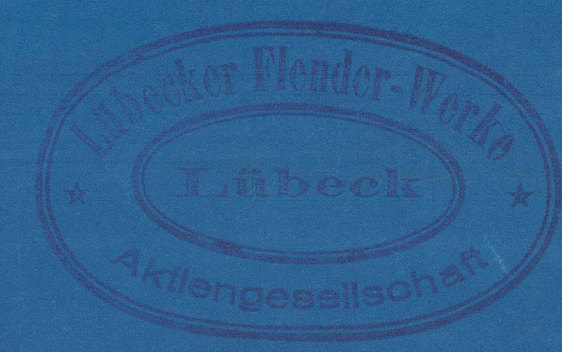

174
 4.
 15. 6. 27
 3. 11. 29

Lubecker Werke.

^{6.}
Framing profile.

Hamburg Report Nr.

196 80

[Signature]

RETAIN



© 2020

Lloyd's Register
Foundation