


17.5.15  
9.6.15  
30.6.15  
23/6/16  
7.7.16  
18.9.16

# MIDSHIP SECTION.

SCALE 1/2" = 1'-0"

LENGTH B.P. 420'-0"  
BREADTH EXTREME 68'-6"  
DEPTH MLD. UPPER DR. 50'-6"  
CLASS 100 A.I.L. LLOYDS.

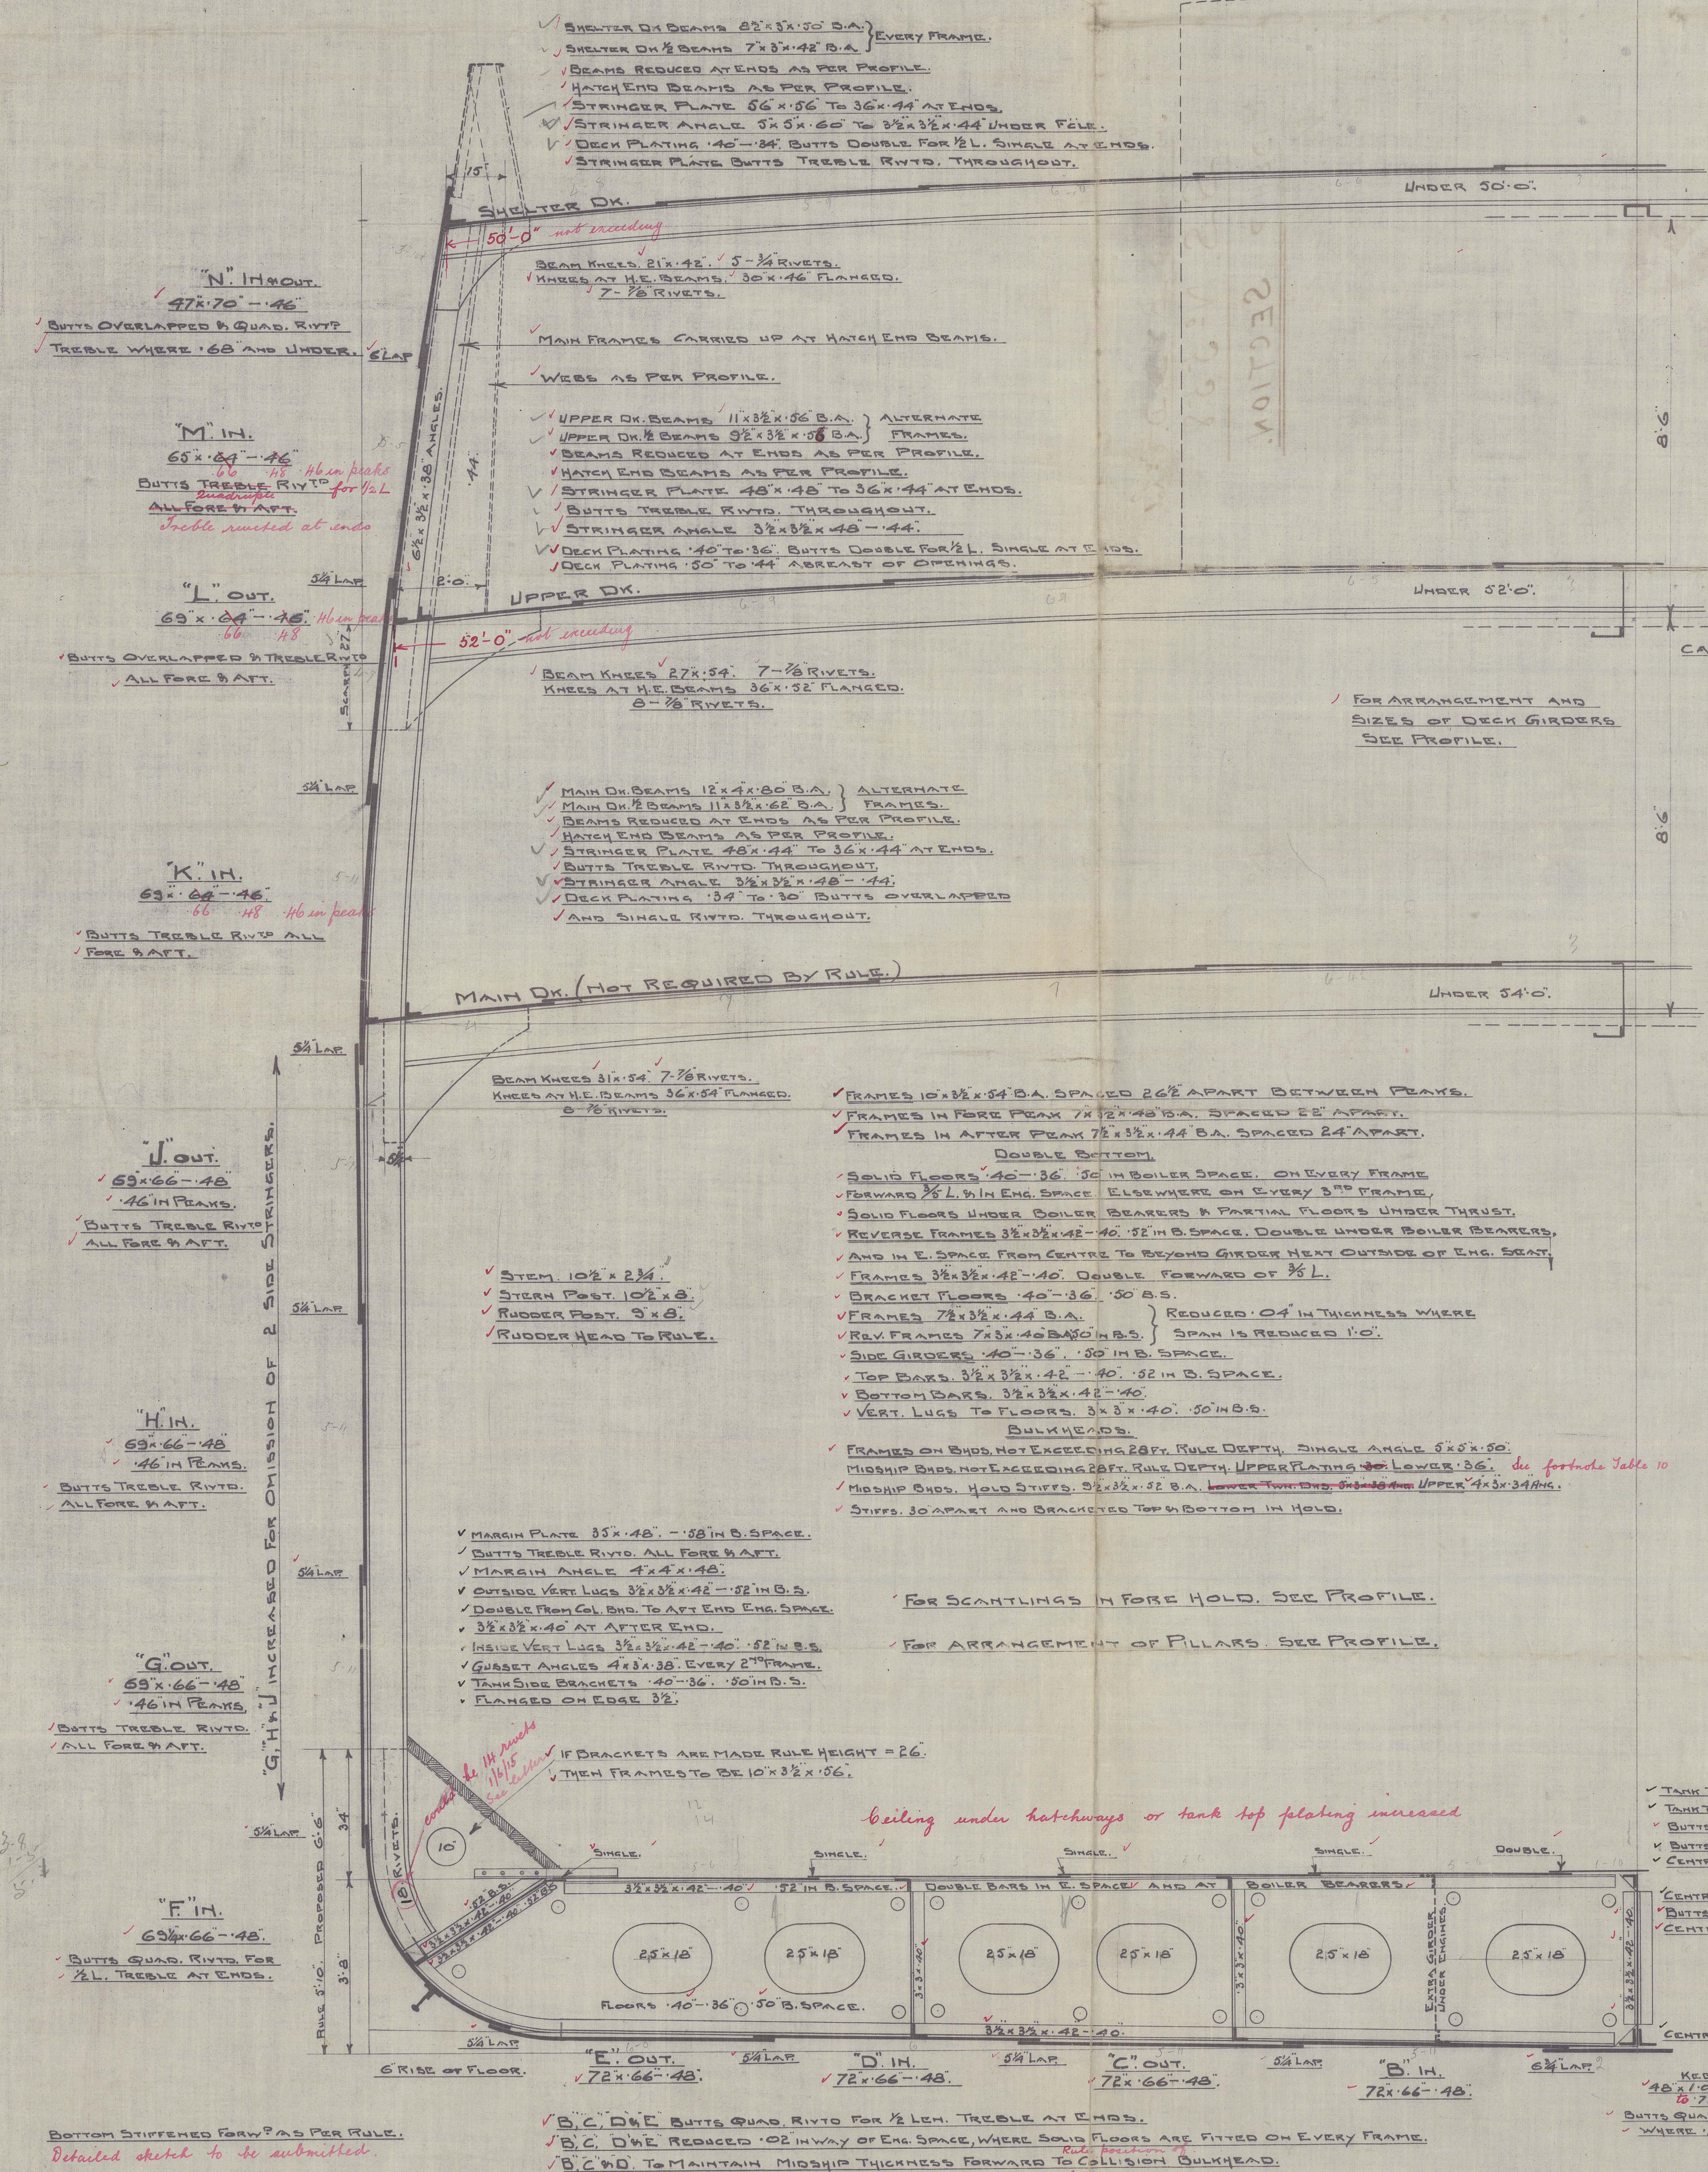

**NUMERALS**

|                               |              |
|-------------------------------|--------------|
| BREADTH MLD.                  | 53'-25"      |
| DEPTH MLD.                    | 30'-50"      |
| TWEEN DECKS.                  | 50"          |
| TRANSVERSE NUMBER.            | 84'-25"      |
| LENGTH B.P.                   | 420'-00"     |
| LONGITUDINAL NUMBER.          | 35585        |
| ERECTOR.                      | 2705         |
| CASINGS ETC.                  | 461          |
| EQUIPMENT NUMBER.             | 38551        |
| LENGTH + DEPTH TO SHUTTER DR. | 10'-76"      |
| d                             | UNDER 18'-4" |

Due to increased depth of tank O. B. D. d' for frames only may be taken as 18'-0"

**EQUIPMENT**

|                                         |
|-----------------------------------------|
| 2 BOWERS ANCHORS STOCKLESS 60 CWT. EACH |
| 1 BOWEN ANCHOR STOCKLESS 30 CWT.        |
| 1 STREAM ANCHOR EA. STOCK 19 CWT.       |
| 1 KEDGE ANCHOR EA. STOCK 8 CWT.         |
| 270 FATHOMS 2 1/2" STUD CHAIN CABLE     |
| 30 " 5" STEEL WIRE                      |
| 120 " 5 1/2" STEEL WIRE TOWLINE         |
| 2 @ 30 " 3 1/2" " " HAWKER              |
| 30 " 3 1/2" " " " "                     |
| 2 @ 30 " 5" " " " "                     |
| 2 @ 30 " 8" MANILLA                     |
| 2 @ 30 " 7" " " " "                     |



No 558



Irving & Co. D. C. Ltd.

S.S. N° 558

MIDSHIP SECTION.

S/S. Thistlemore

West Hartlepool Report

N° 15-H17

