


Lloyd's Register of Shipping.


Ship's Name STANBRIDGEOfficial No. 139200

Memorandum of alterations reported since ship was surveyed for assignment of Load Lines
in _____

ALTERATIONS TO BULWARKS

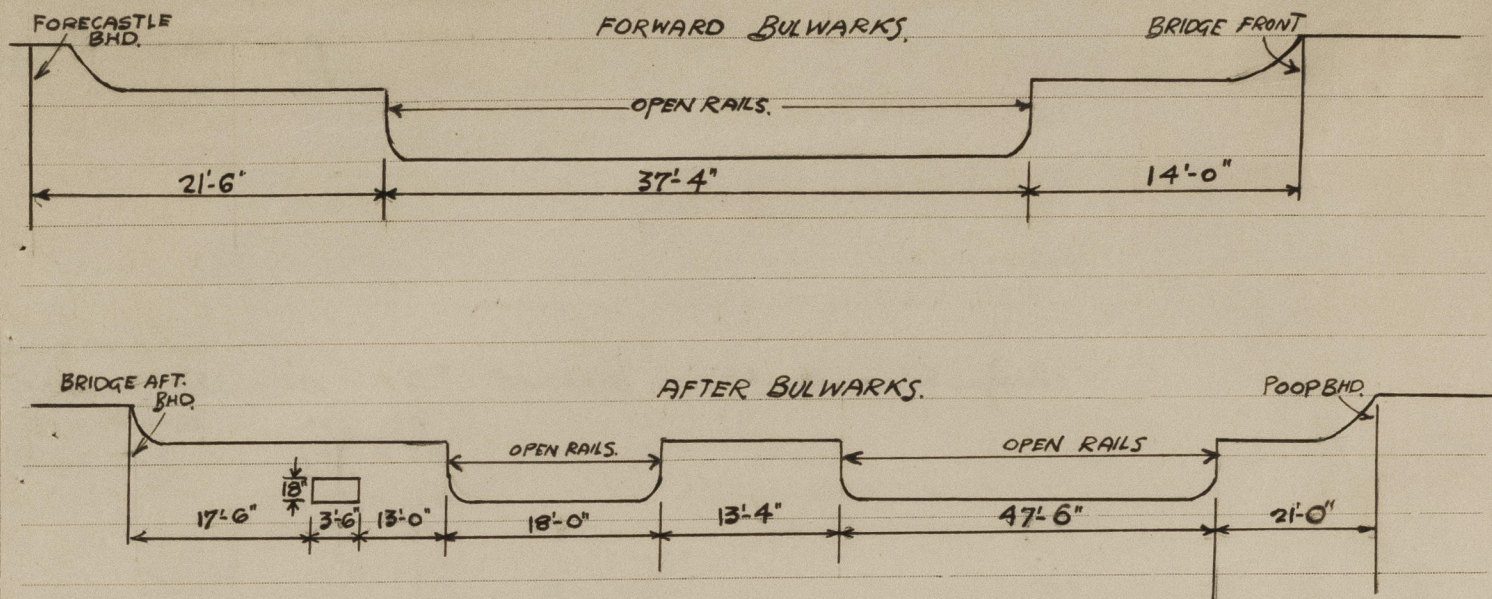

ADDITIONAL STIFFENING ON FORE & AFT GANGWAY.

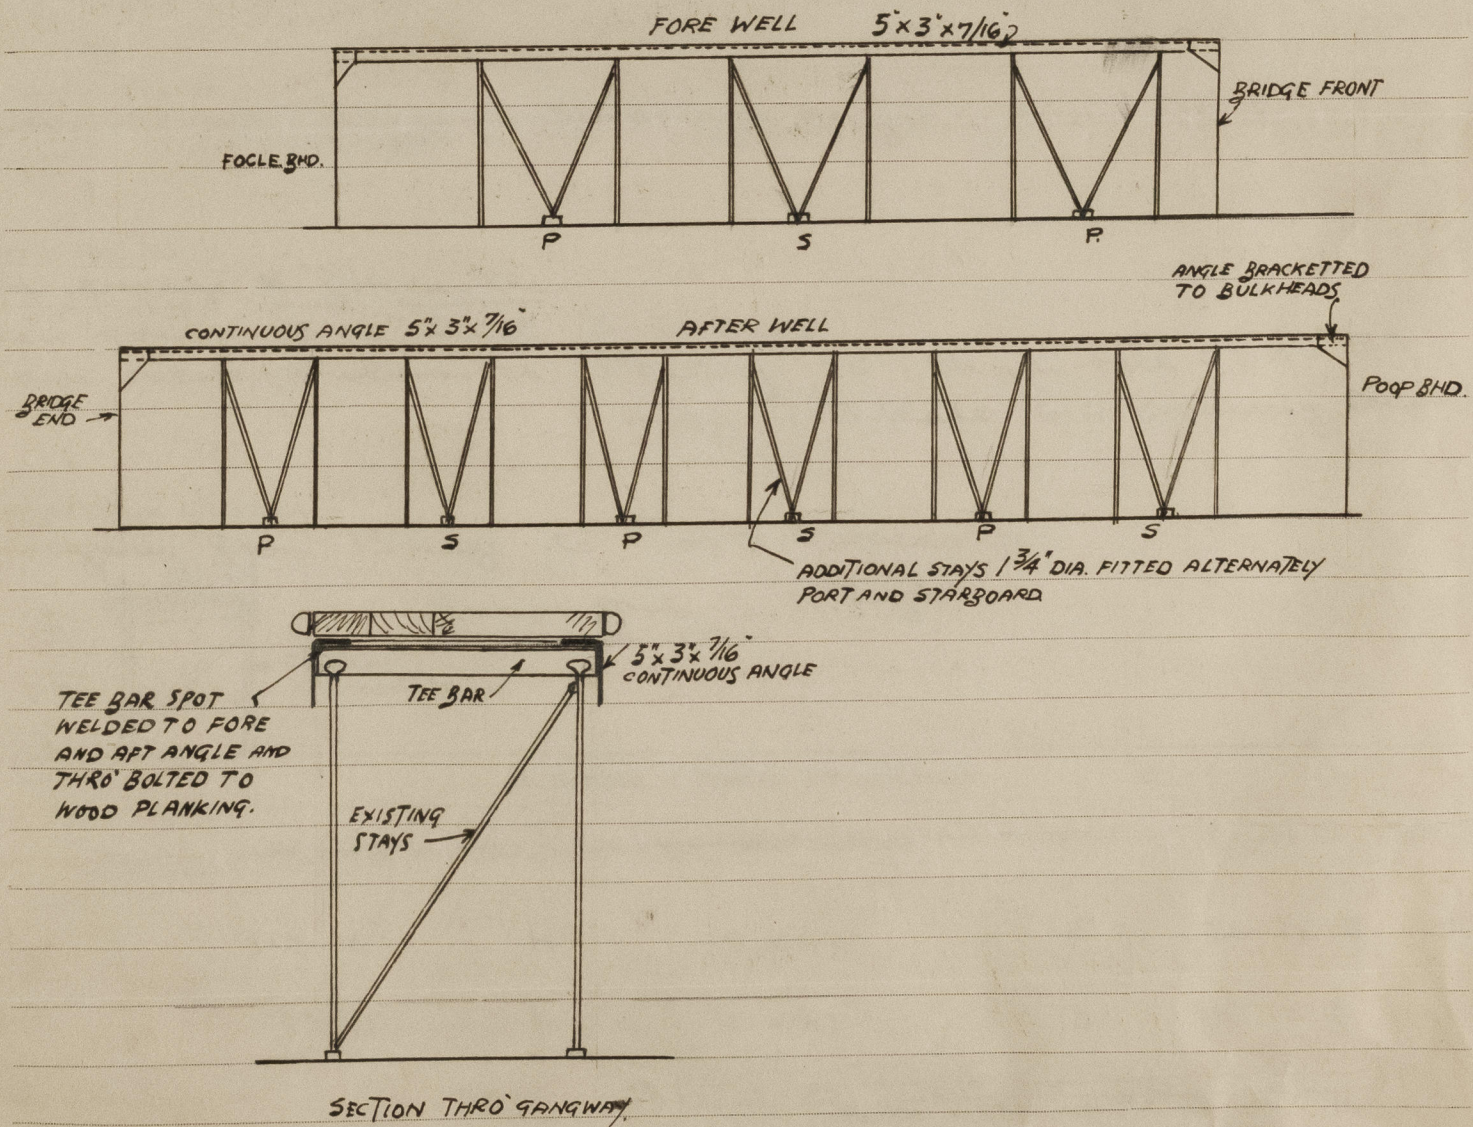

S.B. Lumsden.