


31.8.07
10.10.07
23.11.07
7.3.08

PROFILE AND DECK PLANS

S.S. NO 278


SCALE 1/8" = ONE FOOT

DIMENSIONS 248'-6" x 42'-10" x 17'-4" TO MAIN DECK
TO CLASS LLOYDS A (GREAT LAKES SERVICE CANADA)

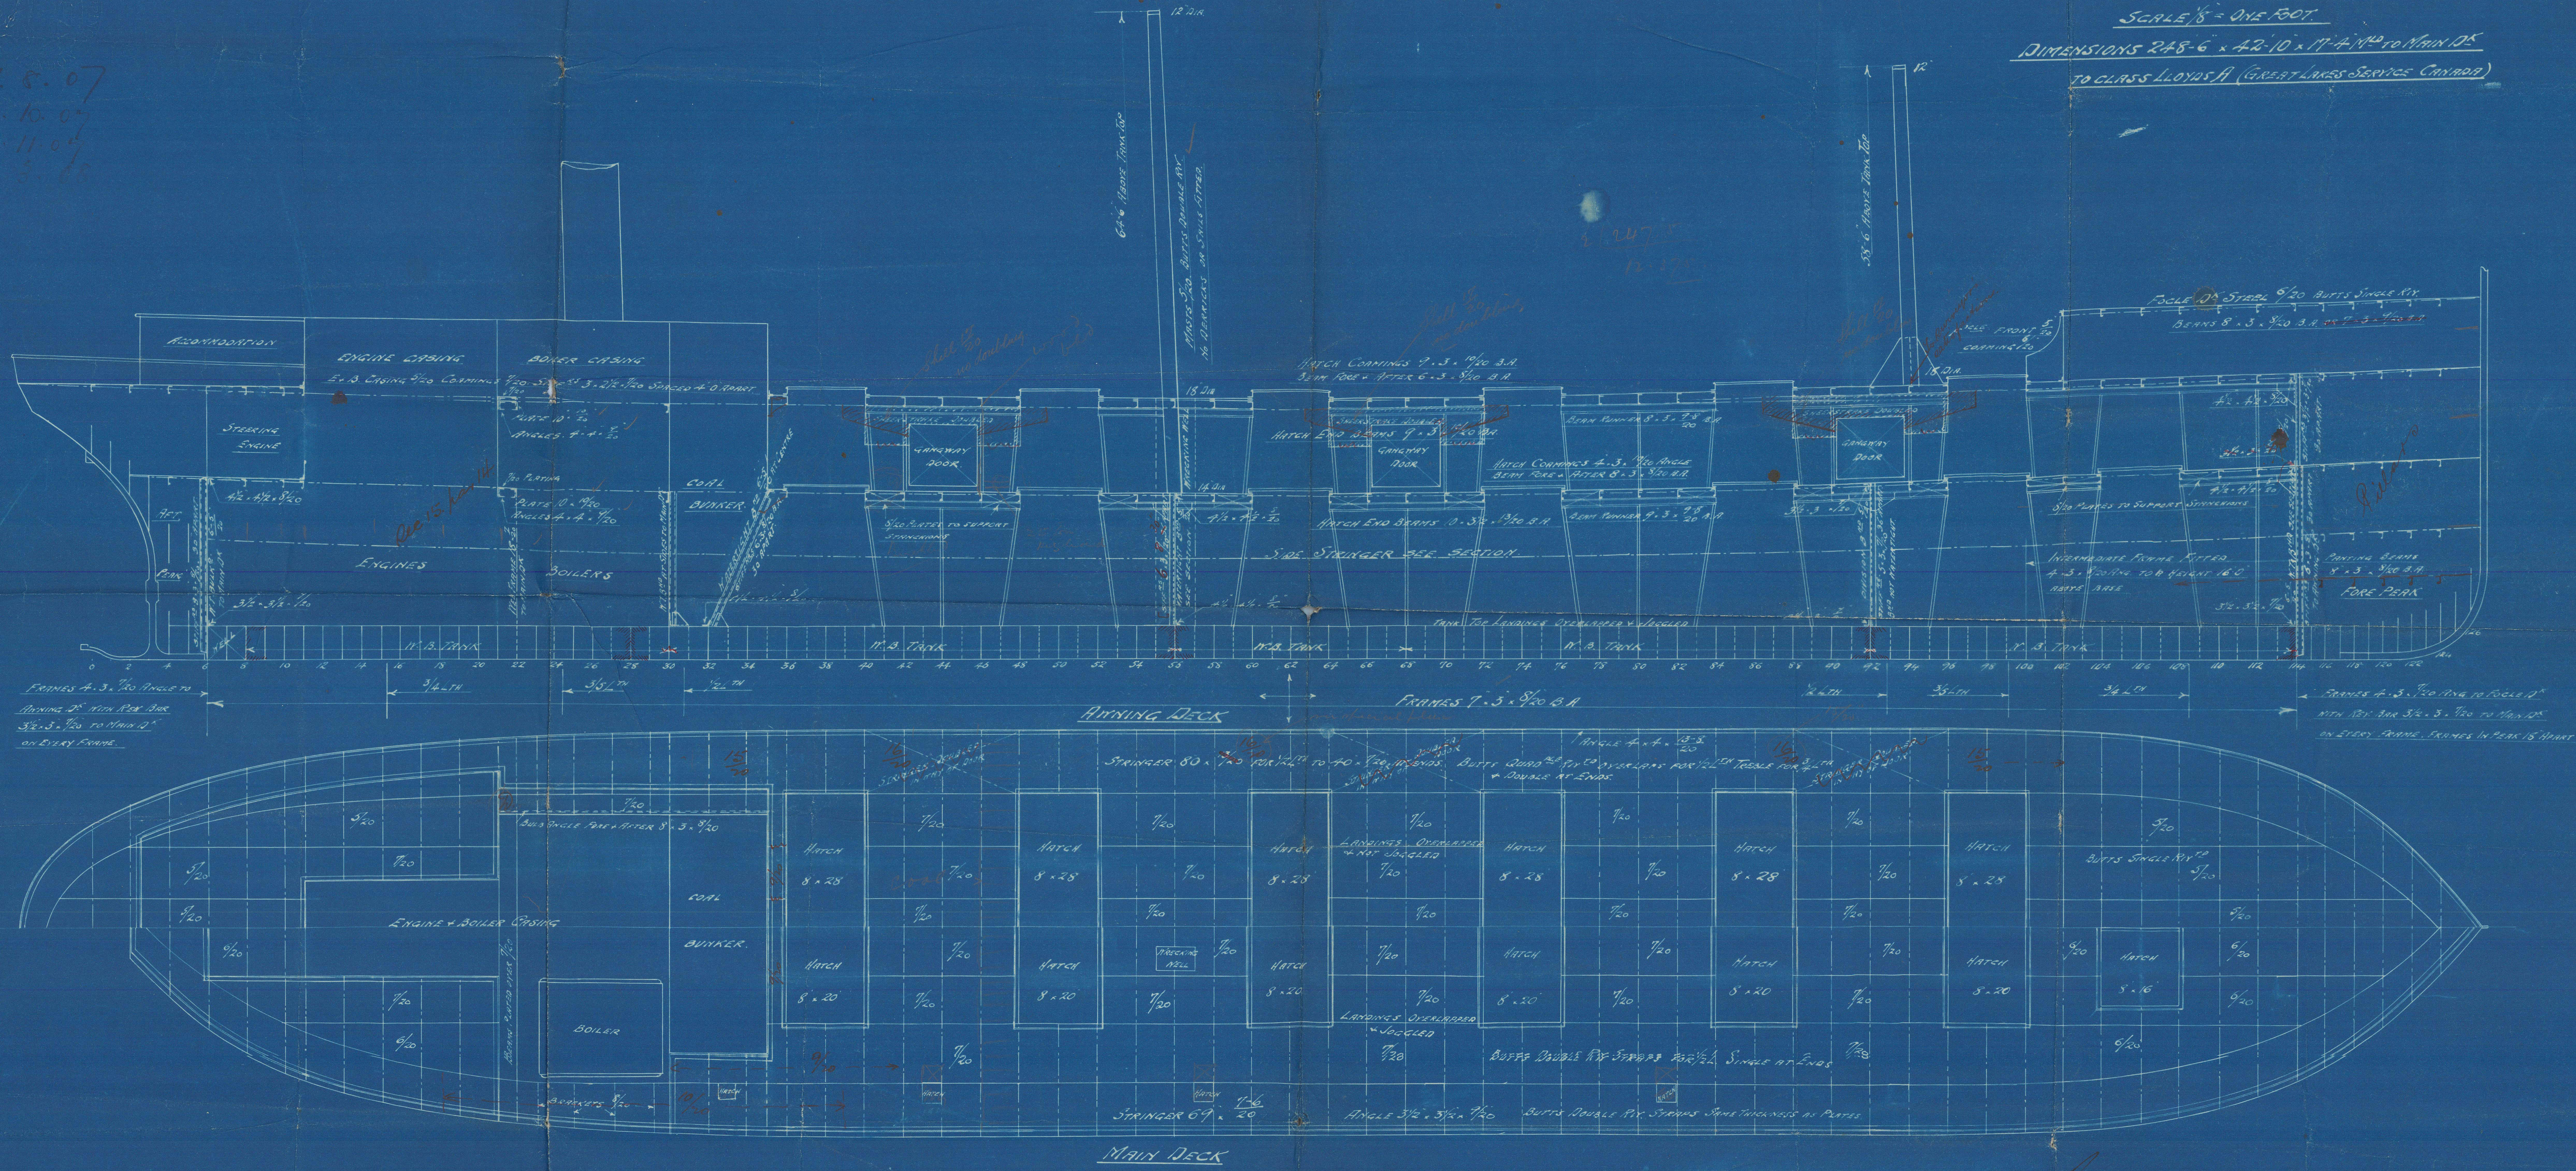

C.B.
30.8.07.




W1361-00143

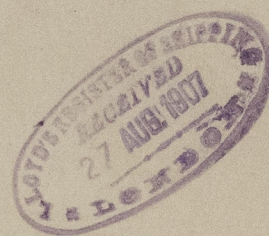

W1361- 0043

T Clyde S.B. & Eng. Co.
No. 278

Profile & deck plans.
"ACADIAN"
REPORT No 15349

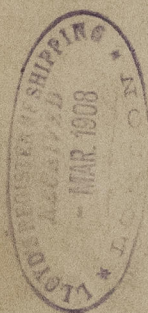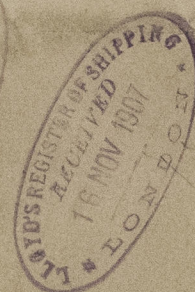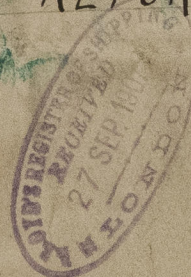

© 2021
Lloyd's Register
Foundation

W1361- 0043