

30.8.06

N<sup>o</sup> 1544. Multitubular Boilers for

Messrs J. T. Eltringham & Co's N<sup>o</sup> 260 P/VG


W. Pressure 45 lbs per sq. inch

Scale 1" = 1 foot

Tested to Lloyds Requirements

Heating Surface.

Tubes	525 sq. ft.
Furnaces	86 "
G. Chambers	75 "
Tube Plates	21 "
	2
Total for 2 Boilers	1414 sq. ft.

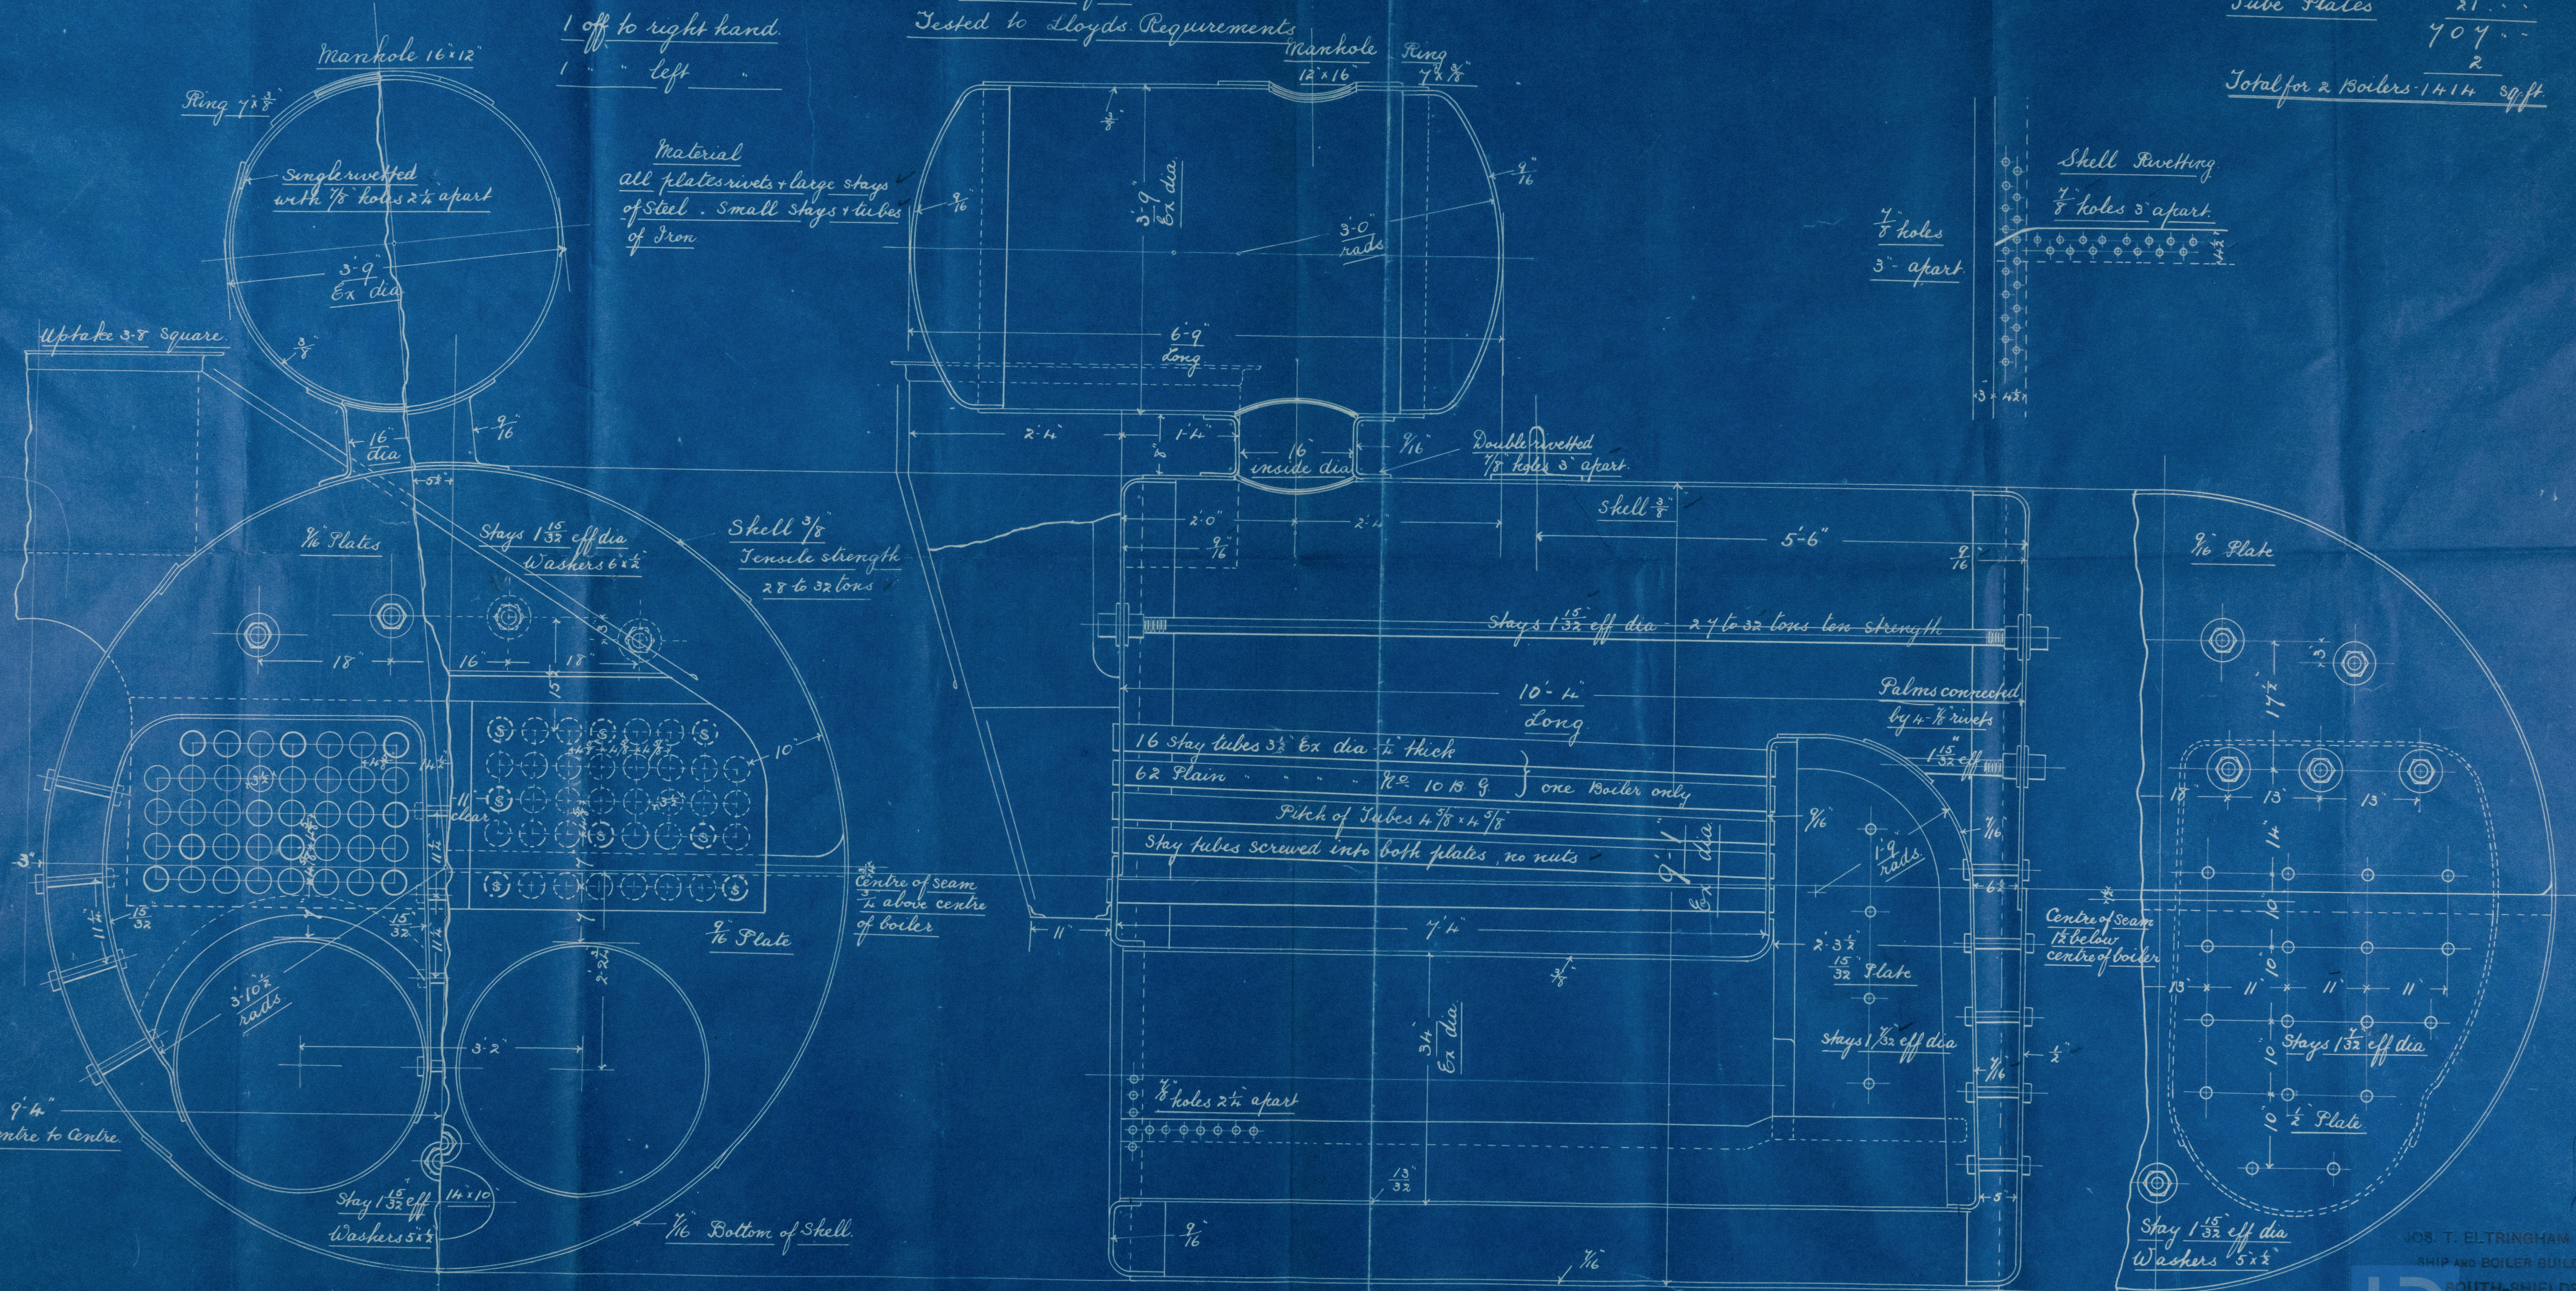

30.8.06

JOS. T. ELTRINGHAM & CO.  
SHIP AND BOILER BUILDERS  
SOUTH-SHIELDS.  
713.  
27.8.06



Newcastle.  
J. J. Eltringham & Co


Bkr. No. 1544

W. P. 454<sup>d</sup>

for  
Same firmis

P. S. 260

No. 7423  
Lloyd's Trust  
90 U.  
5-2-04. H.G.U.

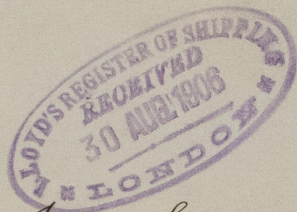

J. J. Acton Grange.

Newcastle Report

No. 52660.

W1363-0032



© 2021

Lloyd's Register  
Foundation