


12th 2nd
 Glasgow Report
 18th 1st

SS No 212. 212
130'-0" x 23'-0" x 11'-0" M^{LR}
SCALE $\frac{1}{2}" = 1 \text{ FOOT.}$
TO CLASS 100.A.


SECTION IN WAY OF QUAR. DECK.

— MIDSHIP SECTION —

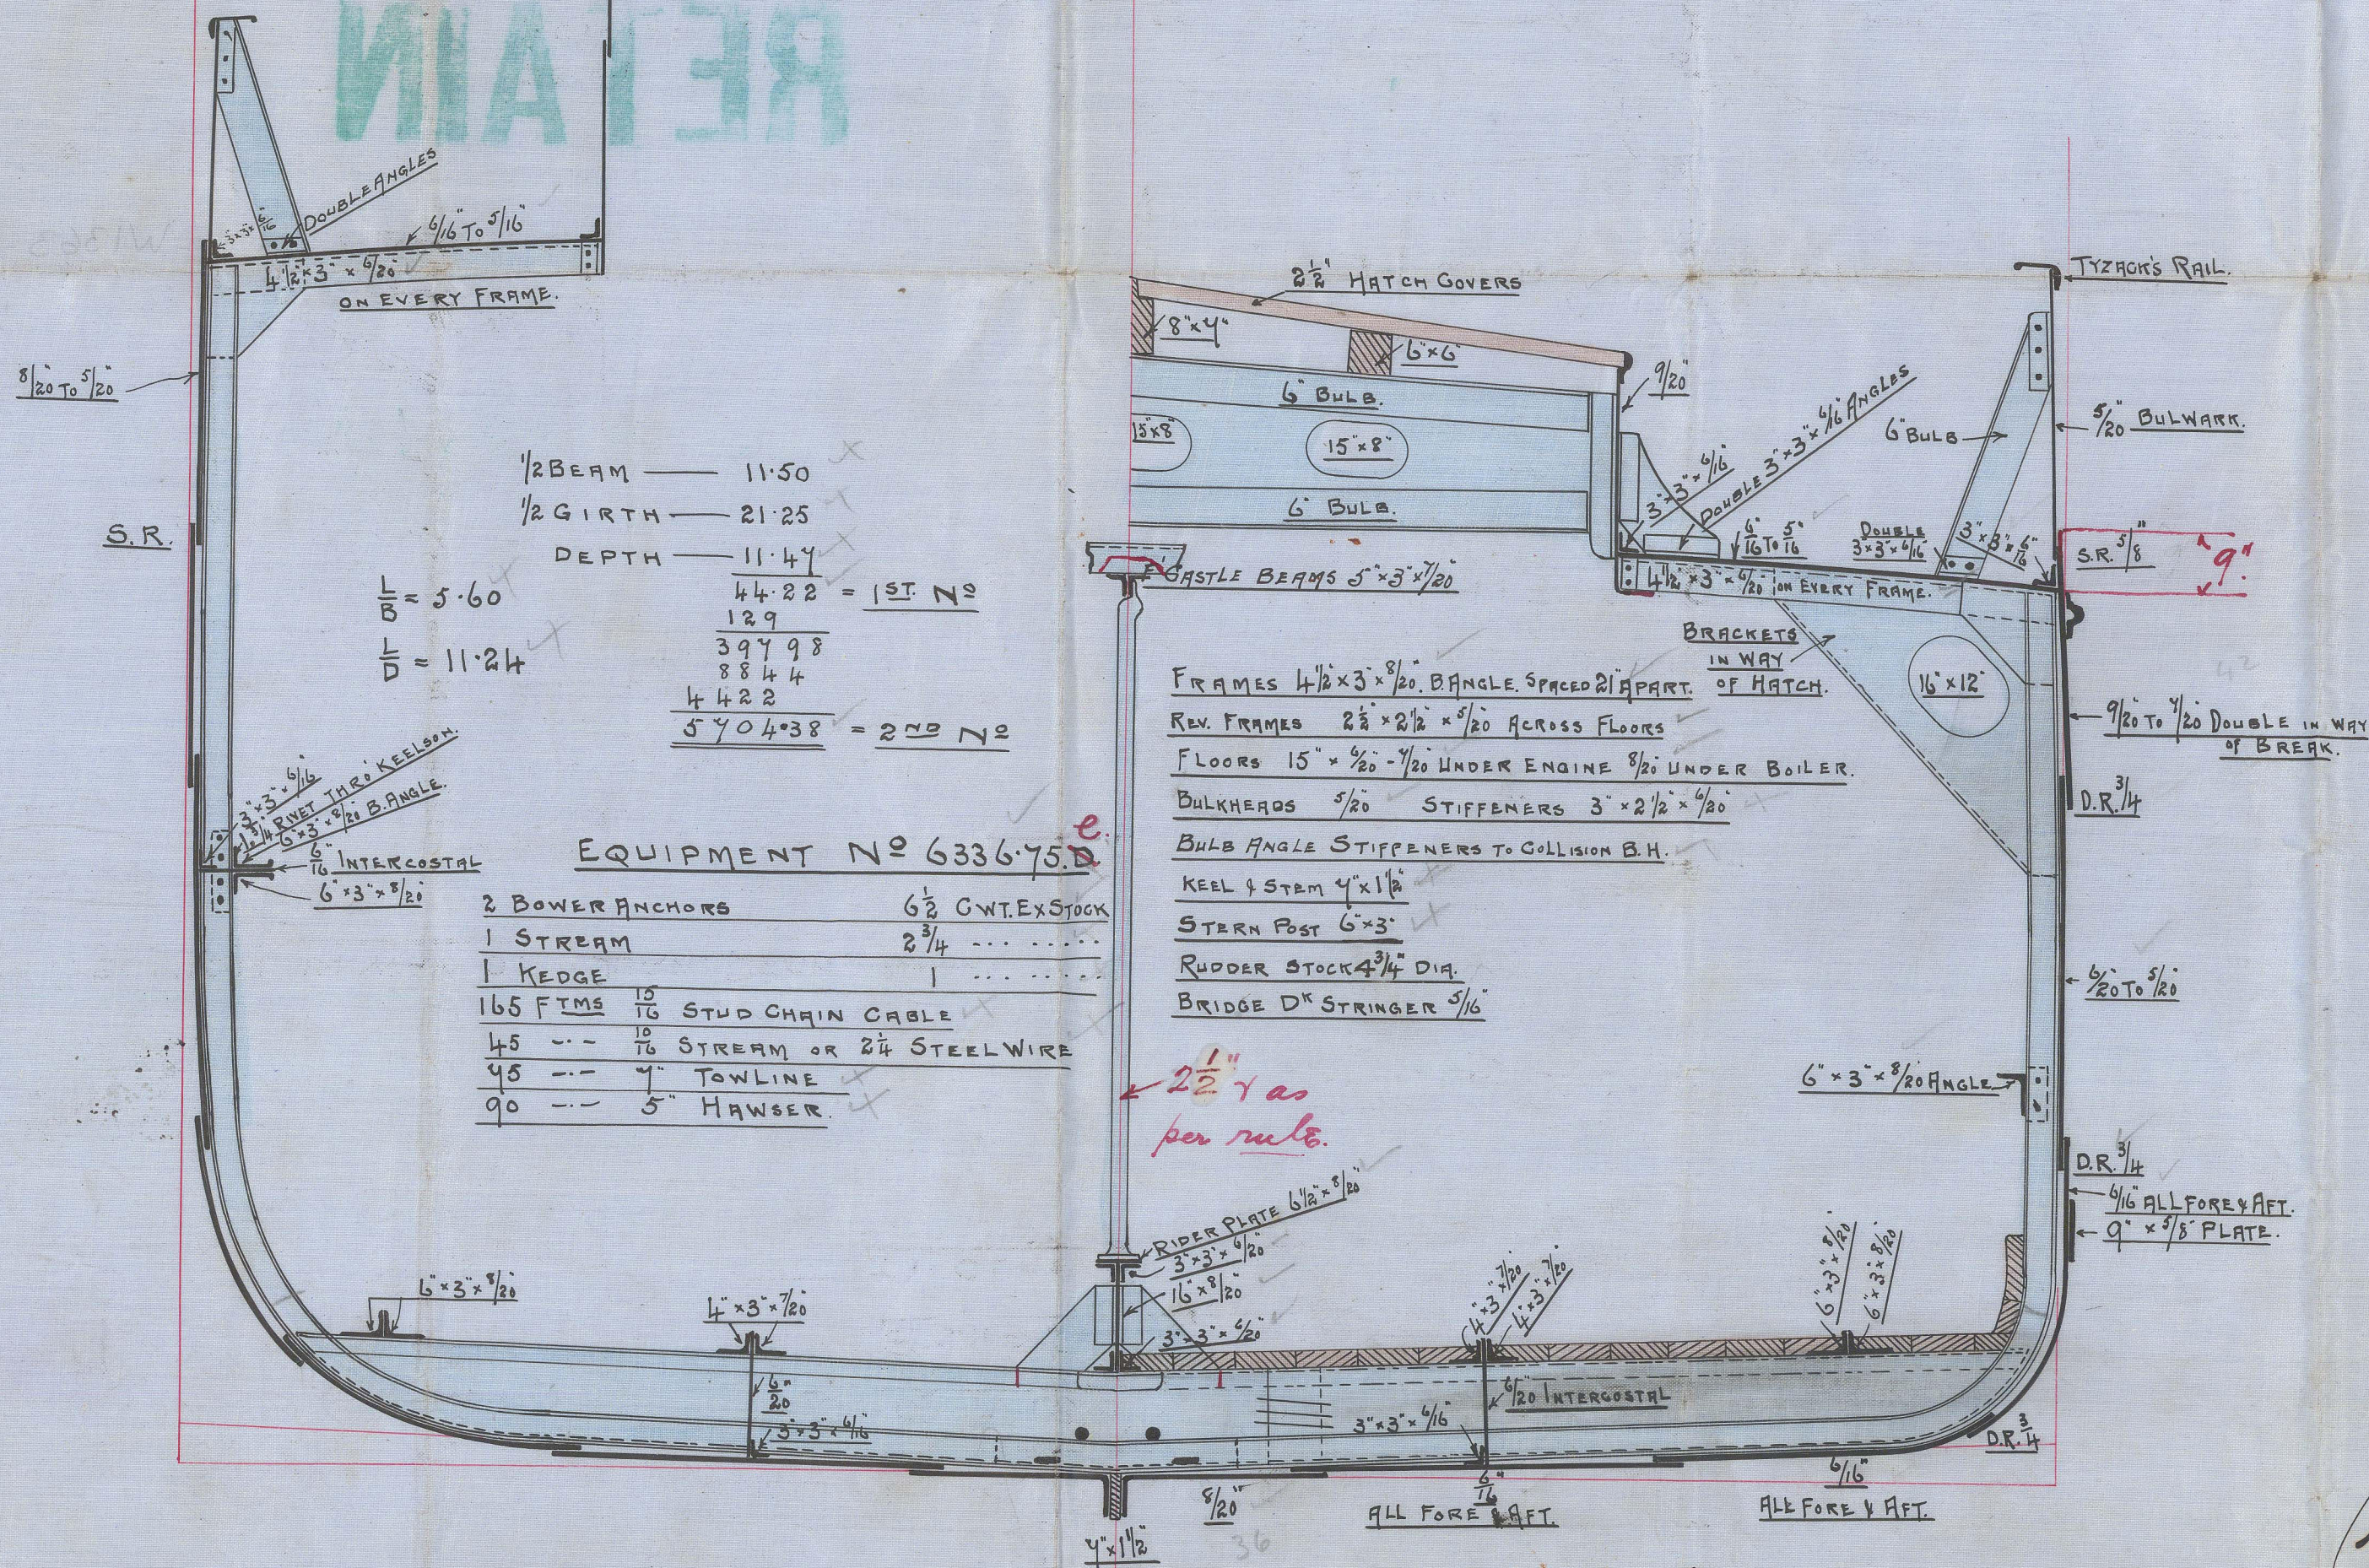

TRW
17/5/08

Mid. Section
Scott & Sons
212-213

ss. 'Agnes Ellen'
GLASGOW Report No. 27286.

s/s "J. + J. Monks"
Glasgow Report
No. 24421

RETAIN



© 2021

Lloyd's Register
Foundation

W1363-0109