

J. MCKNIGHT & CO., LIMITED

SLIP DOCK


24TH OCT 1901.

Tracing No. 1457

A Y R

SHIP BUILDERS AND REPAIRERS

SCALE $\frac{1}{2}'' = 1 \text{ FOOT}$

TO CLASS 100 A.I.  STEEL AT LLOYDS.

LENGTH B.P. 150'-0", BREADTH M^{LD} 24'3", DEPTH M^{LD} 11'-8"

<u>ER ECTIONS</u>	
<u>QUARTER DECK.</u>	<u>53.50</u>
<u>BRIDGE "</u>	<u>14.00</u>
<u>FORECASTLE "</u>	<u>27.25</u>
	<u>94.75</u>


NUMERALS

$\frac{1}{2}$ GIRTH	21.955
$\frac{1}{2}$ BREADTH	12.125
DEPTH	12.166
1 ST NUMERAL =	46.246
	X 148.96
2 ND NUMERAL =	6888.80
6888.80×94.75	
B 148.96	= 547.66
EQUIP ^I NUMERAL =	7436.46

PROPORTIONS

$\frac{L}{D} = 12.24$ $\frac{L}{B} = 6.14$


ROUND OF BEAM 6" INCHES.

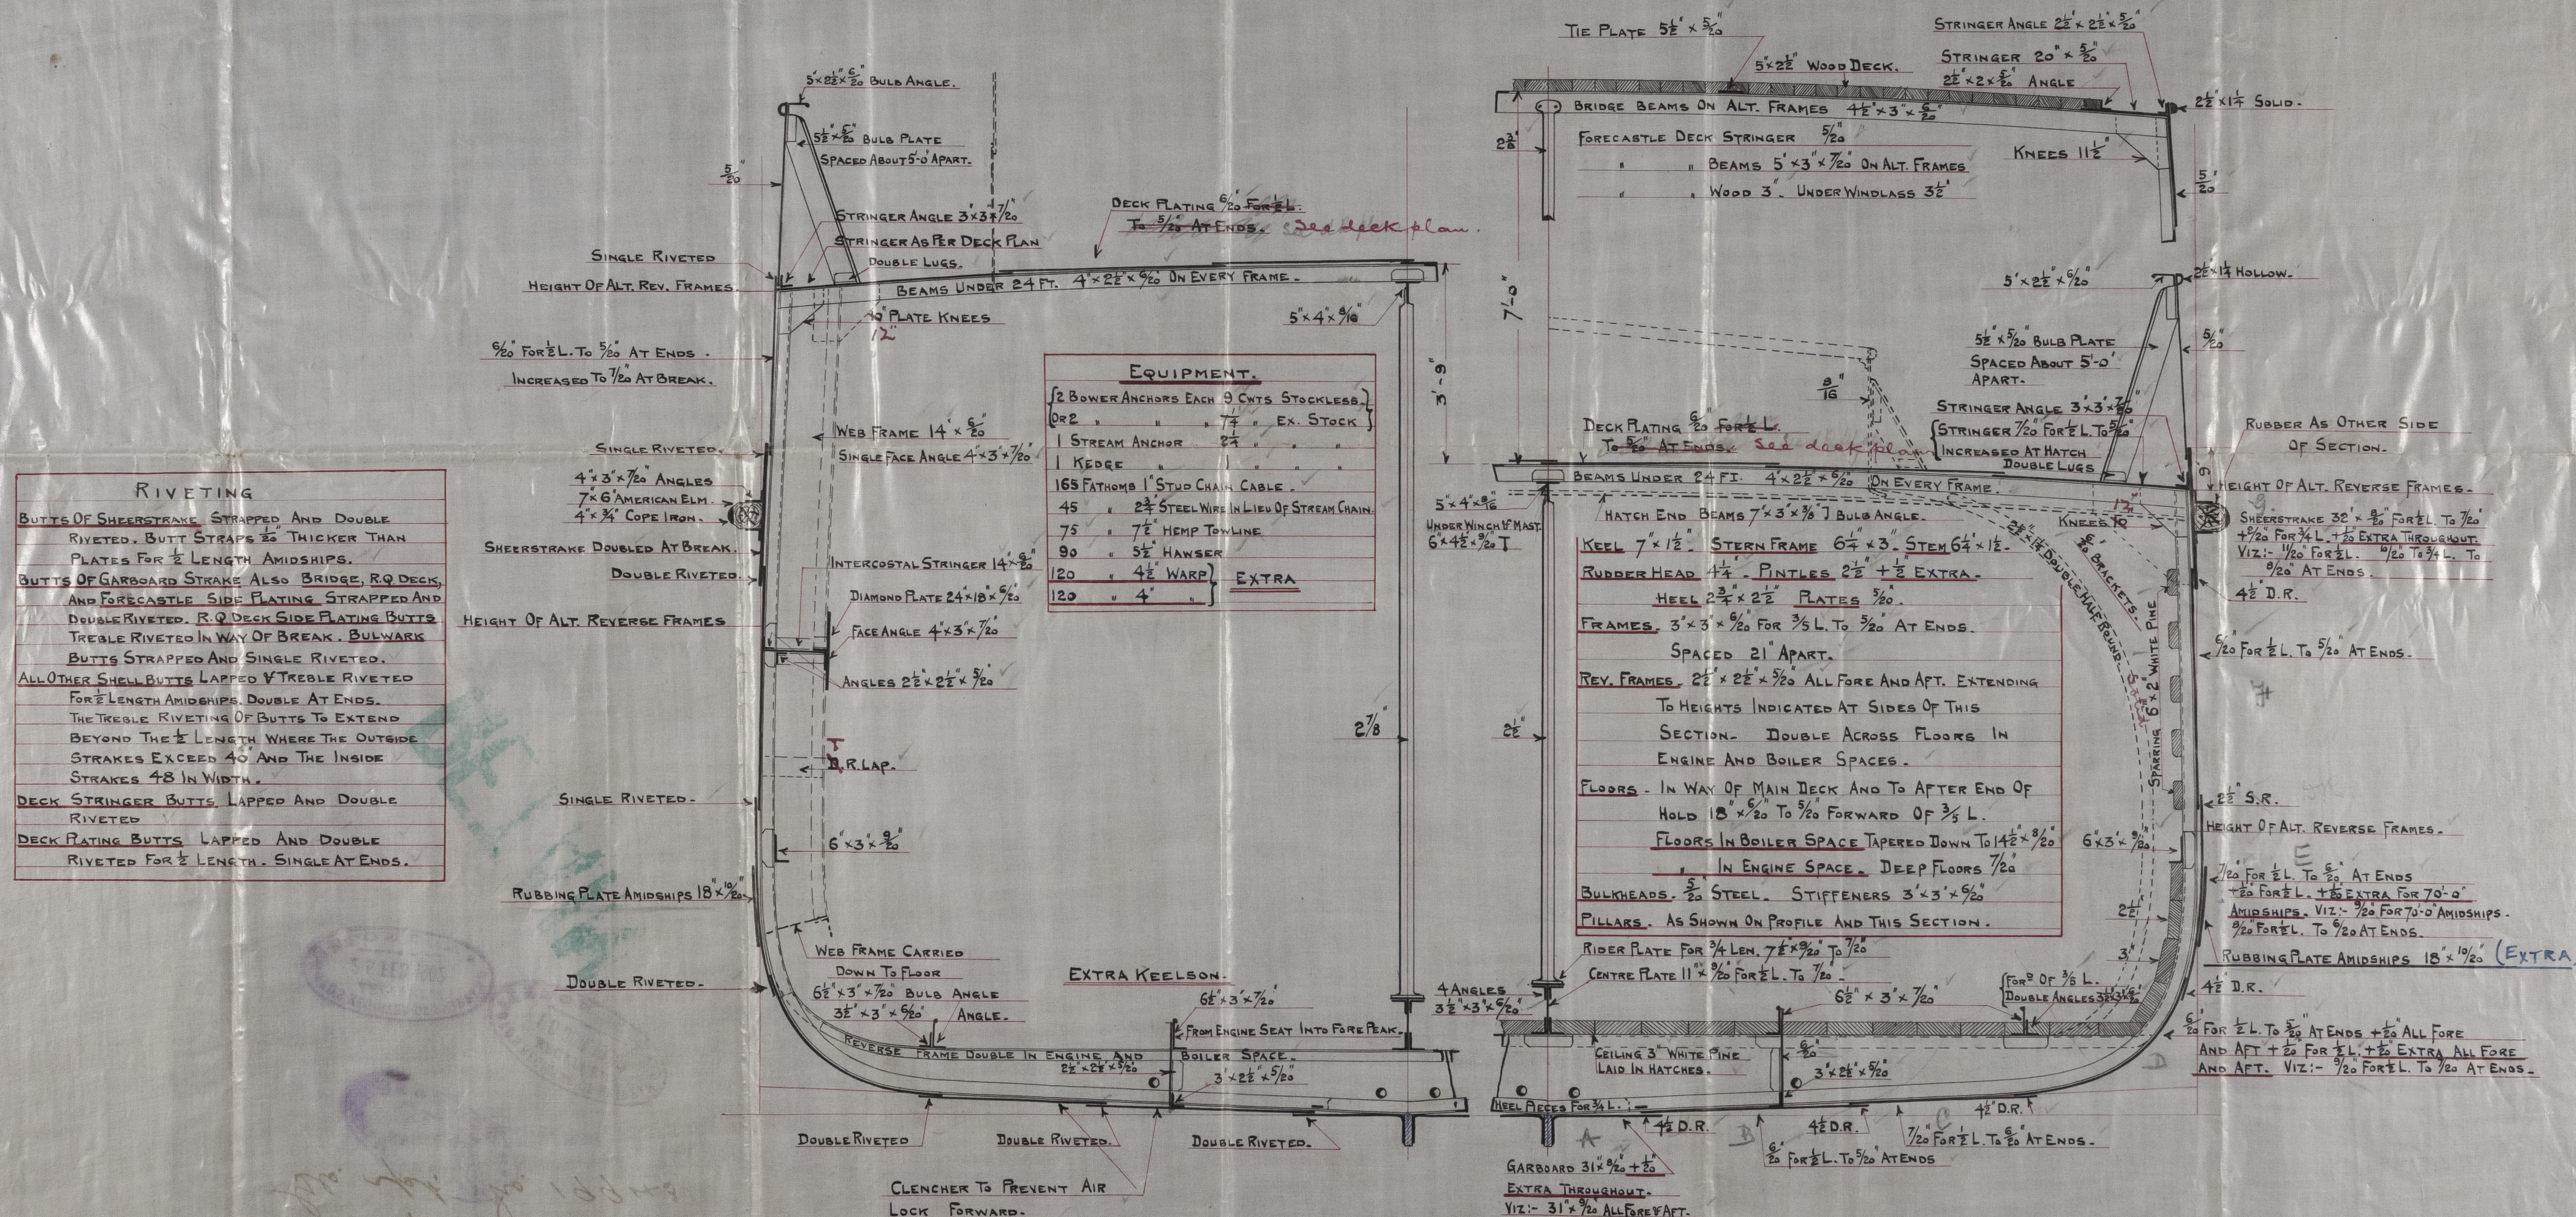

5-11-2021
© 2021
Lloyd's Register
Foundation

Shipping Section

S. M. Knijht v. d. La
no. 66 5/8 " Annie
Gls. name no. 19943

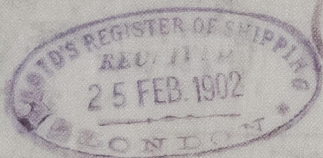

RECEIVED



© 2021

Lloyd's Register
Foundation