



5-11-01

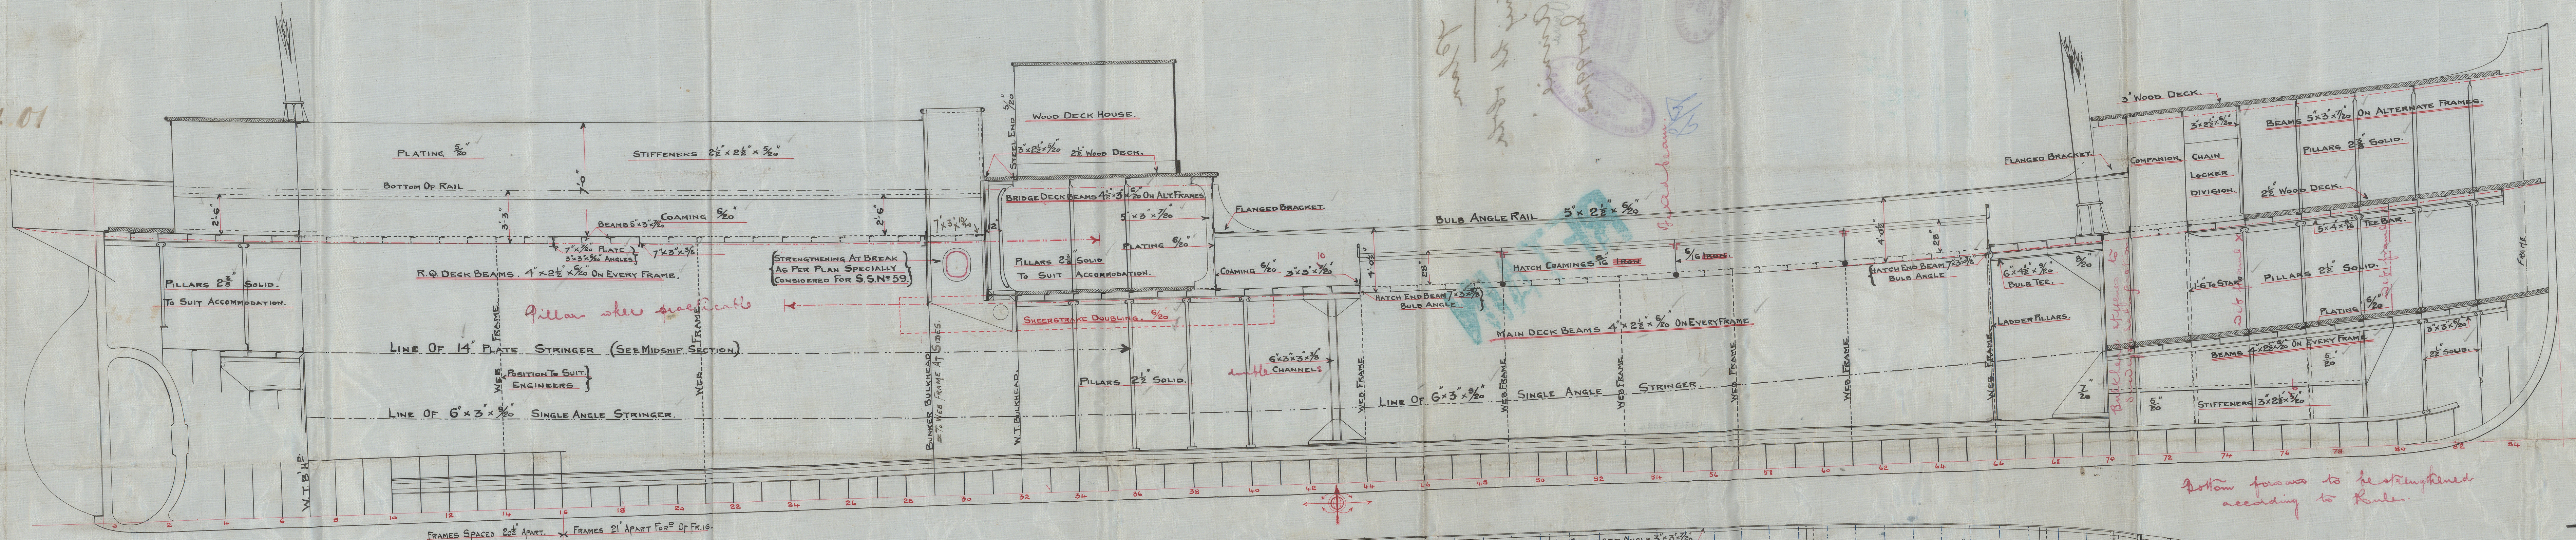


IRON PLAN.
S.S. N°66
SCALE 1/4" = ONE FOOT.

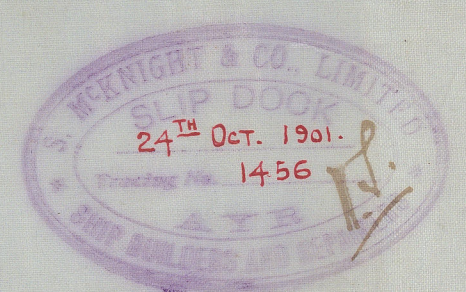

c.b.
5.11.01.

211
Iron Plan.

S. metnig ht obla.
no 66 8/5 Annie
Gls. rpt. no 9943

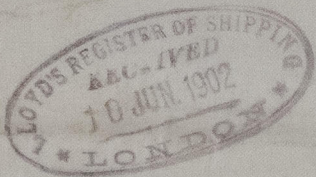

Handwritten initials



© 2021
Lloyd's Register
Foundation