

28.9.11  
5.10.11

not to mention  
10.12-21.2.11  
watered quibbitt

PLAN No. 127.8  
FOR ENCLOSURE TO  
Messrs. Lloyd's  
FROM  
COCHRANE & SONS,  
SHIPBUILDERS, SELBY.  
DATE 24/3/12 *Rh*

# MIDSHIP SECTION

STEEL SCREW TRAWLER

Nos 515-16

DIMS 135'-0" x 23'-6" EX x 13'-3" DEPTH MLD


SCALE  $\frac{1}{2}$ " = ONE FOOT.

739

Messrs Lloyd's Surveyors  
Hull

Sept 26<sup>th</sup> 11 *Rh*

TO CLASS 100A.1. AT LLOYDS FOR FISHING PURPOSES.  
ENGINE & BOILER CASING AS PREVIOUSLY APPROVED.  
DECK PLATED OVER IN WAY OF MACHINERY SPACE.

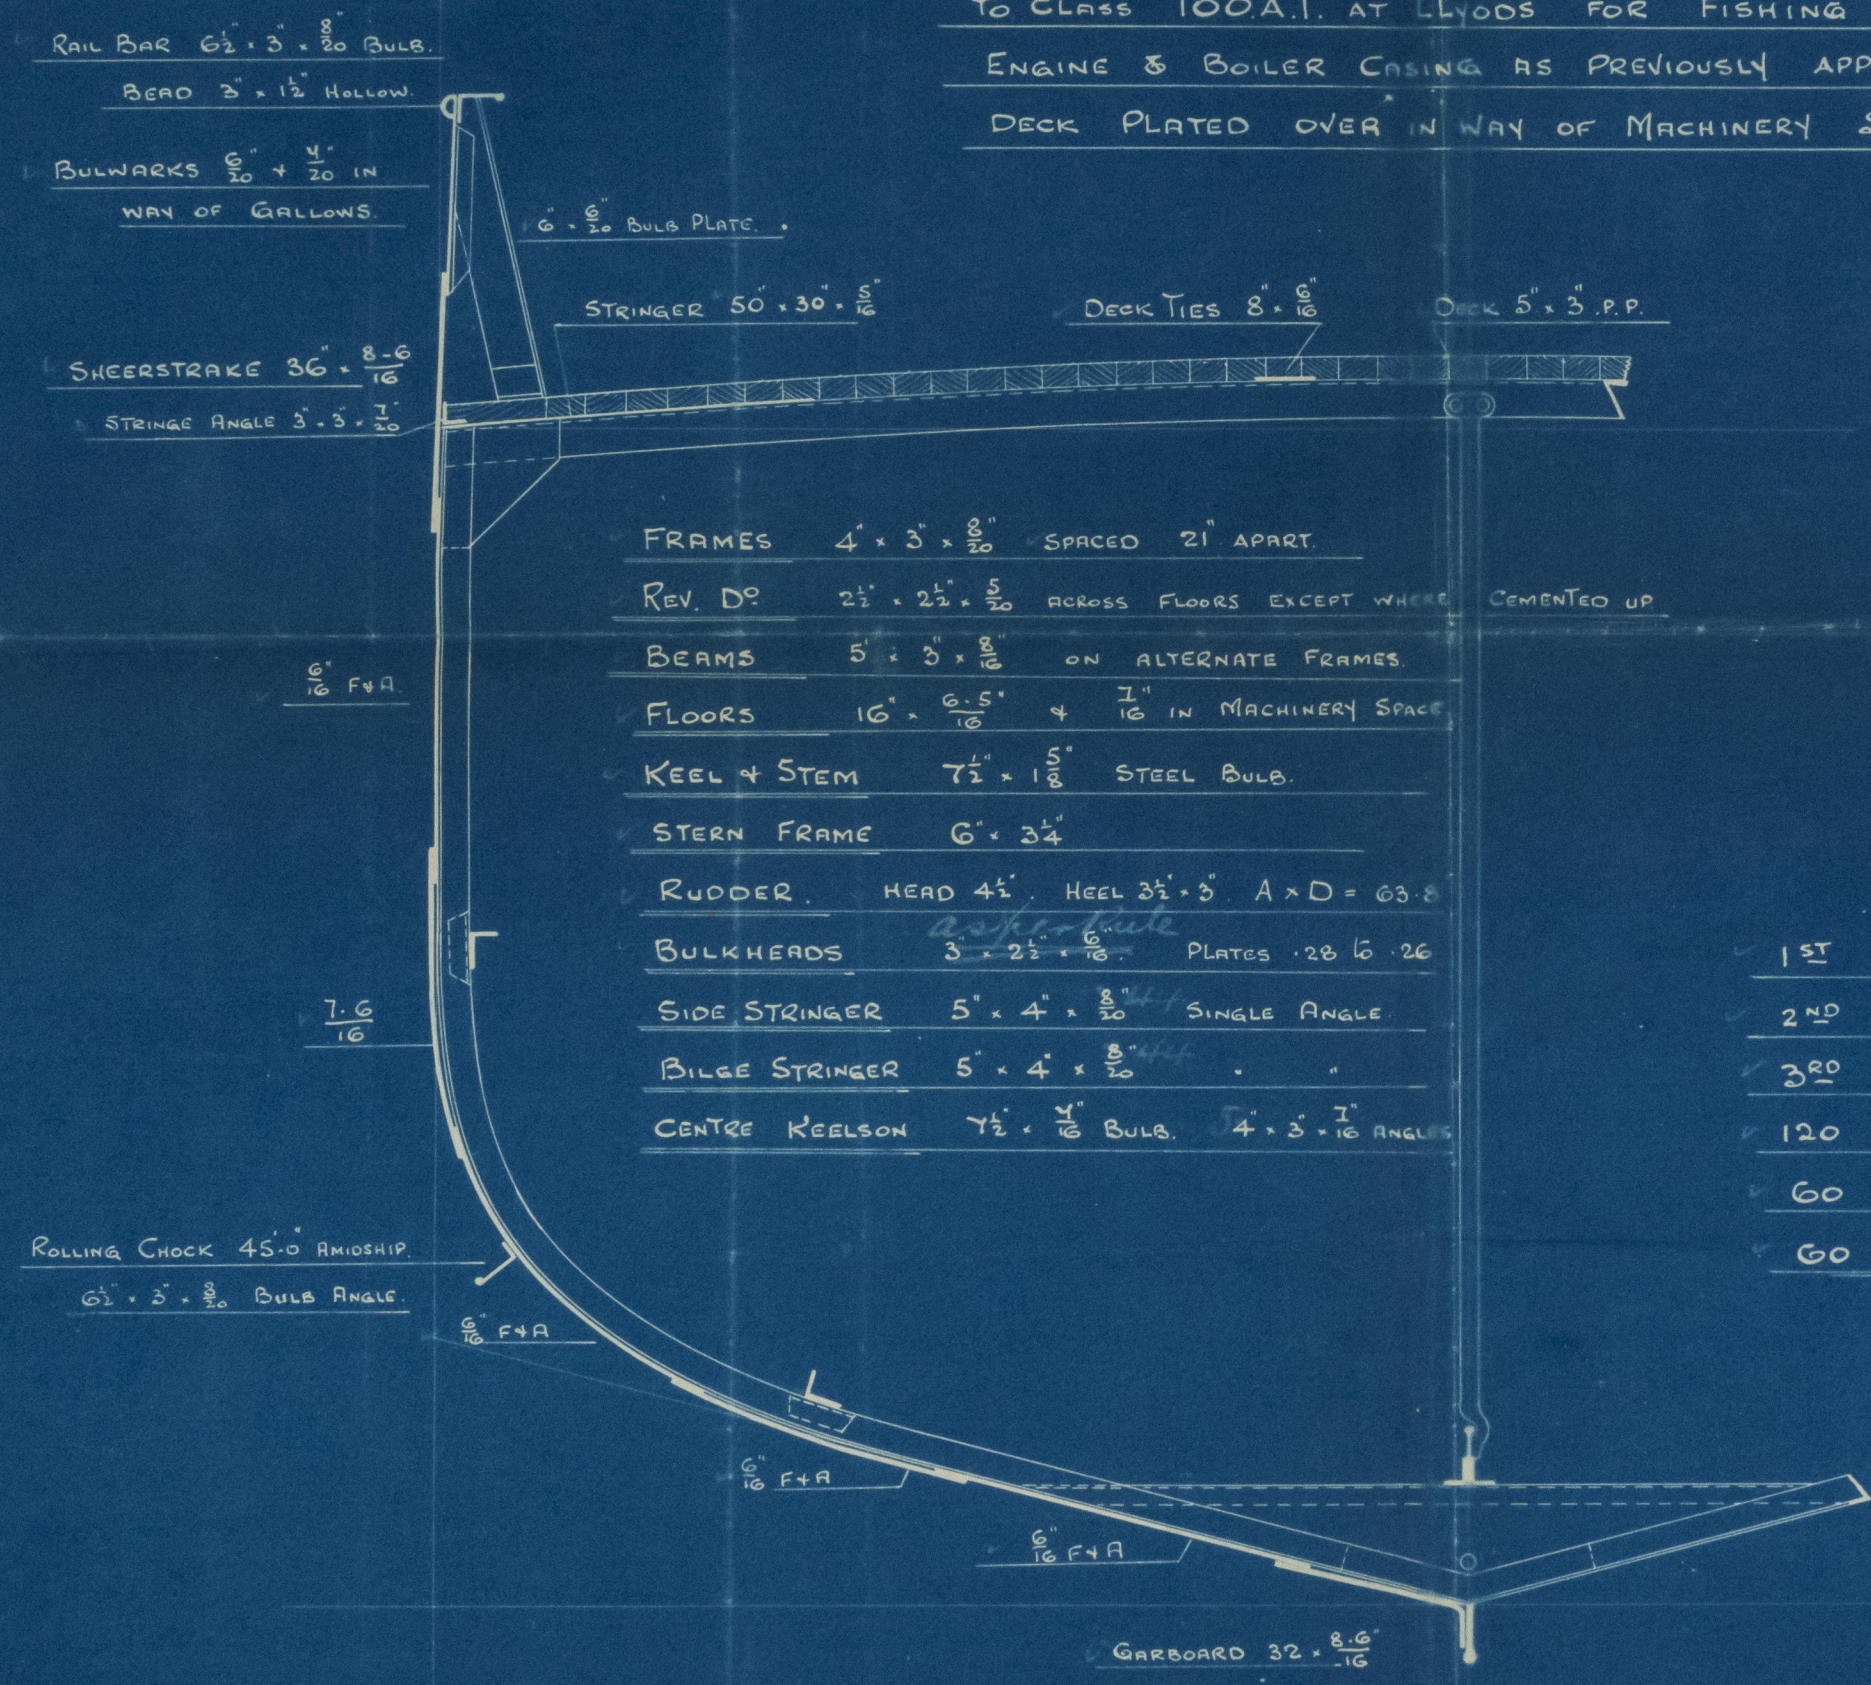

## NUMERALS.

$$D+B = 36.61$$

$$L \times (D+B) = 4942.35$$

## PROPORTIONS

$$\frac{D}{L} = 5.78$$

$$\frac{B}{L} = 10.19$$

## EQUIPMENT

1 <sup>ST</sup>	BOWER ANCHOR	$Y\frac{1}{2}$ CWT	STOCKLESS
2 <sup>ND</sup>	"	4	"
3 <sup>RD</sup>	"	3	EX STOCK.
120	FATHOMS	$1\frac{3}{16}$	CABLE
60	"	6	HAWSER
60	"	5	WARP

## RIVETING

BUTTS OF SHELL PLATING LAPPED & DOUBLE  
RIVETED EXCEPT GARBOARD & SHEERSTRAKE  
WHICH ARE TO BE STRAPPED.  
LANDINGS DOUBLE RIVETED. BULWARKS SINGLE RIVETED.

*C.R.*  
28.9.11

W1369-0093



Foundation



Cochrane & Sons.

Nos 515-516.

Duplicate.

Midship Section.

1/2 Baldur Hull Rpt No: 24704

" Paragi " " " 24710

RETAIN



© 2021

Lloyd's Register  
Foundation