


Amended plan

Muelr Steel main Boilers
by

Randall & Blackmore
for

Russell & Co. No. 604 Vessel.

180 lbs working pressure.

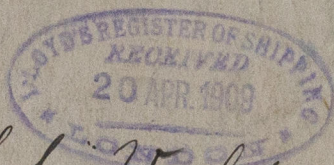

S.S. Valdura

Greenock

Report No. 15717

N.N. L. Hemplein

X1137-0041



© 2020

Lloyd's Register
Foundation



© 2020

Lloyd's Register
Foundation

W137-004