

27.5.09
17.6.09
29.6.09


LONGITUDINAL SECTION & DECK PLANS

S. S. N° 604

DIMS. 41'4" x 56'0" EXT x 55'9" MLD x 50'6" MLD.


TO CLASS 100 A.1. AT LLOYDS. SPECIAL SURVEY SPAR DECK RULE

SCALE 1/8" = 1 FOOT.

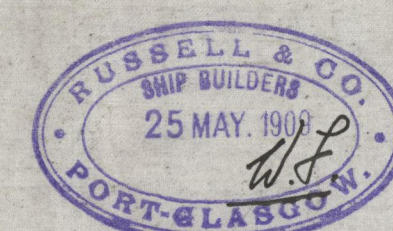

SKEEL FORWARD	12 1/2"
" " L. FORD	6 3/4"
SKEEL AFT	6 3/4"
" " L. AFT	3 1/2"
TONNAGE COEFF. ABOUT	.77
ROUND OF DECK	14"
PLAN OF GRADERS WILL BE SUBMITTED LATER.	

NOTE. THE SCANTLING & DETAILS OF CONSTRUCTION NOTED HEREON ARE SUBMITTED ON THE UNDERSTANDING THAT THEY ARE THE MINIMUM WHICH WILL BE ACCEPTED FOR CLASS. AND IF NOT THEY ARE TO BE AMENDED. ERRORS AND OMISSIONS EXCEPTED.

 

1137-0042

604

26K DECK



© 2020

Lloyd's Register
Foundation

Profile & Deck Plan


Russell & Co. S. S. No. 604

Valdura
St. Keddendale

Greenock Report. No. 15713

N.W. "Lillemsplein"

No 27 in List of
docks

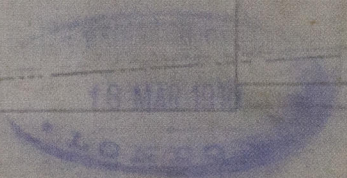

Lloyd's Register
Foundation