

# MIDSHIP SECTION S.S. No 604

DMS. 414' B.P. x 56' E. x 55' 9" MLD x 30' 6" MLD.  
To CLASS 100 A. I. AT LLOYDS. SPECIAL SURVEY. SPAR DECK RULE.  
Scale 1/2" = 1 Foot.

10.5.09  
27.5.09





Camber 14"

Camber 14"

Camber 14"

NUMERALS	
1/2 Beam	27.87
1/2 Girth	47.5
Depth	23.66
1st Numeral	99.03
Length	411.5
2nd Numeral	40750.8

PROPORTIONS	
DEPTHS TO LENGTH TO SPAIN DR.	12.49
" " " MAIN DR.	17.39
BEAMS TO LENGTH	7.38

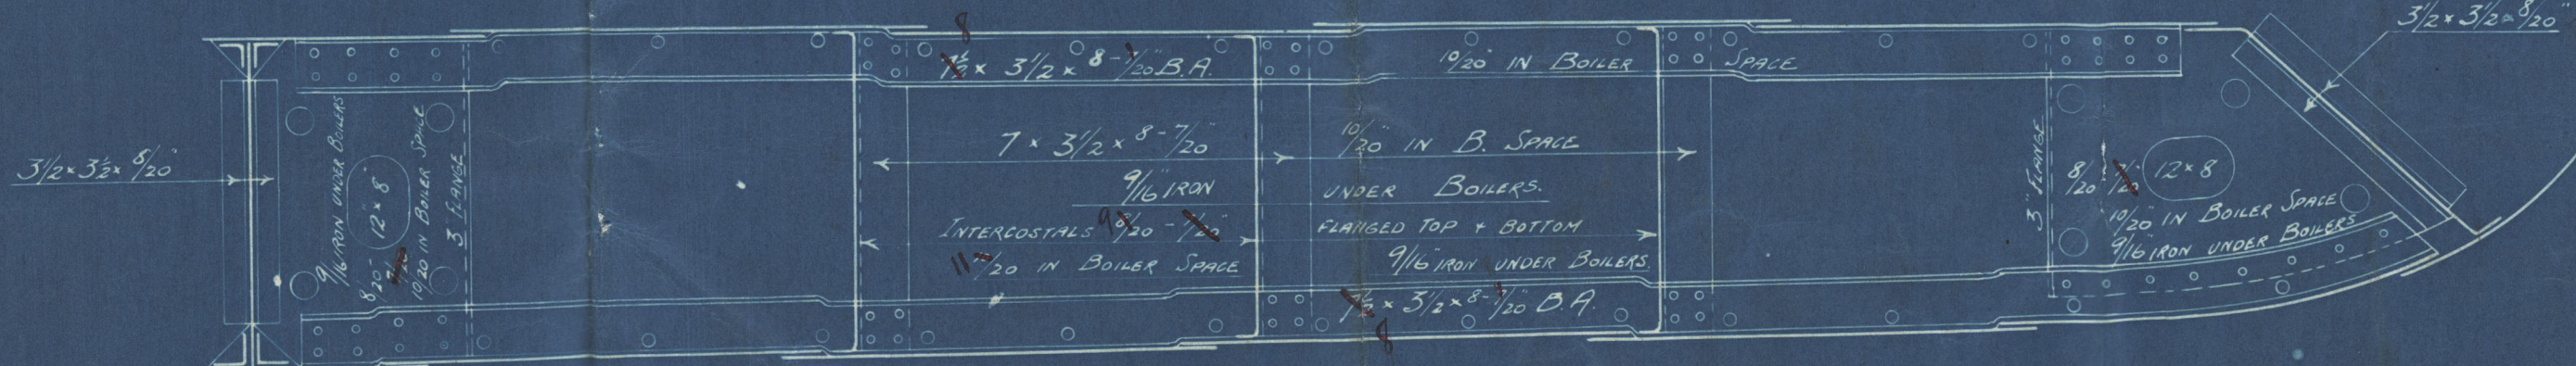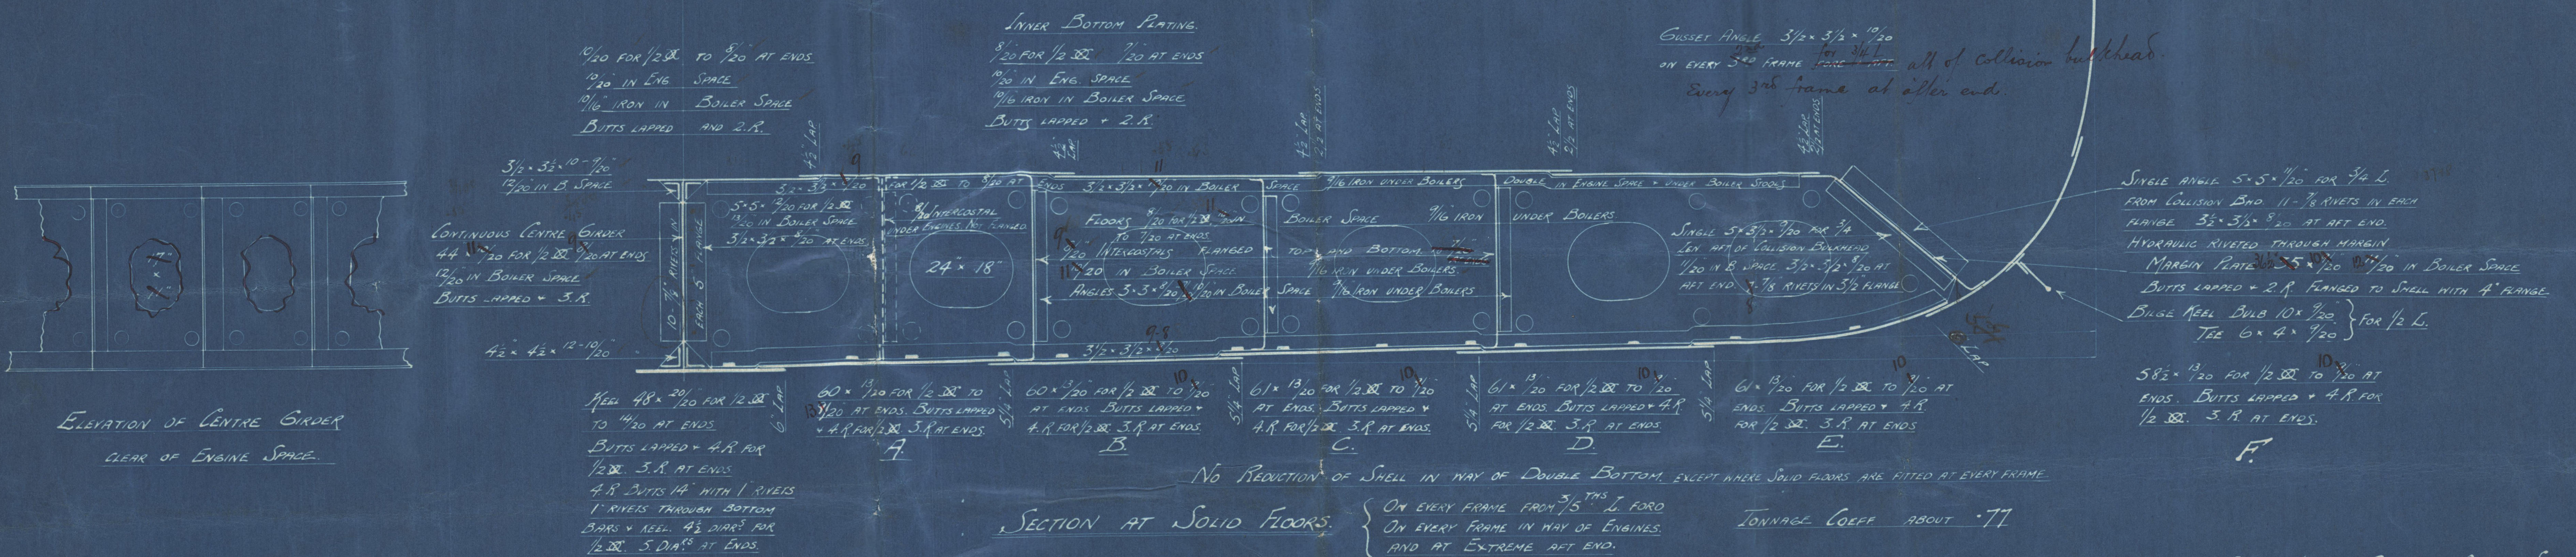

Lloyd's Register Foundation

16157-0043



W137-0043

604  
7077  
LLOYDS

OUTLINE SECTION

Outline Mid Section

Russell etc

S.S. No 604




Valdun

Greenock


N.N. "WILLEMSPLEIN"

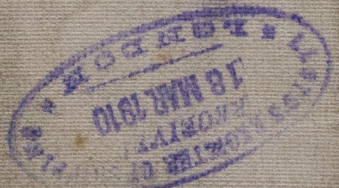

W137-0043

W137-0043



© 2020

Lloyd's Register Foundation