


adopted *JS*

Messrs. Russell & Co. No. 604
Midship Section on New Rules
Scale $1/2$ in = 1 foot.
414 ft. 0 x 55 ft. 9 x 30 ft. 6 mld.

29.6.09

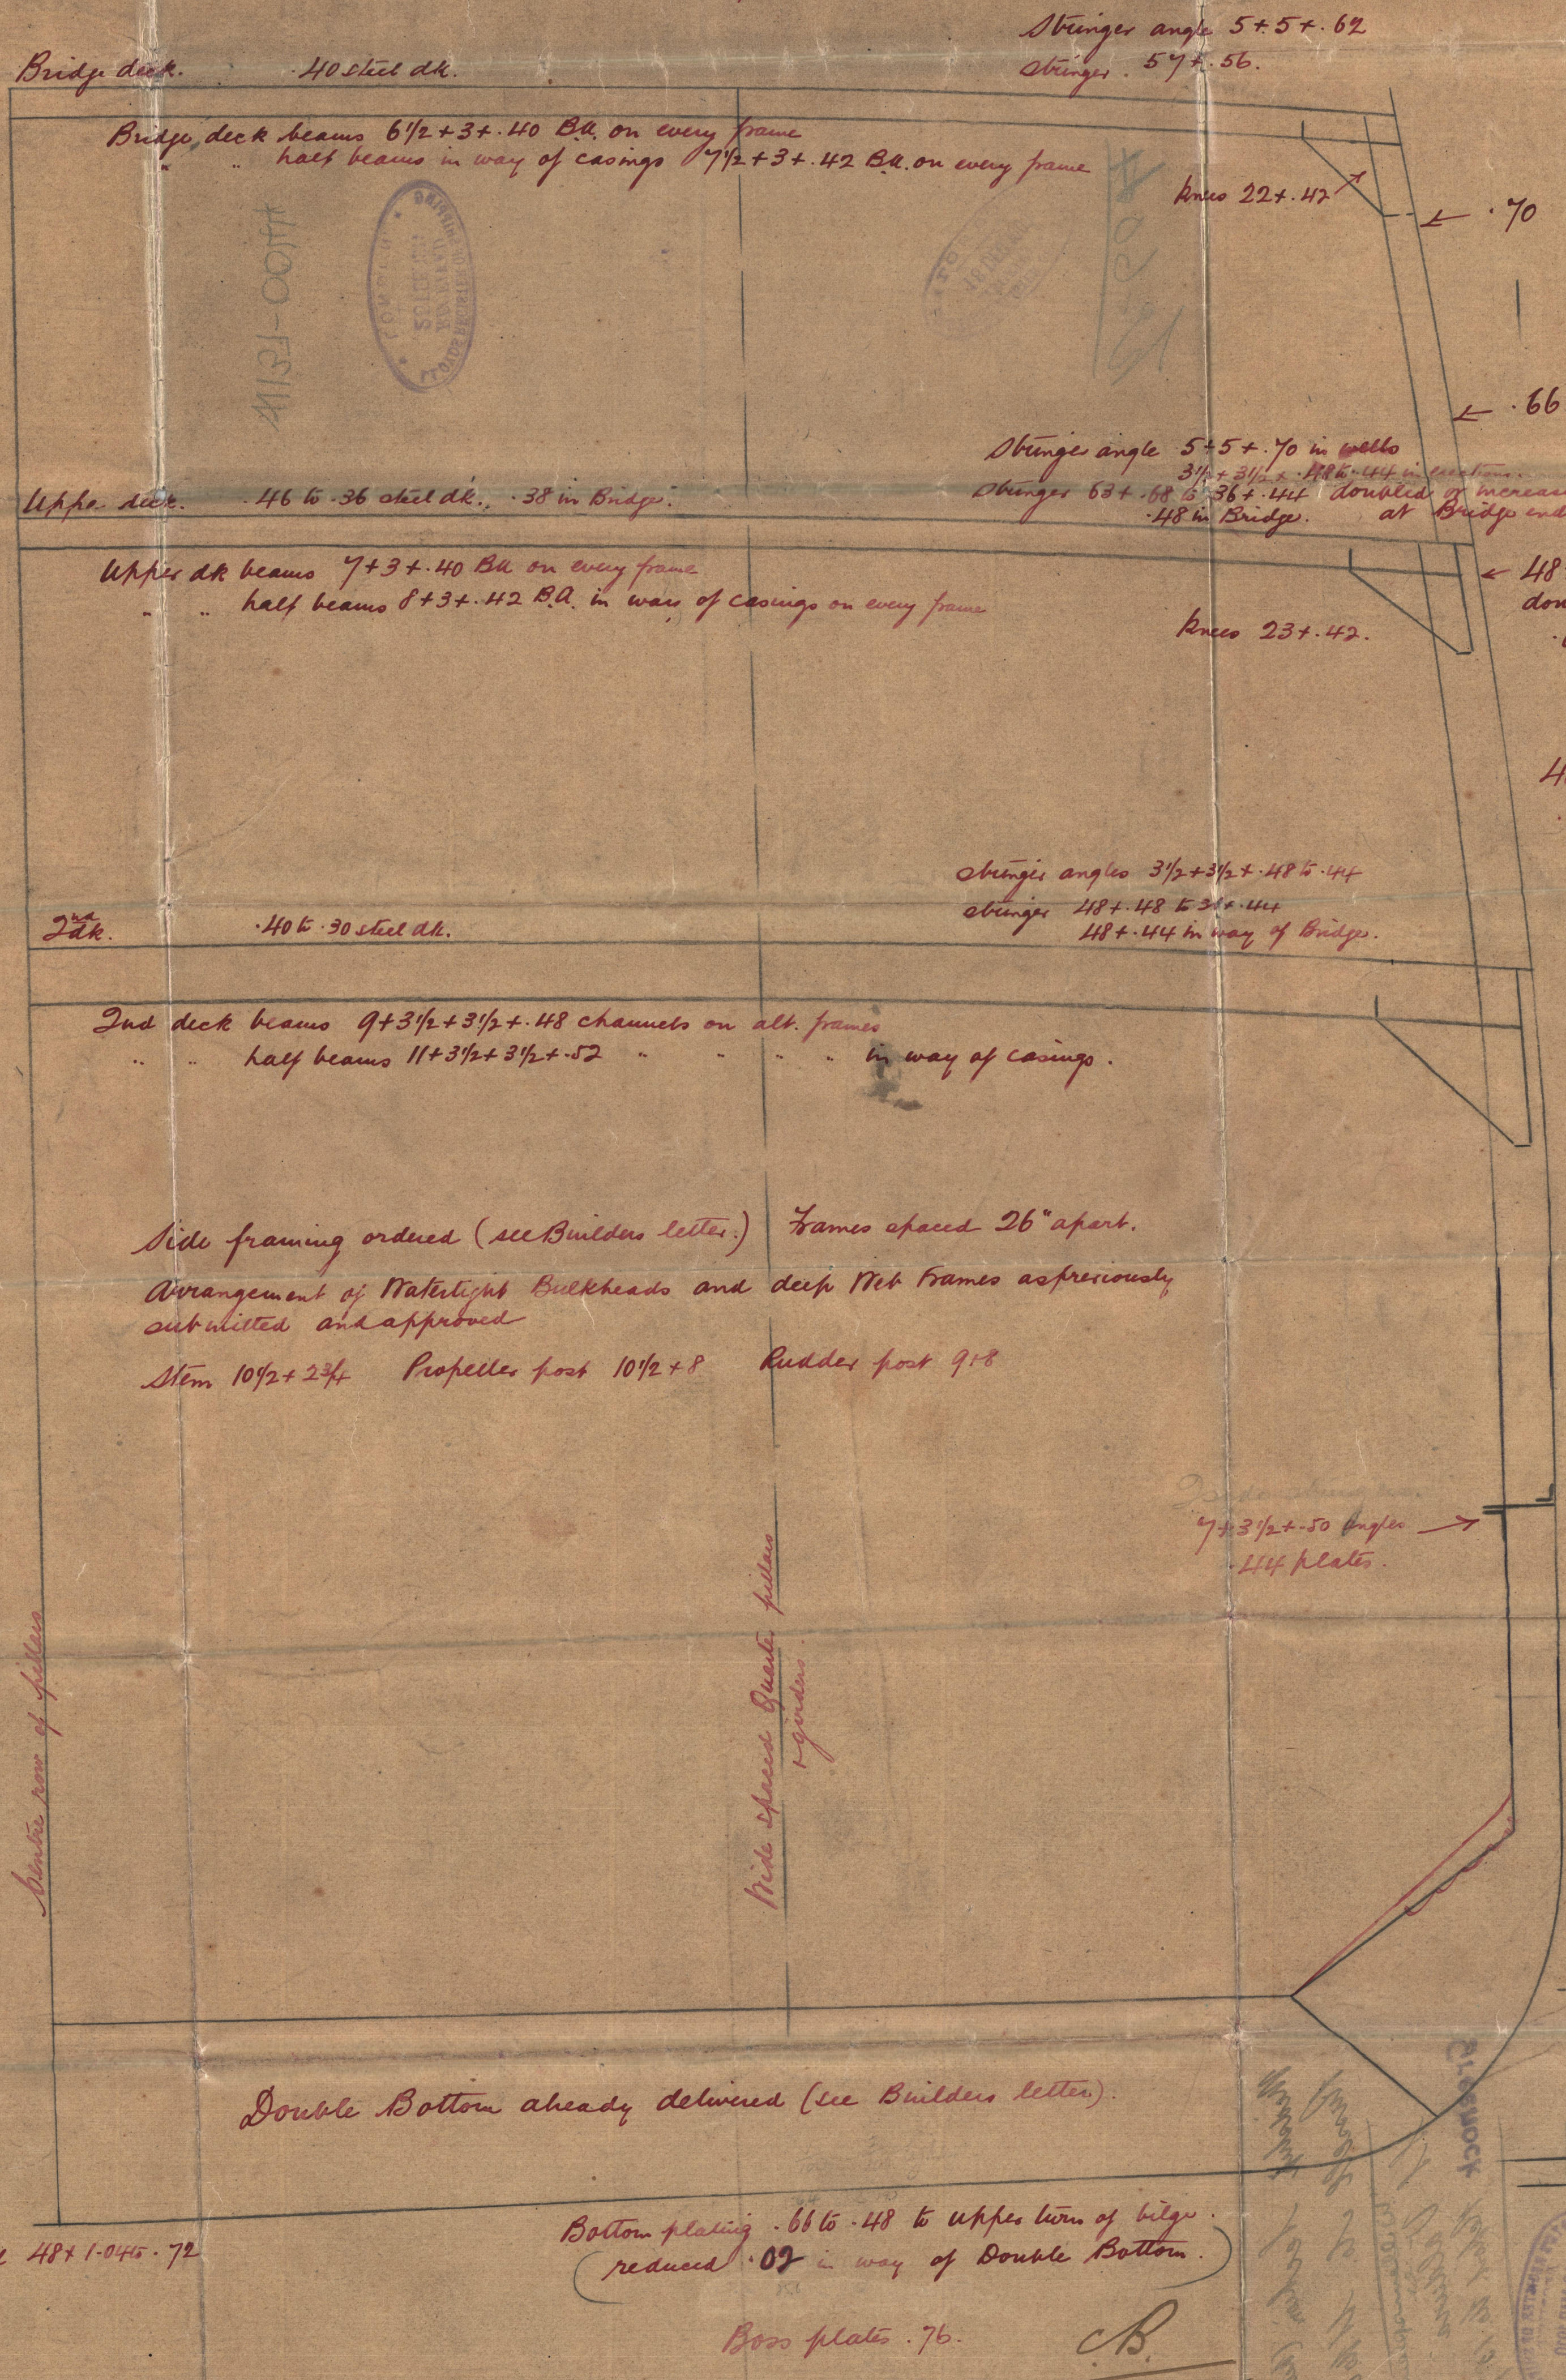

55 75
30
85 75
414
343 00
85 75
343 00
3550 08

1.08 see letter 27/7/09
48 + 1.06 to 46
doubled at bridge ends
.64 in way of bridge

Side plating .64 to .46
(frames spaced 24" apart in plates)

Bottom plating .66 to .48 to upper turn of bilge
(reduced .02 in way of Double Bottom)

Boos plates .76

C.B.
29.6.09

4131-0077

30.6
11.5
18.10
3-5
11-5

W137-0044

boy



© 2020


Lloyd's Register
Foundation

Midship Section (New Rules)

Russell Co. M. No 604.

Willemsplein.
St. Valdura

Greenock Report No. 15717

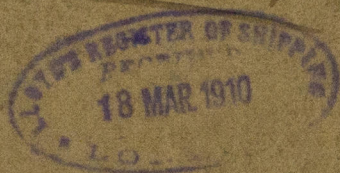

X1137-0044



© 2020

Lloyd's Register
Foundation