


N^o 546-
 PROFILE & DECK PLAN

DIMENSIONS III-3BP x 22-6 EX x 12-10 MDL

SCALE $\frac{1}{4}$ " = 1' I

SEE SECTION FOR SCANTLINGS

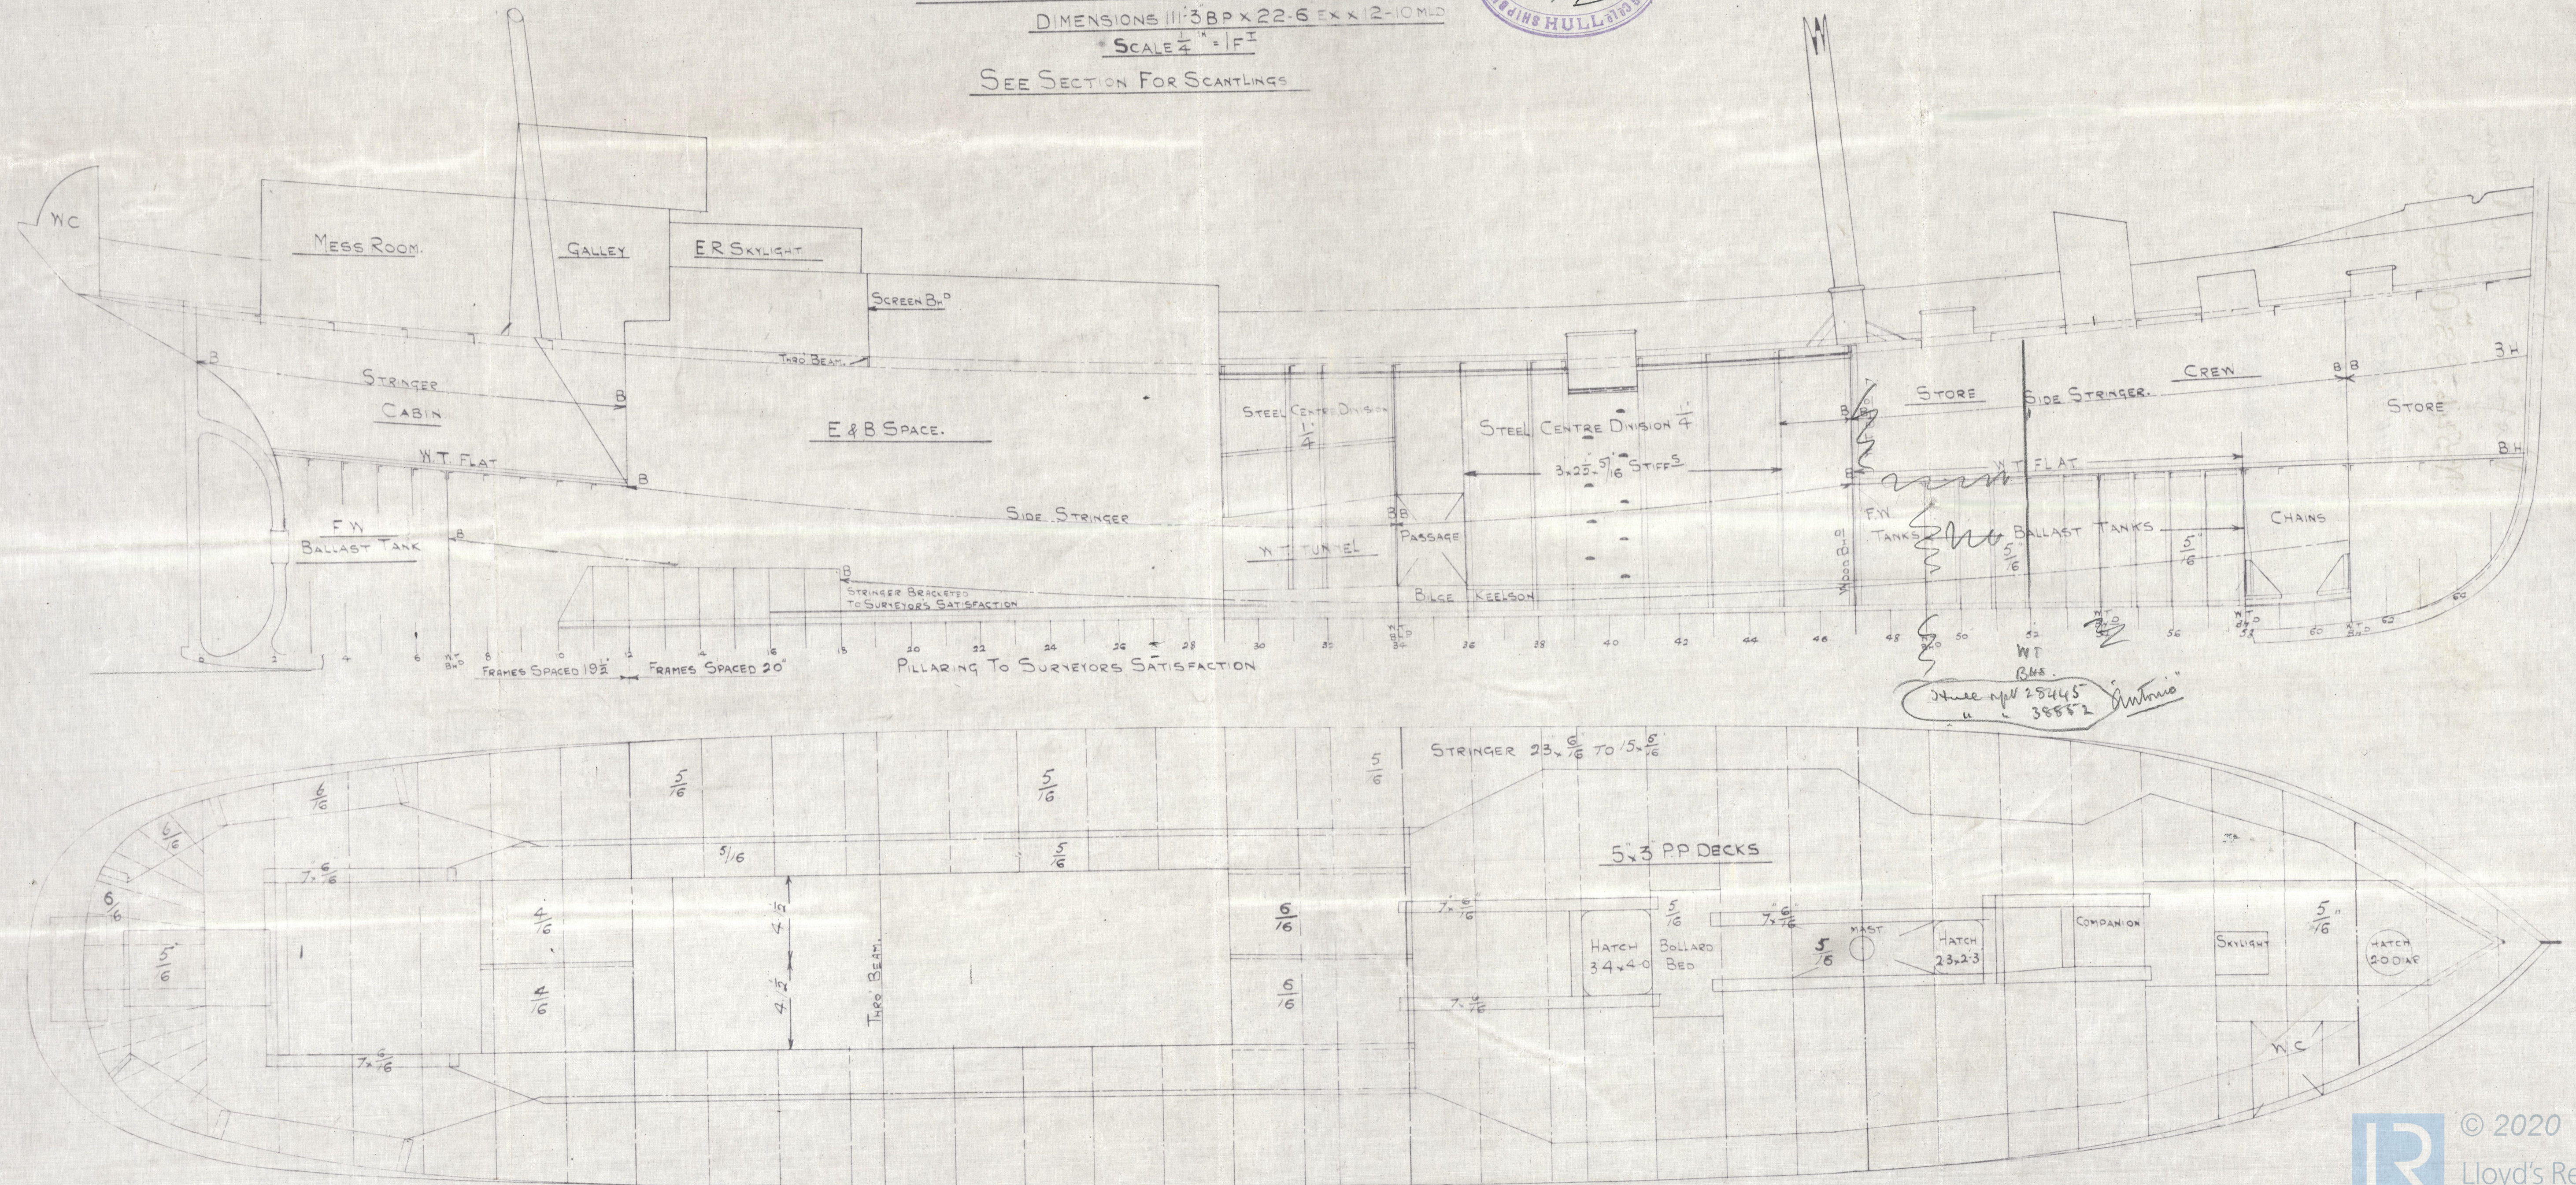

Earles Co

N^{os} 545, 546, 544, 548

Duplicate

Profile & Deck Plan.

N^o 546. S.S. Antonio.

Hull Report No. 20. 422

N.W. "Whinny fold"

W137-0093



© 2020

Lloyd's Register
Foundation