

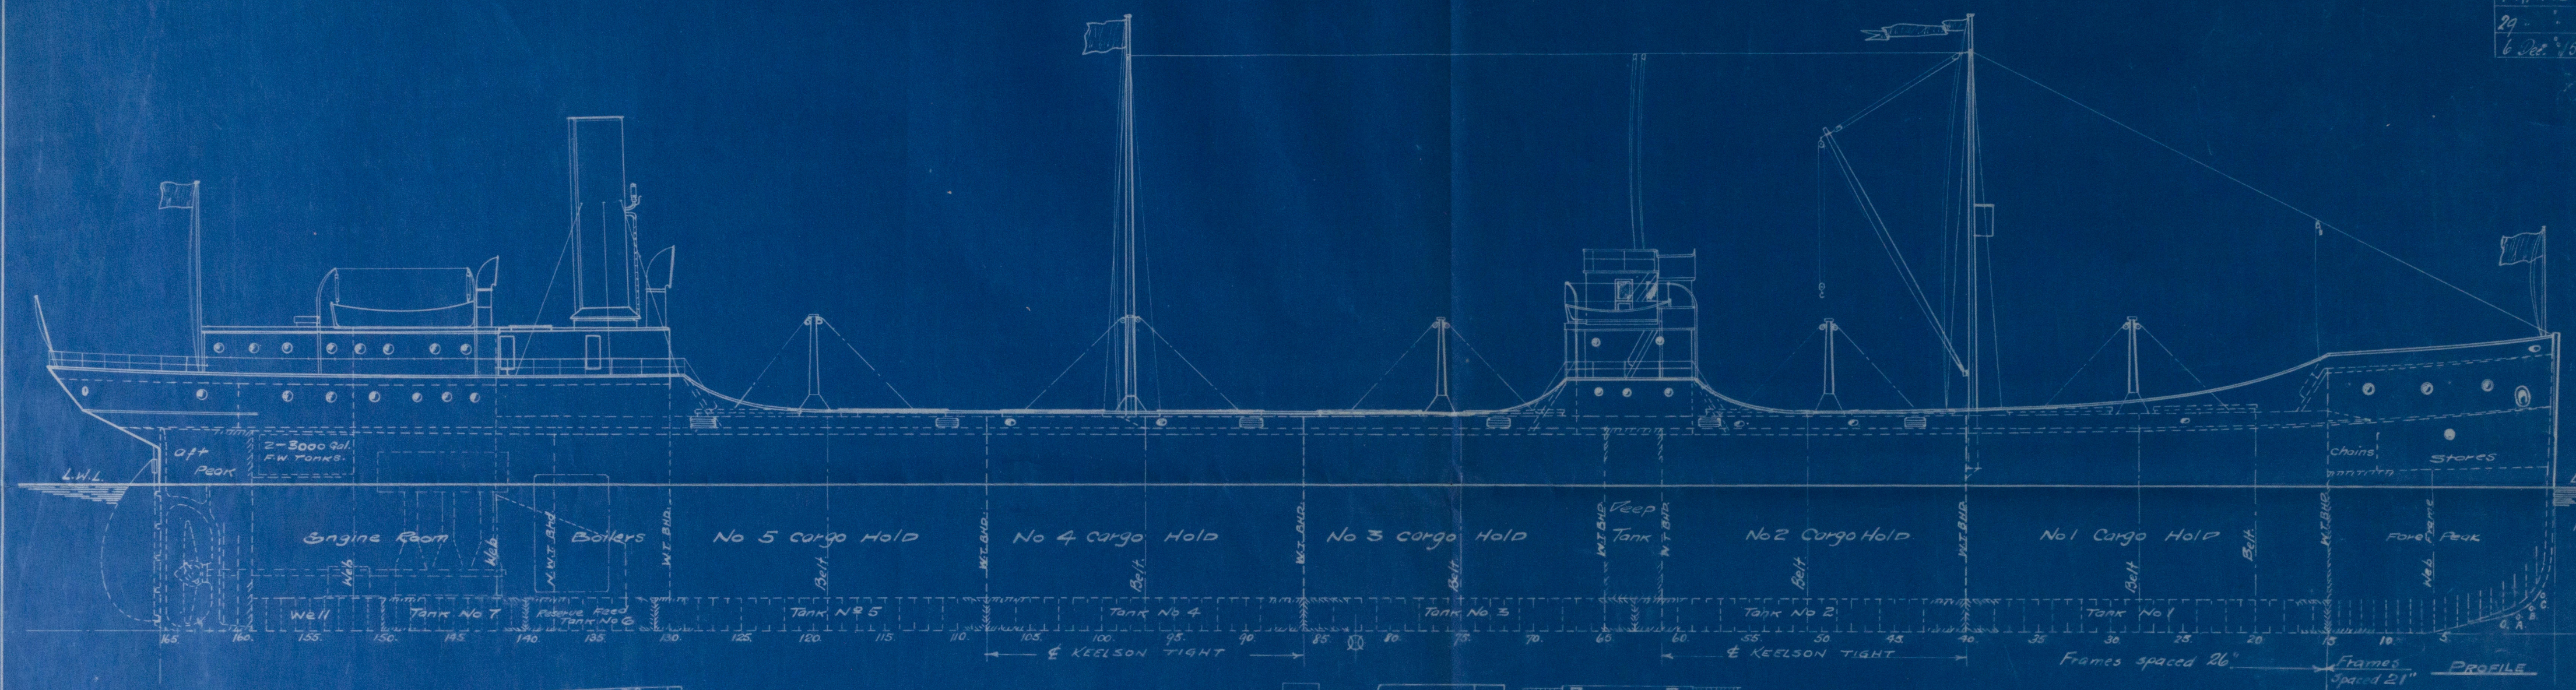
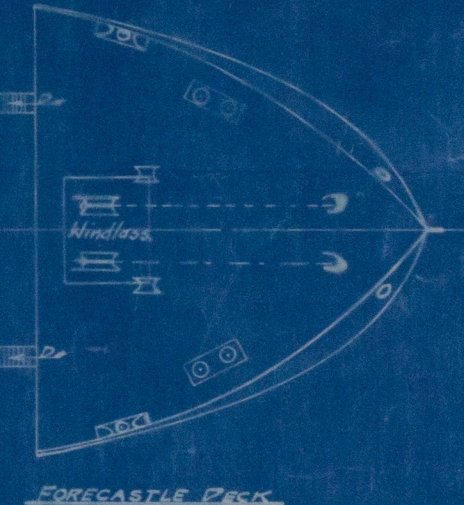



DATE	ALTERATION
1 Apr. 15	Fore Peak Panting note amplified
29 "	Frame Spacing in Fore peak changed. B
6 Dec. 15	Hospital Addition. Lamp Room. S. corrected.

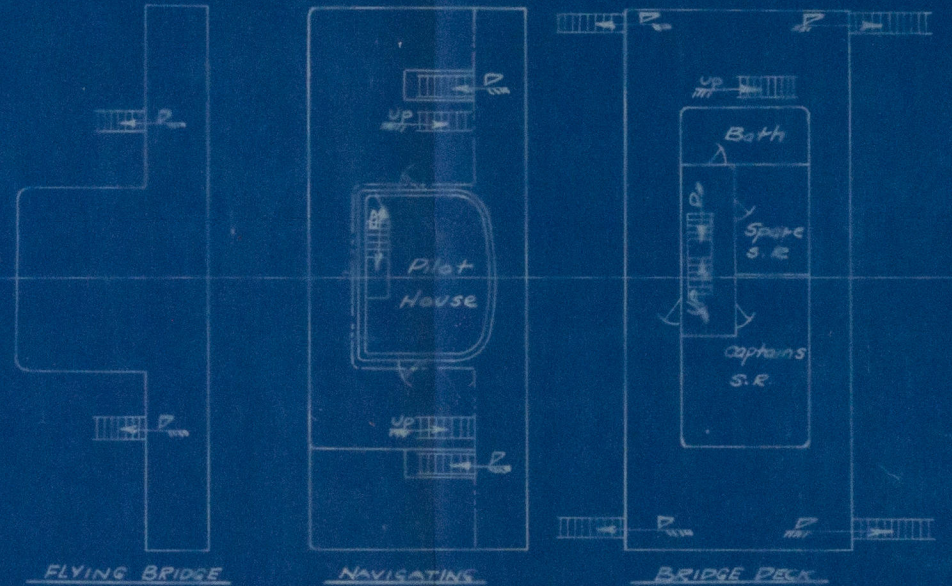

Plan of Panting Arrangements to be Submitted.

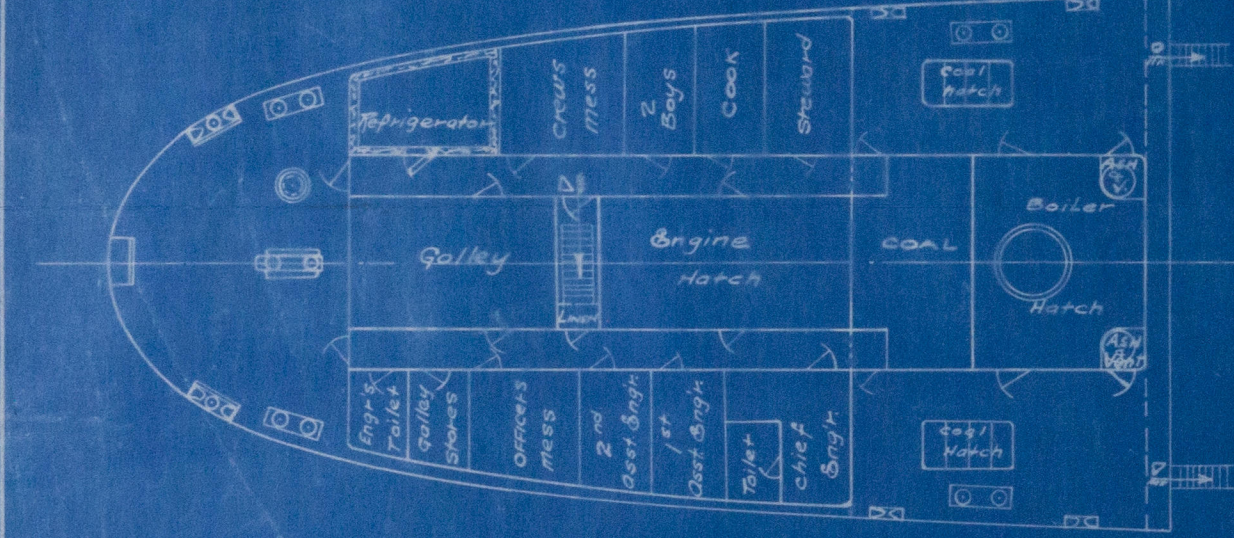

- 35 51 1
- 36 PIERCE
- 7 May 15
- 37 M 1
- 176 15
- 38 MAIL
- 6 D 15
- 39 52 1
- 10 D 15
- 40 41 MAIL 2
- 17 15
- 42 43 LLOYDS 2
- 16 M 16

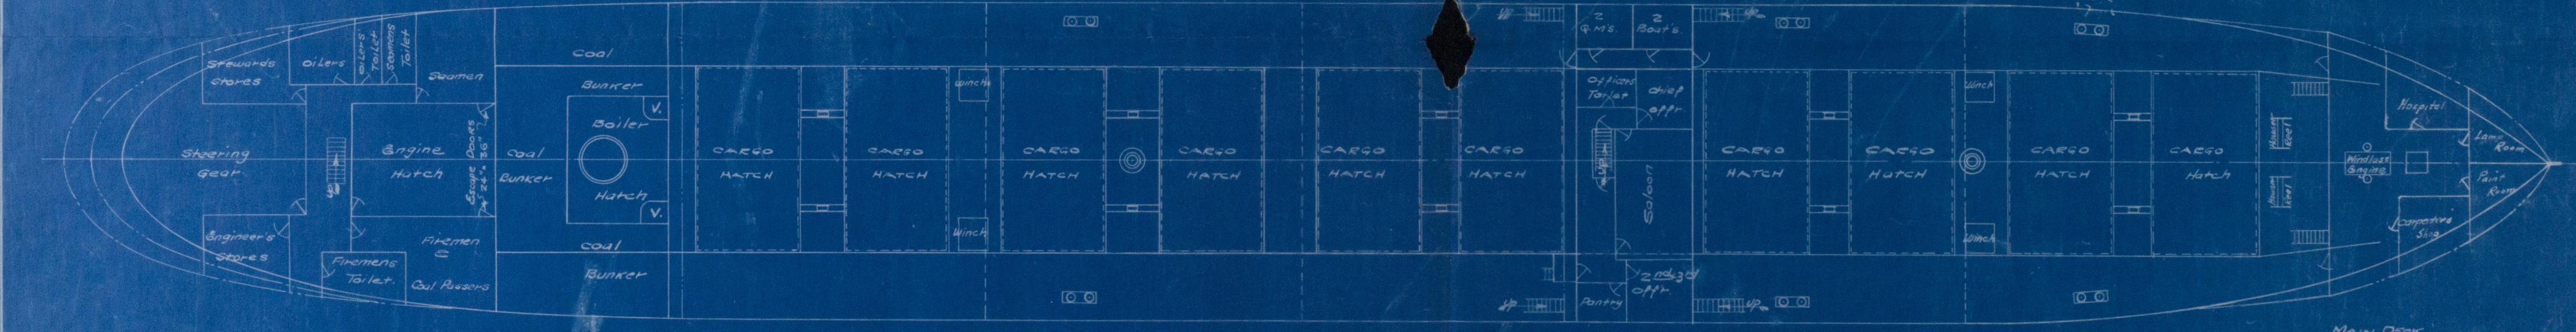


- 19 LIB 1
- 20 21 M 10 2
- 22 23 S 10 2
- 24 25 2
- 26 L 15 1
- 27 51 1
- 28 5 1
- 29 S-B 1
- 30 INS 1
- 31 5 1
- 32 24 1
- 33 24 1
360'-0" x 49'-0" x 30'-0" MLD
 SINGLE SCREW STEEL COLLIER
 SCALE 1/8" = 1 FT.
 MADE BY QUINCY
 DATE 17 MR. 15
 NEW YORK SHIPBUILDING CO.
 CAMDEN, N.J. U.S.A.
 DR No 169-202-A.
 16 R. Perry NAVAL ARCHITECT

W37-0132

NEW YORK SHIPBUILDING CO.
CAMDEN, N.J., U.S.A.
BLUE PRINT ROOM
Print No. 43
Made MAY 16 1916
For Don't LK0103

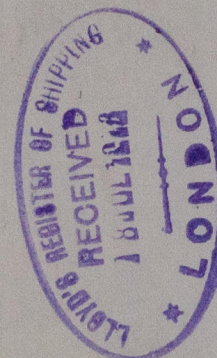

W137-0132

Profile.

William H. Mackay

PLD. 2389.

W1137-0132



© 2020

Lloyd's Register
Foundation