

19 L.B. 1
20-21 M-10 2 1-2 M 2
22-23 S 10 2
24-25 9 2 16-MR-15
26 L.S. 1 1 L.B. 1
27 J. 1 2-3 M-10 2
28 S. 1 4-5 S 10 2
2 A.P. 15 6-7 S 2
3 S.B. 1 8 L.S. 1
4 A.P. 15 9 S. 1
5 A.P. 15 10 2W. 1
30 INSP. 1 22-MR-15
6 A.P. 15 11-12 S 2
31 S. 1 23-MR-15
7 A.P. 15 13-14 LLOYDS
32 2W. 1 25-MR-15
8 A.P. 15 27-MR-15
33-34 AMERICAN 17-18 LLOYDS
BUREAU 27-MR-15

360'-0" x 49'-0" x 30'-0" MLD
SINGLE CROSS STEEL COLLIER
SCALE $\frac{1}{8}" = 1' FT.$
MADE BY QUAK DATE 17 MR '15
NEW YORK SHIPBUILDING CO.
CAMDEN, N.Y. U.S.A.
DR. N. 169-202-A.
E. J. Origg NAVAL ARCHITECT

UK 137-0133

NEW YORK SHIPBUILDING CO.
CAMDEN, N. J., U. S. A.
BLUE PRINT ROOM
Print No. 48
Made MAY 16 1916
For Dept. Levy
W137-0133




© 2020
Lloyd's Register
Foundation

Profile
New York 1916

N. 169


Thurs N 2389

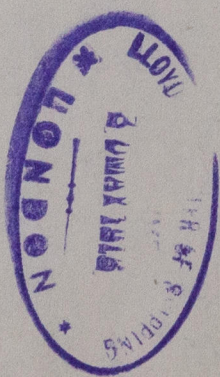

N. William H. Macken

W137-0133