


11.6.27  
RILEY BROS BOILERMAKERS LTD

LLOYDS & DUTCH LAW SURVEYS FOR 145 LBS W.P.  
SCALES 1" = 1' 2 1/2" = 1 FOOT.

5752

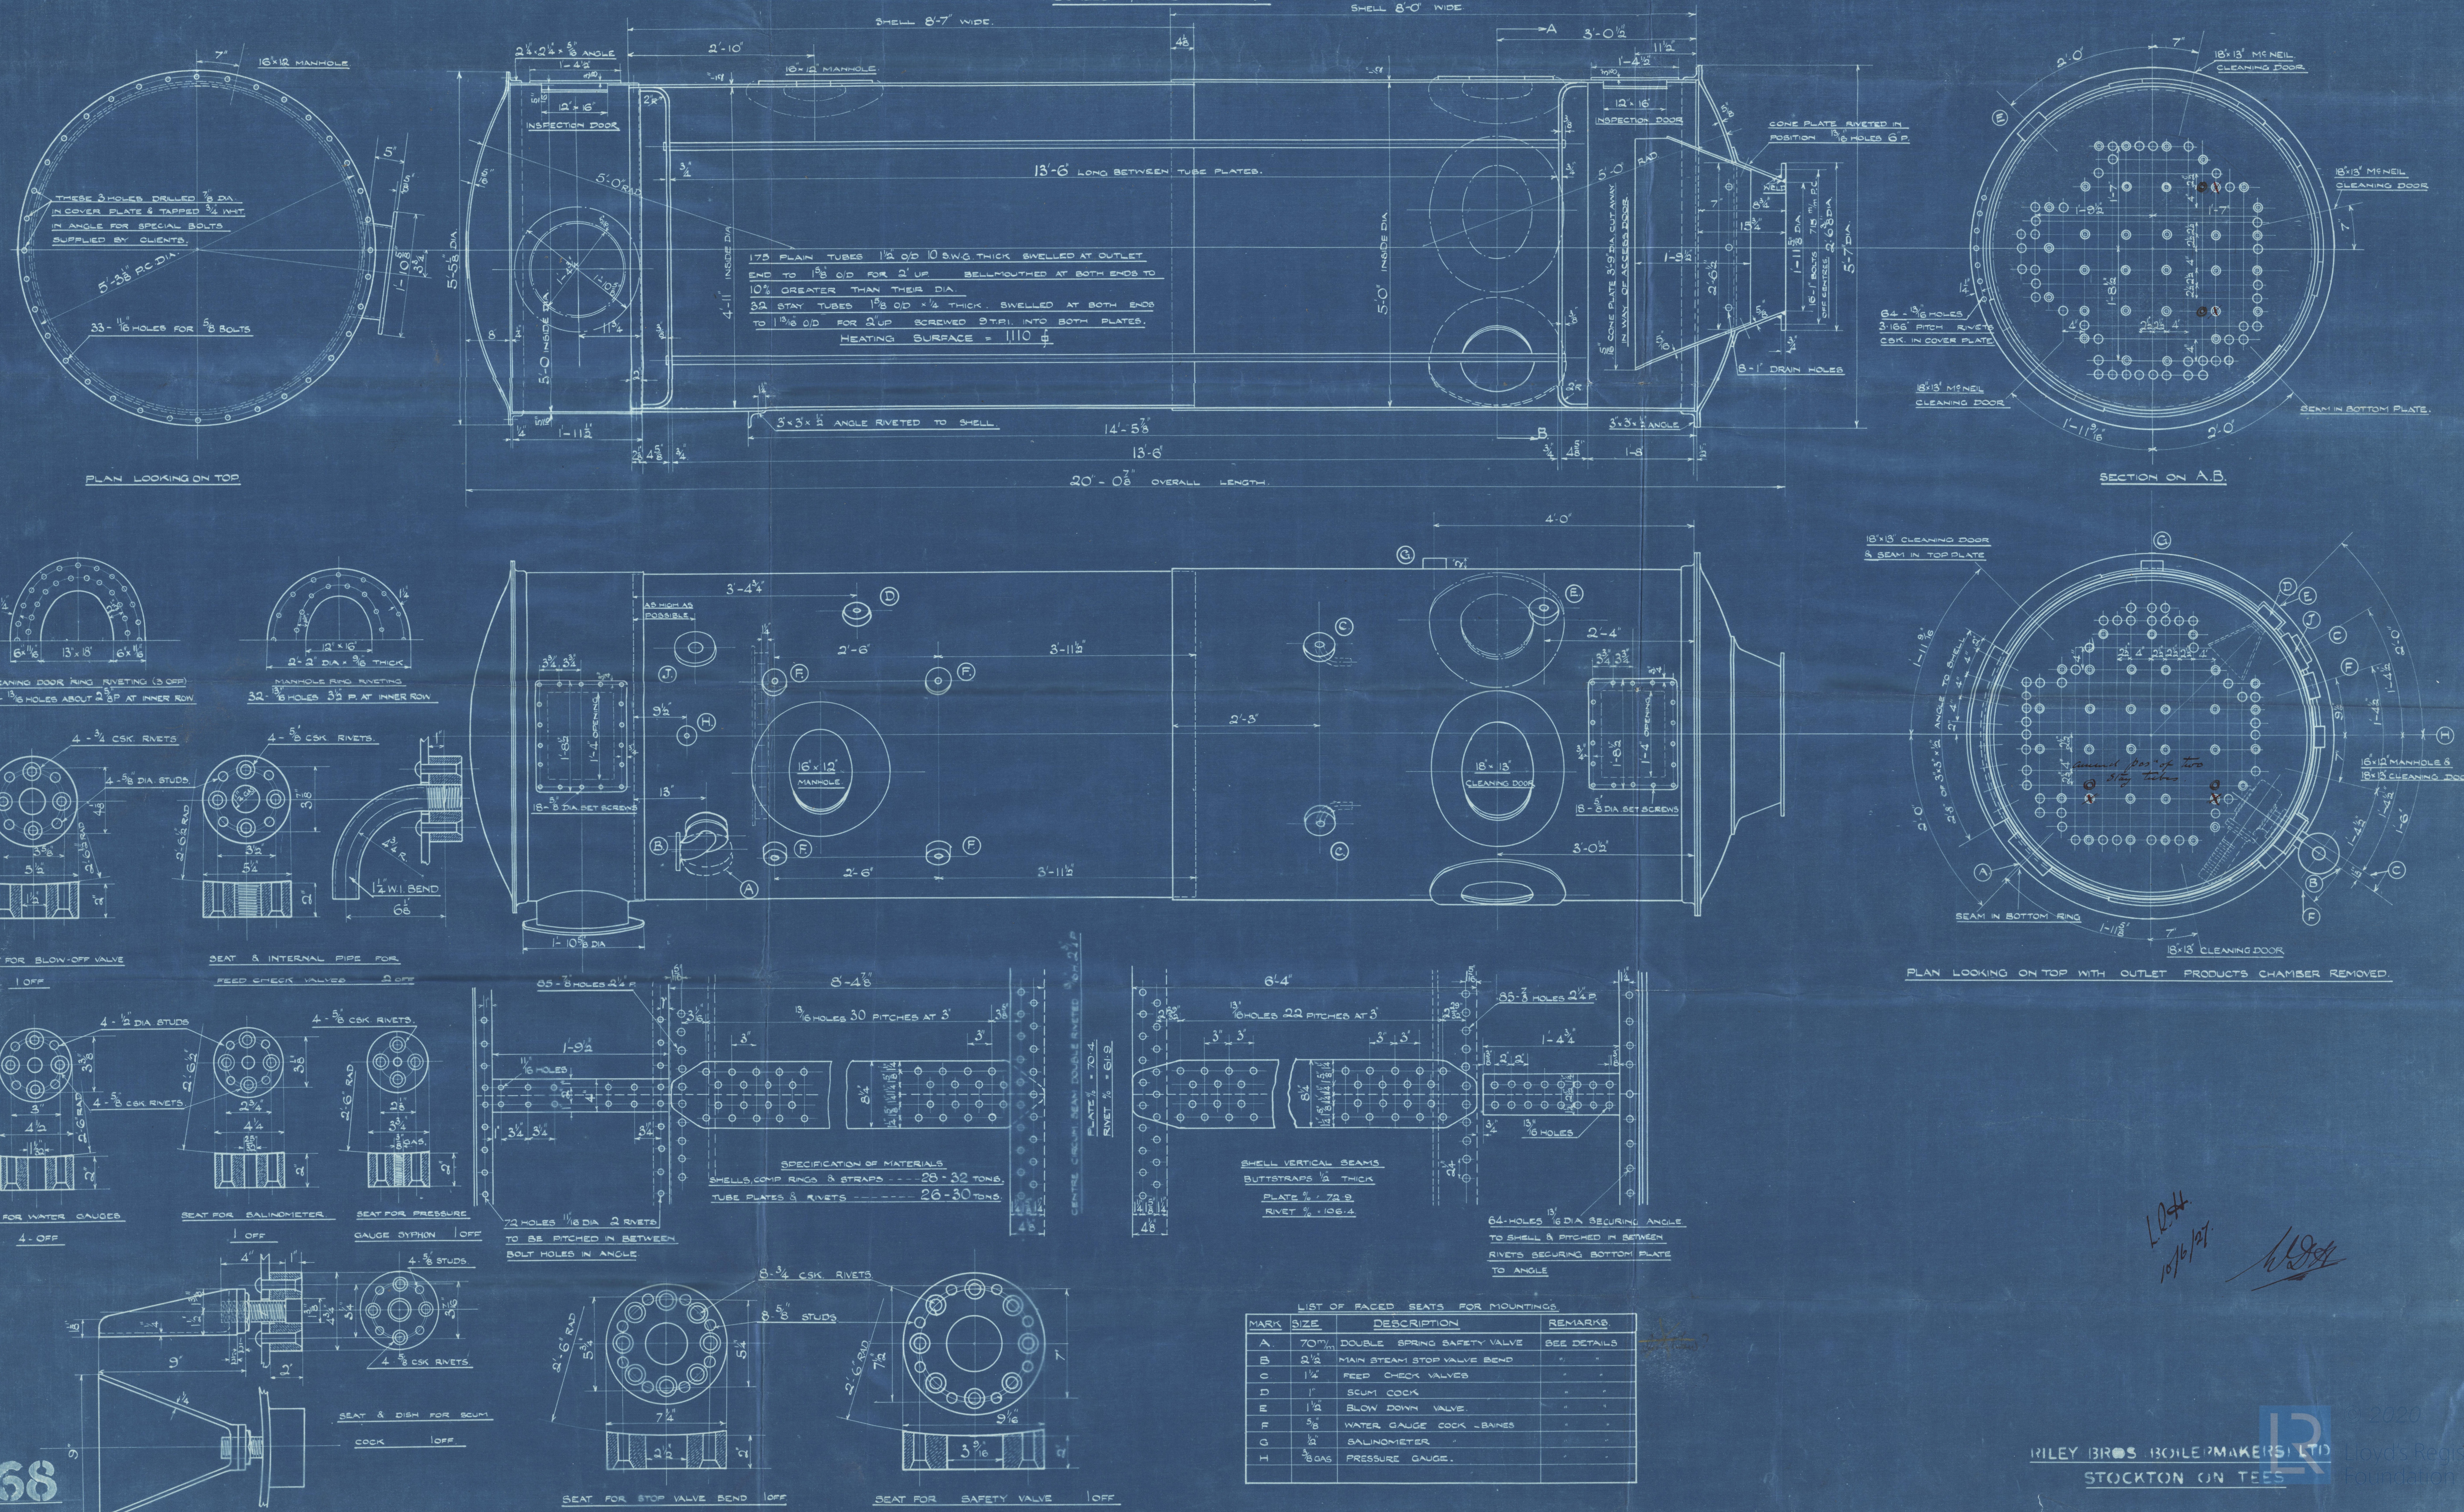



RILEY BROS

No 5752.

SPENCER. BONECOURT

BoILER

For

m. v. 'WOENSDRECHT'



MDR. RPT. No. 12992

BoILER No 5752

No. 6560
LLOYD'S TEST.
268 lbs.
WP 145 lbs.
26.727 PTB.



© 2020

Lloyd's Register  
Foundation

W137-0168