

SCALE 1 INCH = 1 FOOT

— <u>HEATING SURFACE</u> —	— <u>SQ.FEET</u> —
<u>TUBES</u>	<u>850.83</u>
<u>FURNACES</u>	<u>66.3</u>
<u>COMB. CHAMBERS</u>	<u>110.65</u>
<u>TUBE PLATES</u>	<u>42.6</u>
<u>TOTAL</u>	<u>1070.38</u>
<u>GRATE SURFACE</u> <i>3.07 sq. ft.</i>	<u>32.08</u> ^{<i>sq. ft.</i>}
<u>RATIO</u> $\frac{48}{65} = \frac{33.4}{52}$	

—CONTRACT N^{OS} 124—

1890

1 1/2 STAYS 1.5 EFFECTIVE AREA RIVETED
OUTSIDE SHELL NOT INSIDE COMB. CHAMBER

CONTRACT N^{OS} 124-


~~WAAAAA WAAAAA WAAAAA~~
~~WAAAAA WAAAAA WAAAAA~~

Smiths Dock Lrs 5/4/34

Meredith & Pollard C 124
(see next p 49)

No. _____
Lloyds Test
360. lbs.
11/12/03
ab

31/8/03

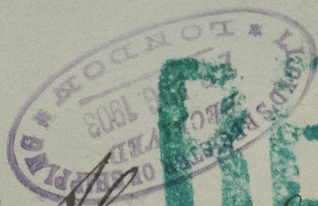

RETAIN

Of Alexandra
Old. mch. J.E. 21718
New. J.E. No. 46834

W1370-0151 2 1/2



© 2020

Lloyd's Register
Foundation