


26.11.10
31.12.10
28.1.11

SHARP, BROTHERS & CO. LTD.
ENGINEERS & BUILDERS
219/141 C.F.S.
VICTORIA SHIPYARD, 1001 E.

— S. S. Nos 141 & 142. —
— LONGITUDINAL SECTION. —
— DIMS: 100'-0" B.P. x 23'-0" EX. x 11'-0" MLD. —
SCALE 1/4" IN. = 1 FT.

26.11.10
31.12.10
28.1.11

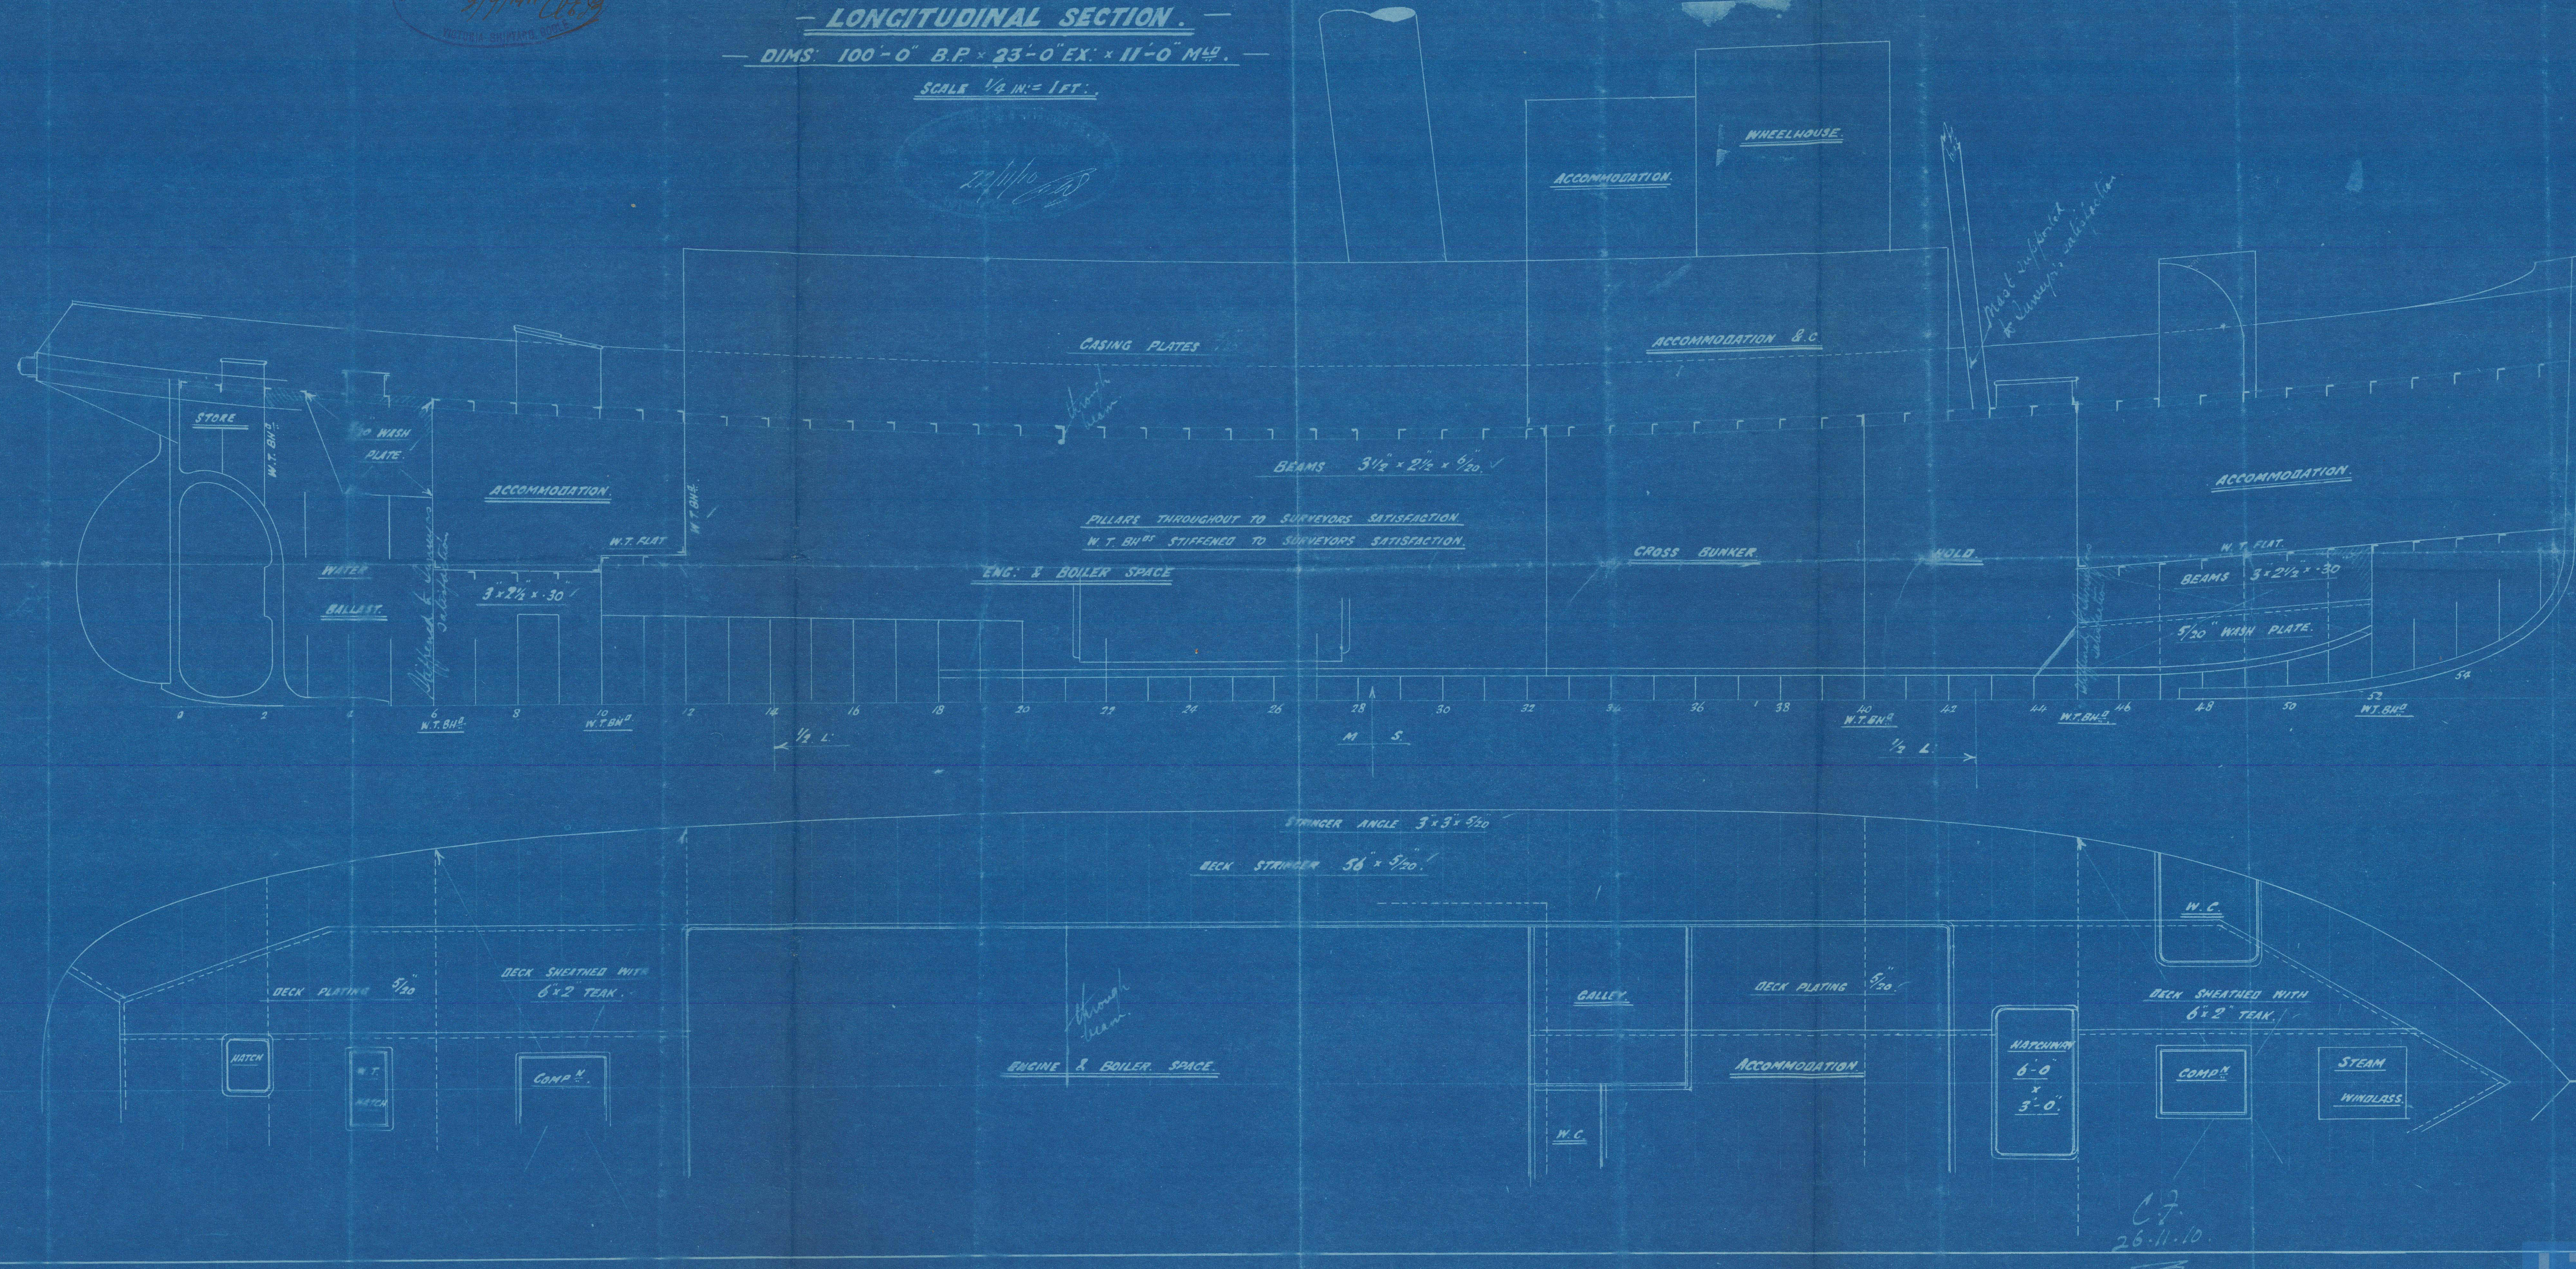

Good S. & R. Co. Ltd.

Nº 141 - 142

Profile & Decks

s/s Moreno Hull Rpl. No. 24207
- Alvar - - 24326



© 2021

Lloyd's Register
Foundation

W1371-0074