

No 141-2.

Numeral.

26-11-10 23.9 + 11-0 = 33.9 Transverse No.
21-12-10 33.9 x 100 = 3390 Longitudinal No.
28-1-11

L/D = 9.09

Midship Section

Steel Screw Tugs.


Dims: 100'-0" x 23'-0" x 11'-0"

Scale 1/2" = 1 Foot.

Equipment.

1 Anchor	4 3/4" cuts or stock.
1 "	4 1/4" " " "
1 "	2 1/2 " " "
90 Fathoms	15/16" Stud Link chain
60	5/8" Hawser
60	4" Warp

To Class - A1. Lloyds. (Coasting Tug.)

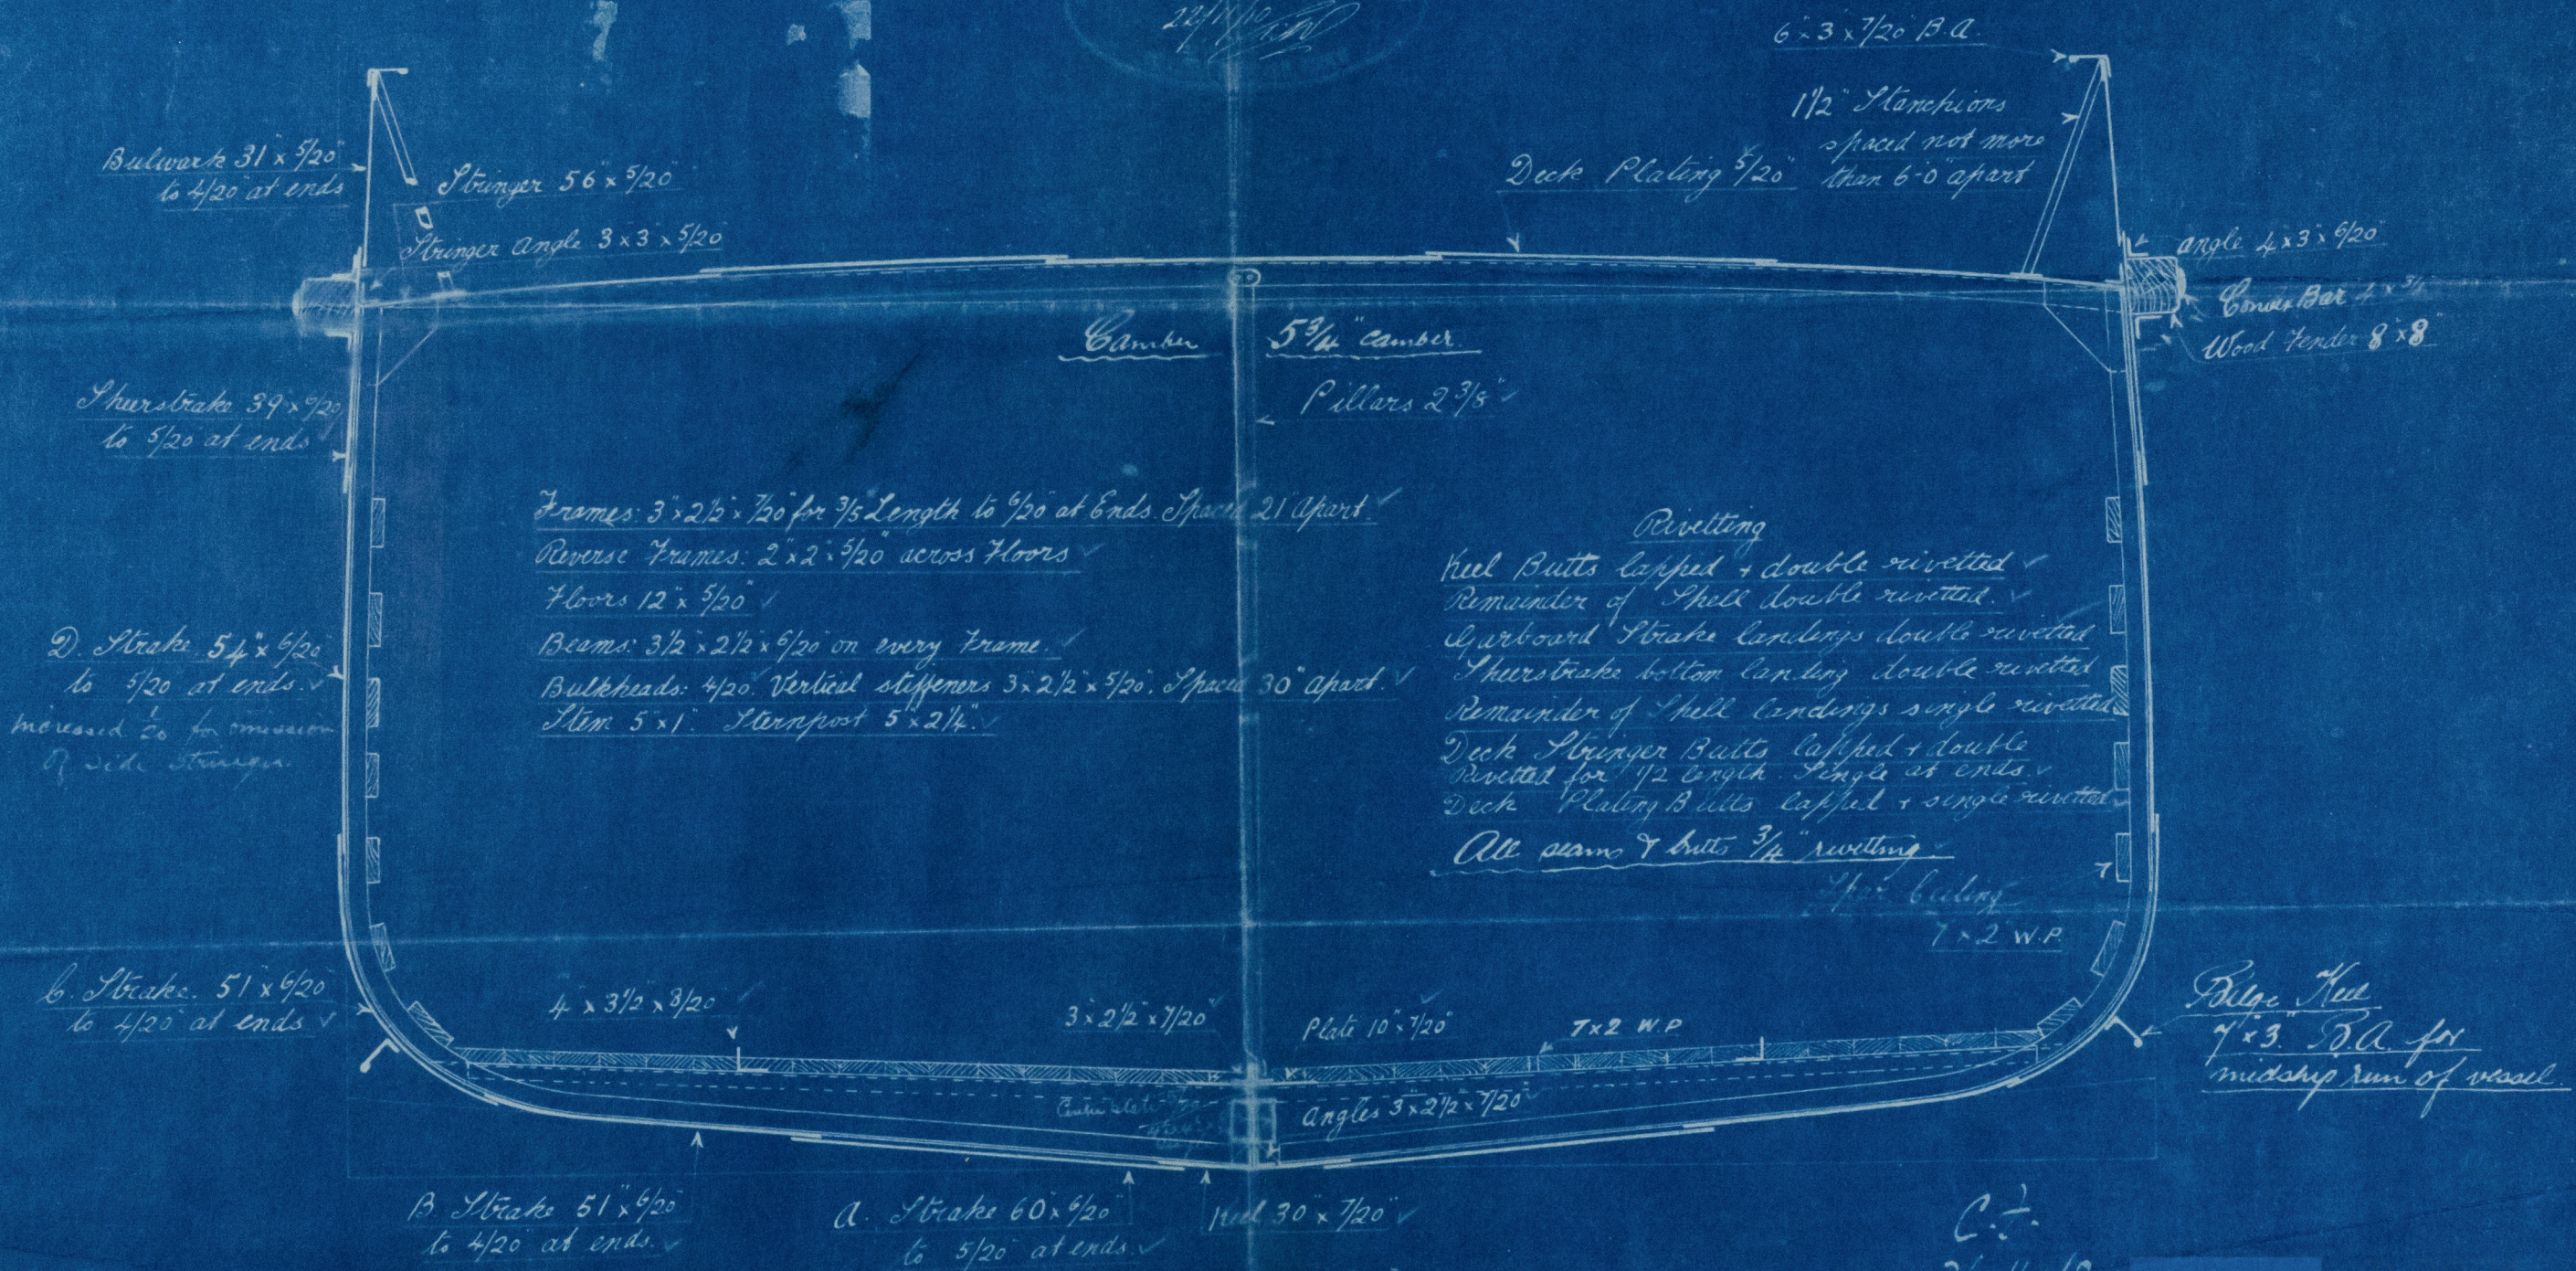

C.F.
26-11-10



Goole S. + R.C. Ltd
Nos 141 - 142.

Duplicate
Midship Section

1/2 Moreno Hull Rpt No 24207

Alwear - - - 24326

WATER



© 2021

Lloyd's Register
Foundation

W1371-0075