



STEEL SCREW TUG



75'-0" BP x 21'-0" mld x 10'-2" mld.

SCALE $\frac{3}{8}$ " = 1 FOOT

TO CLASS 100 A.1. LLOYD'S TOWING PROCESS.

Builder Messrs Cochrane, Selby.

13.6.10

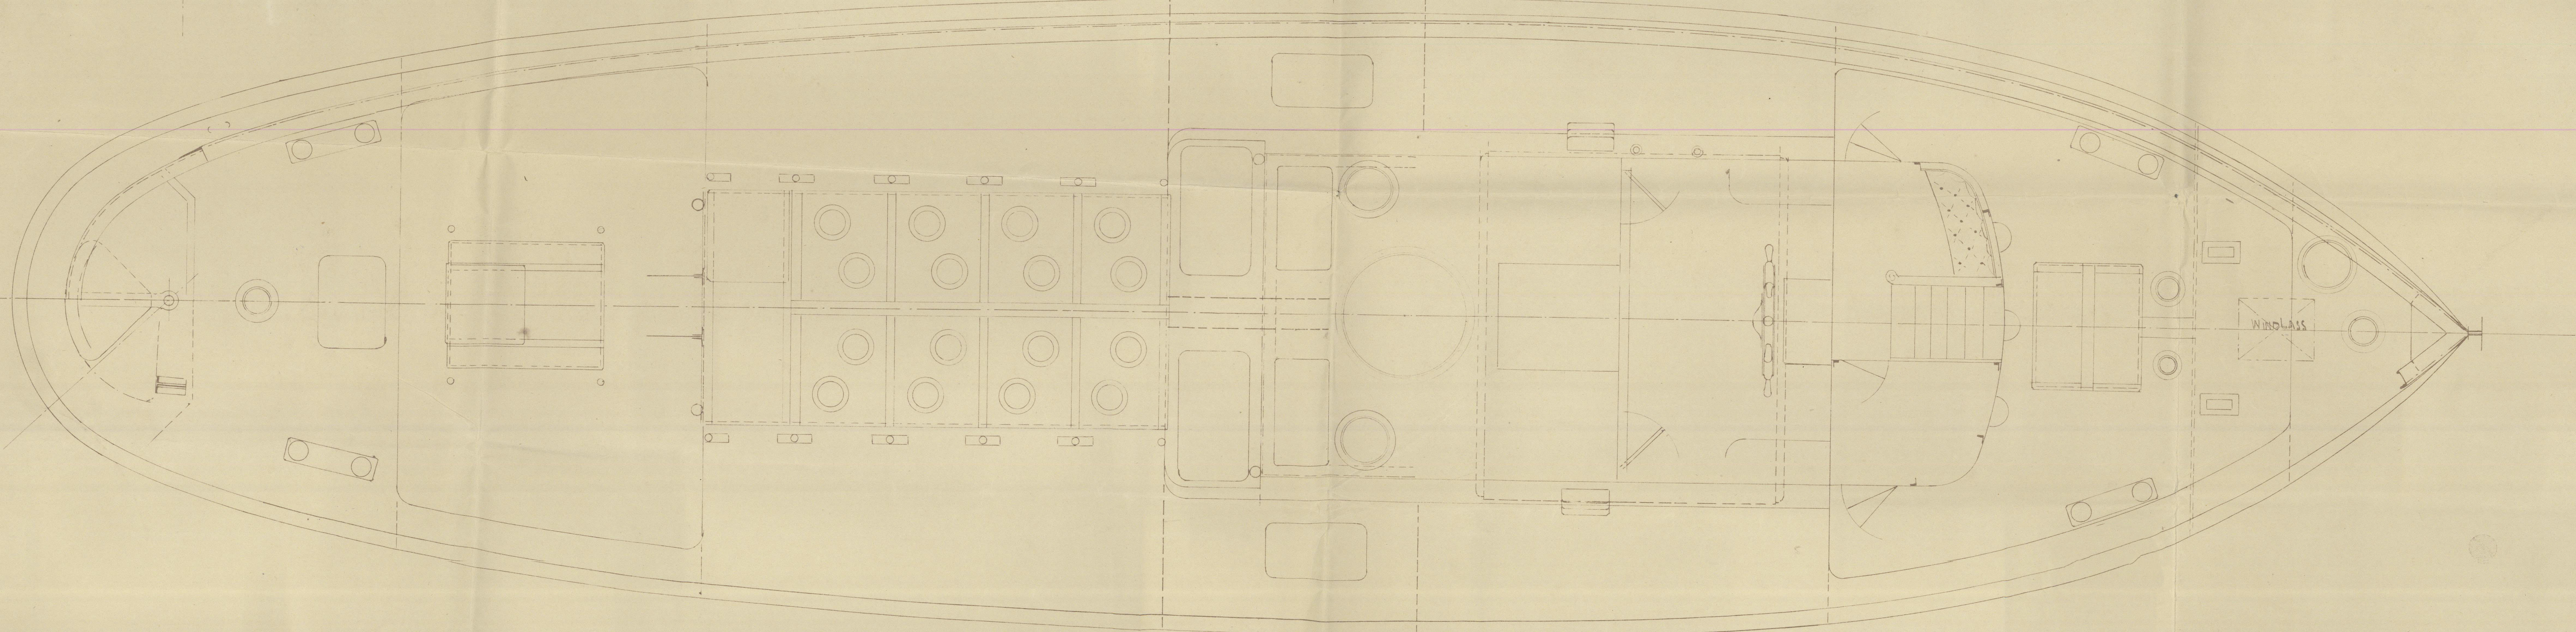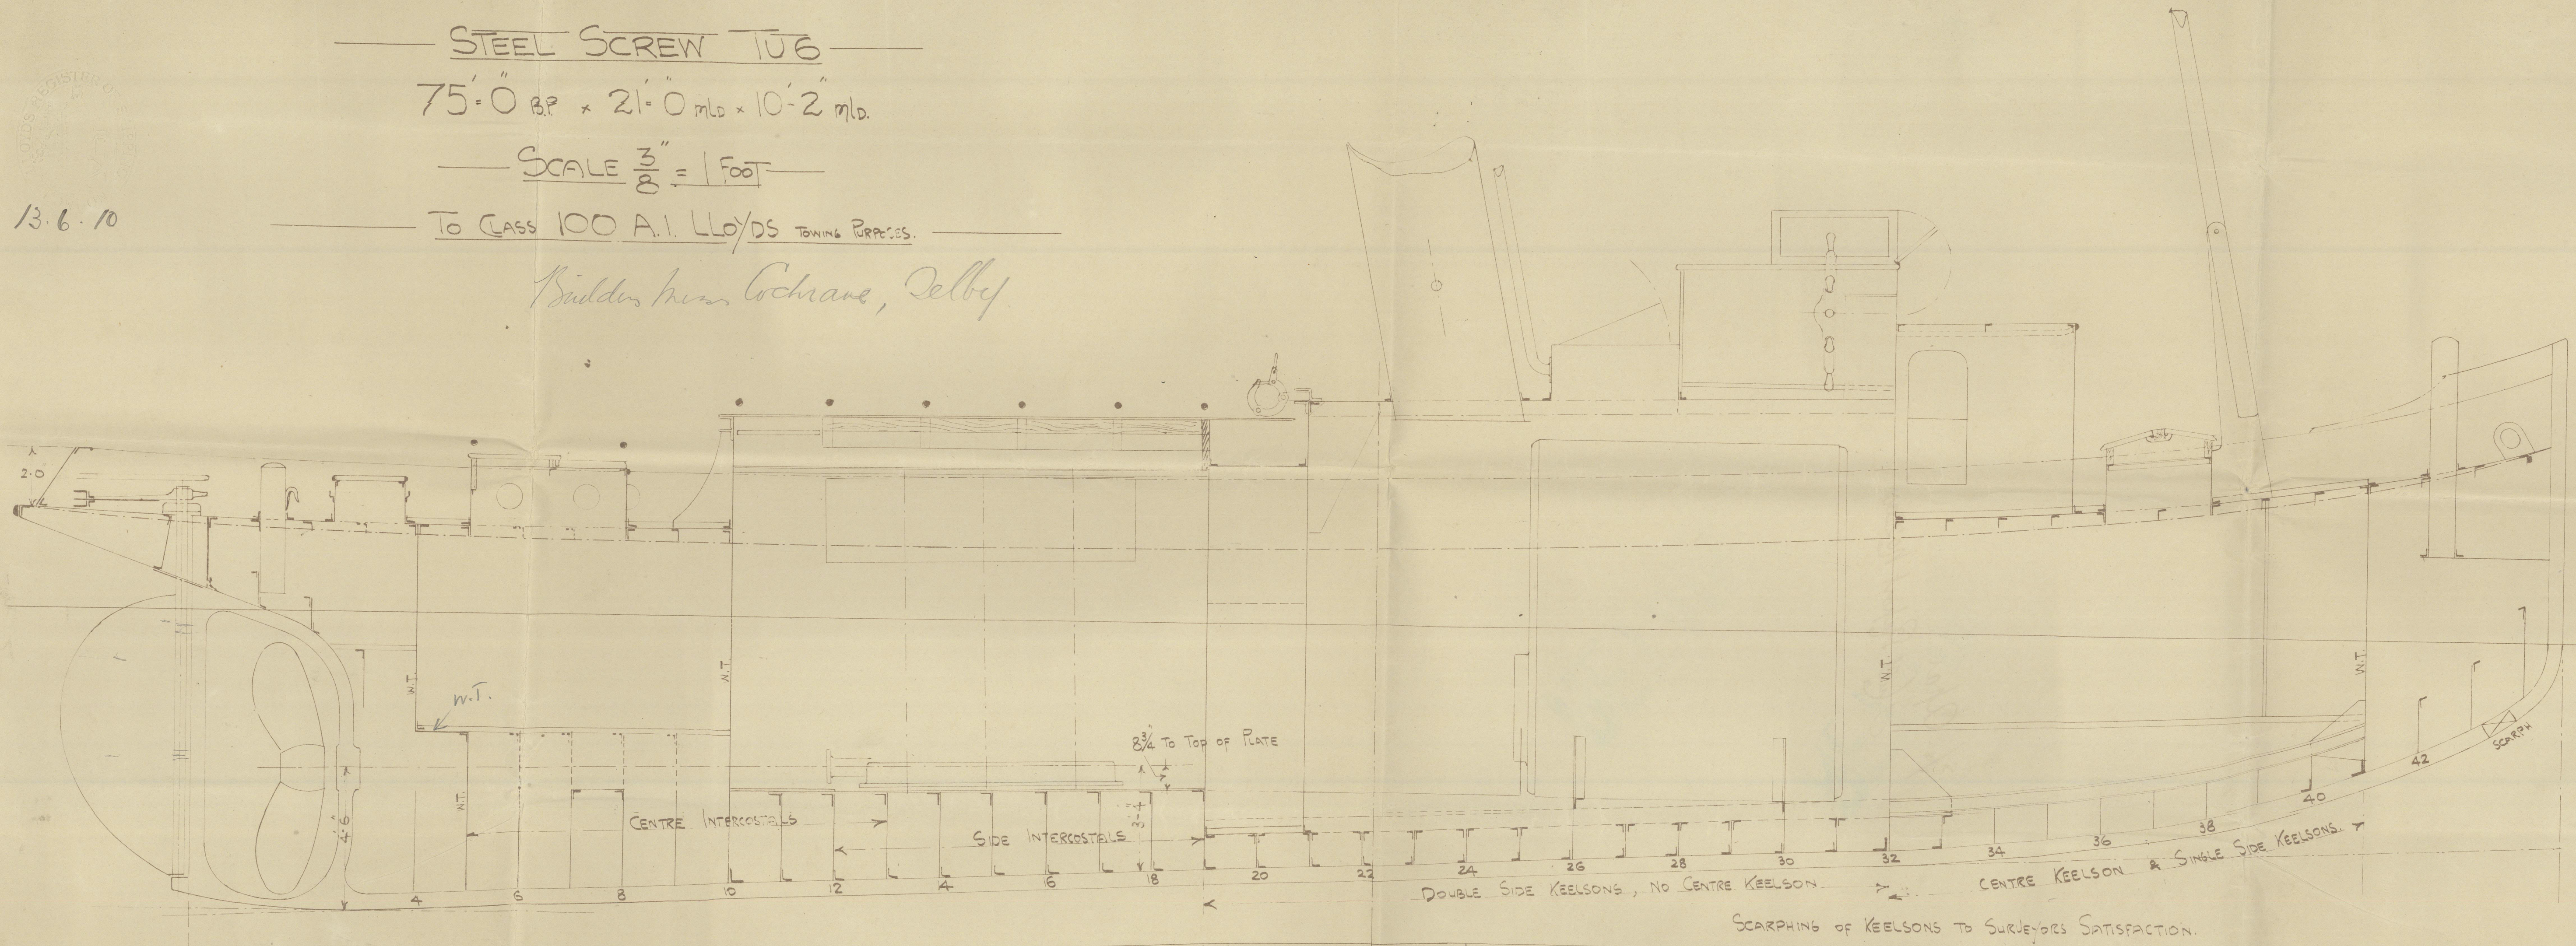

J. CONSTANT
11 BILLITER SQ.
LONDON E.C.

C.F.
13/6/10.

W1372-0057

-Profile & Deck Plan-
Cochrane & Sons

No 476
Jill

$\frac{5}{5}$ Apar

Hull Report No 23002

RETAINED



© 2021

Lloyd's Register
Foundation

W1372-0057