
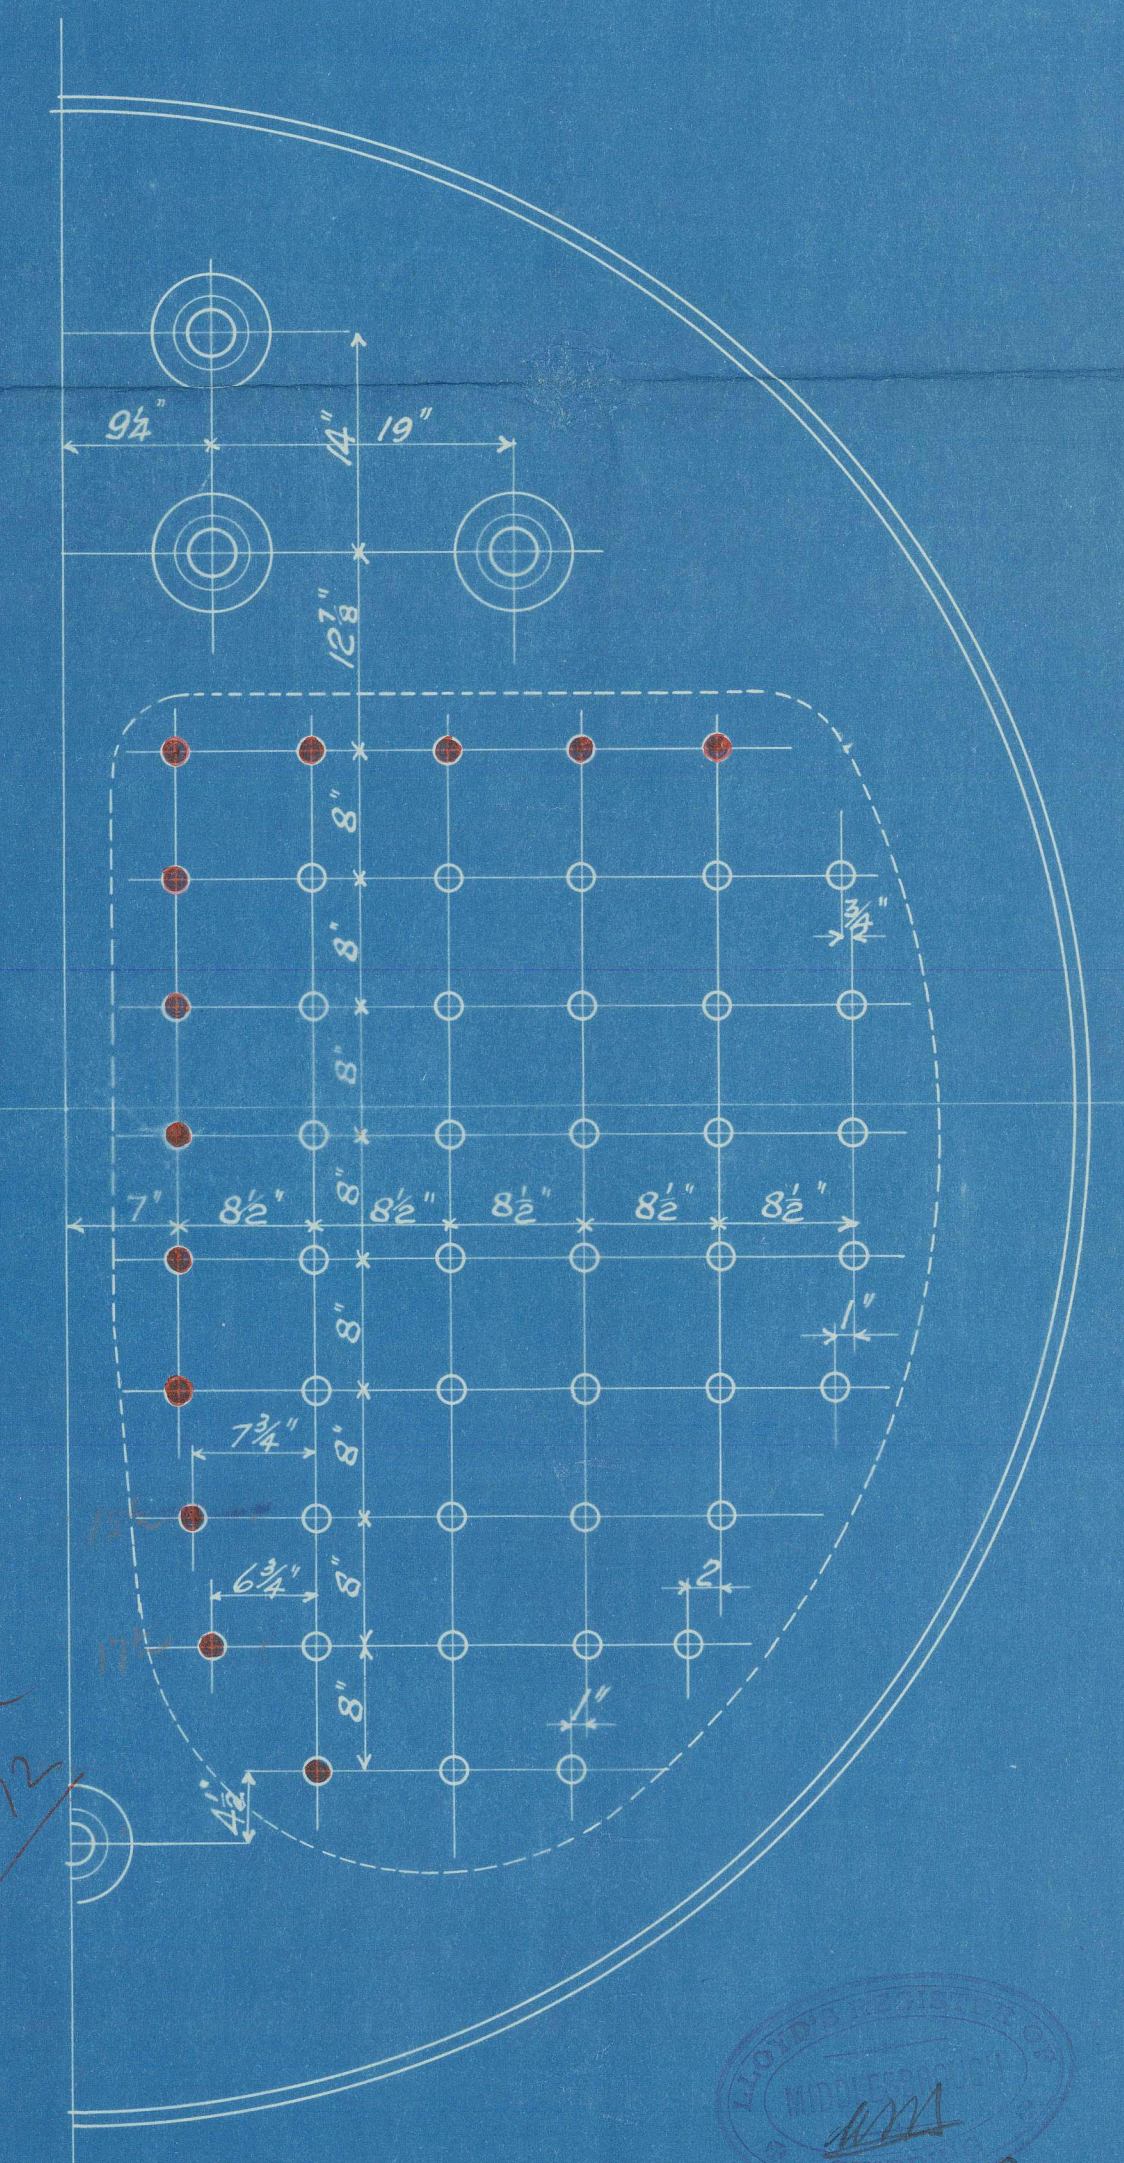
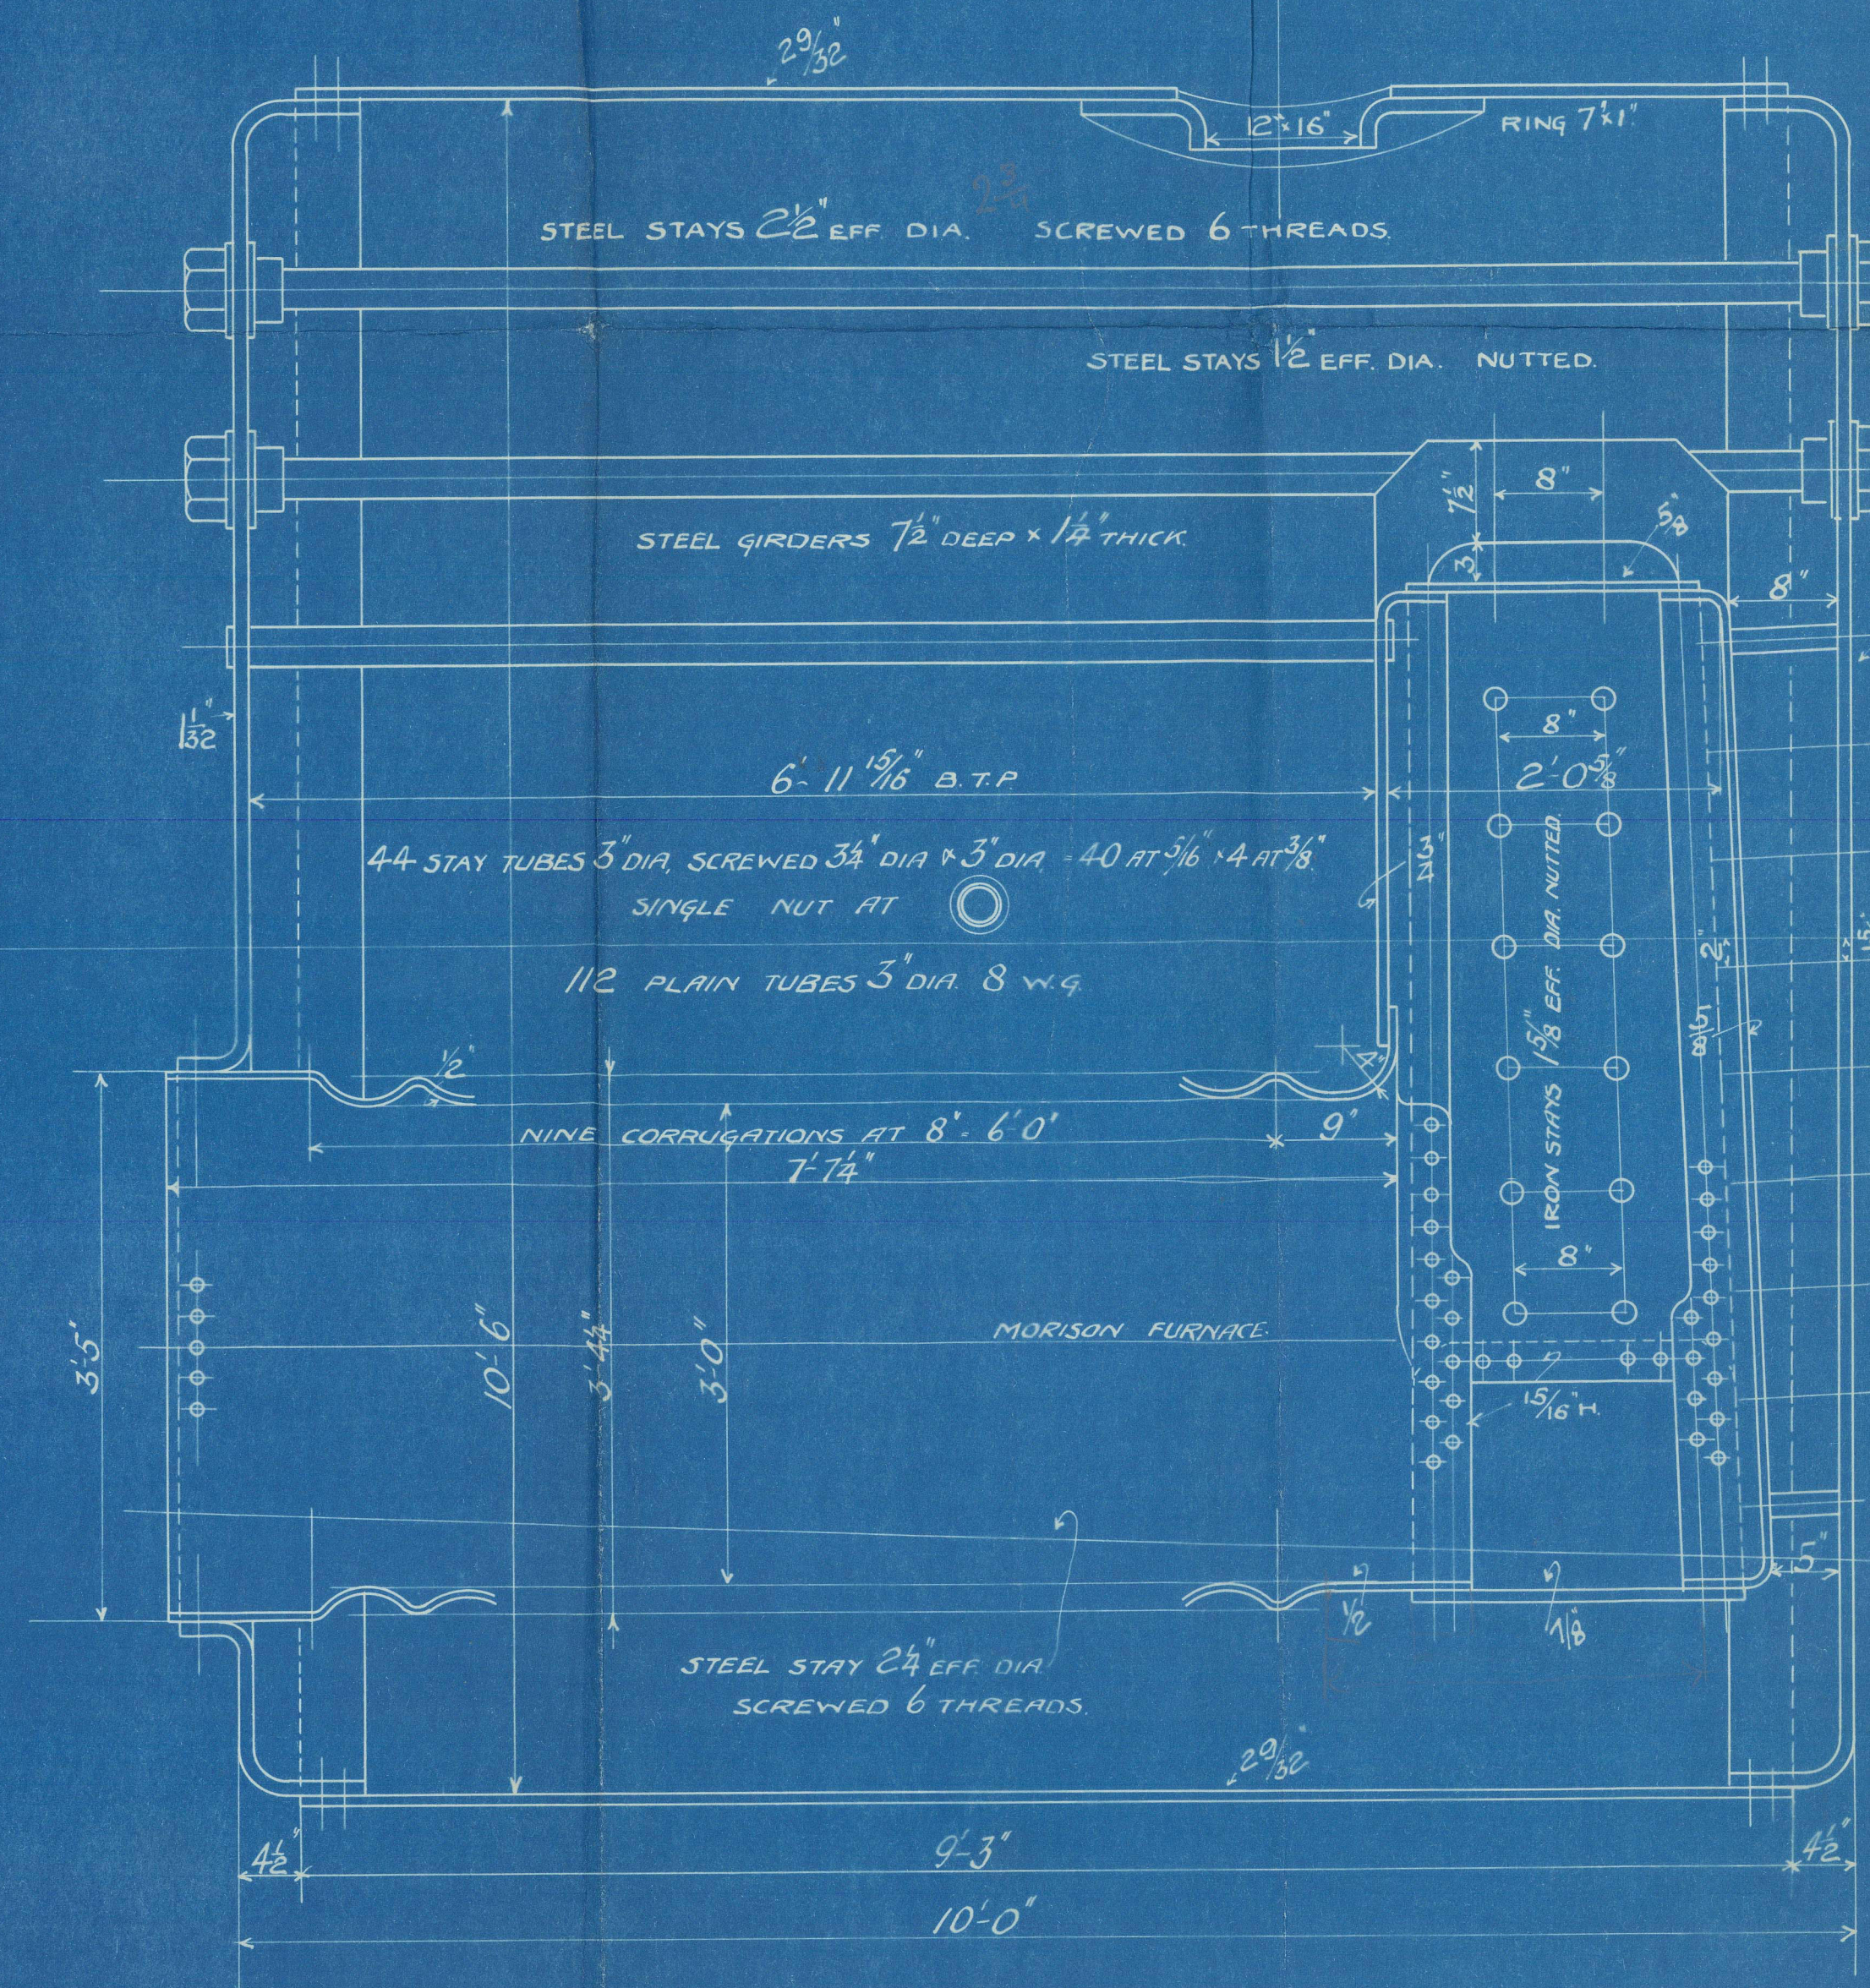
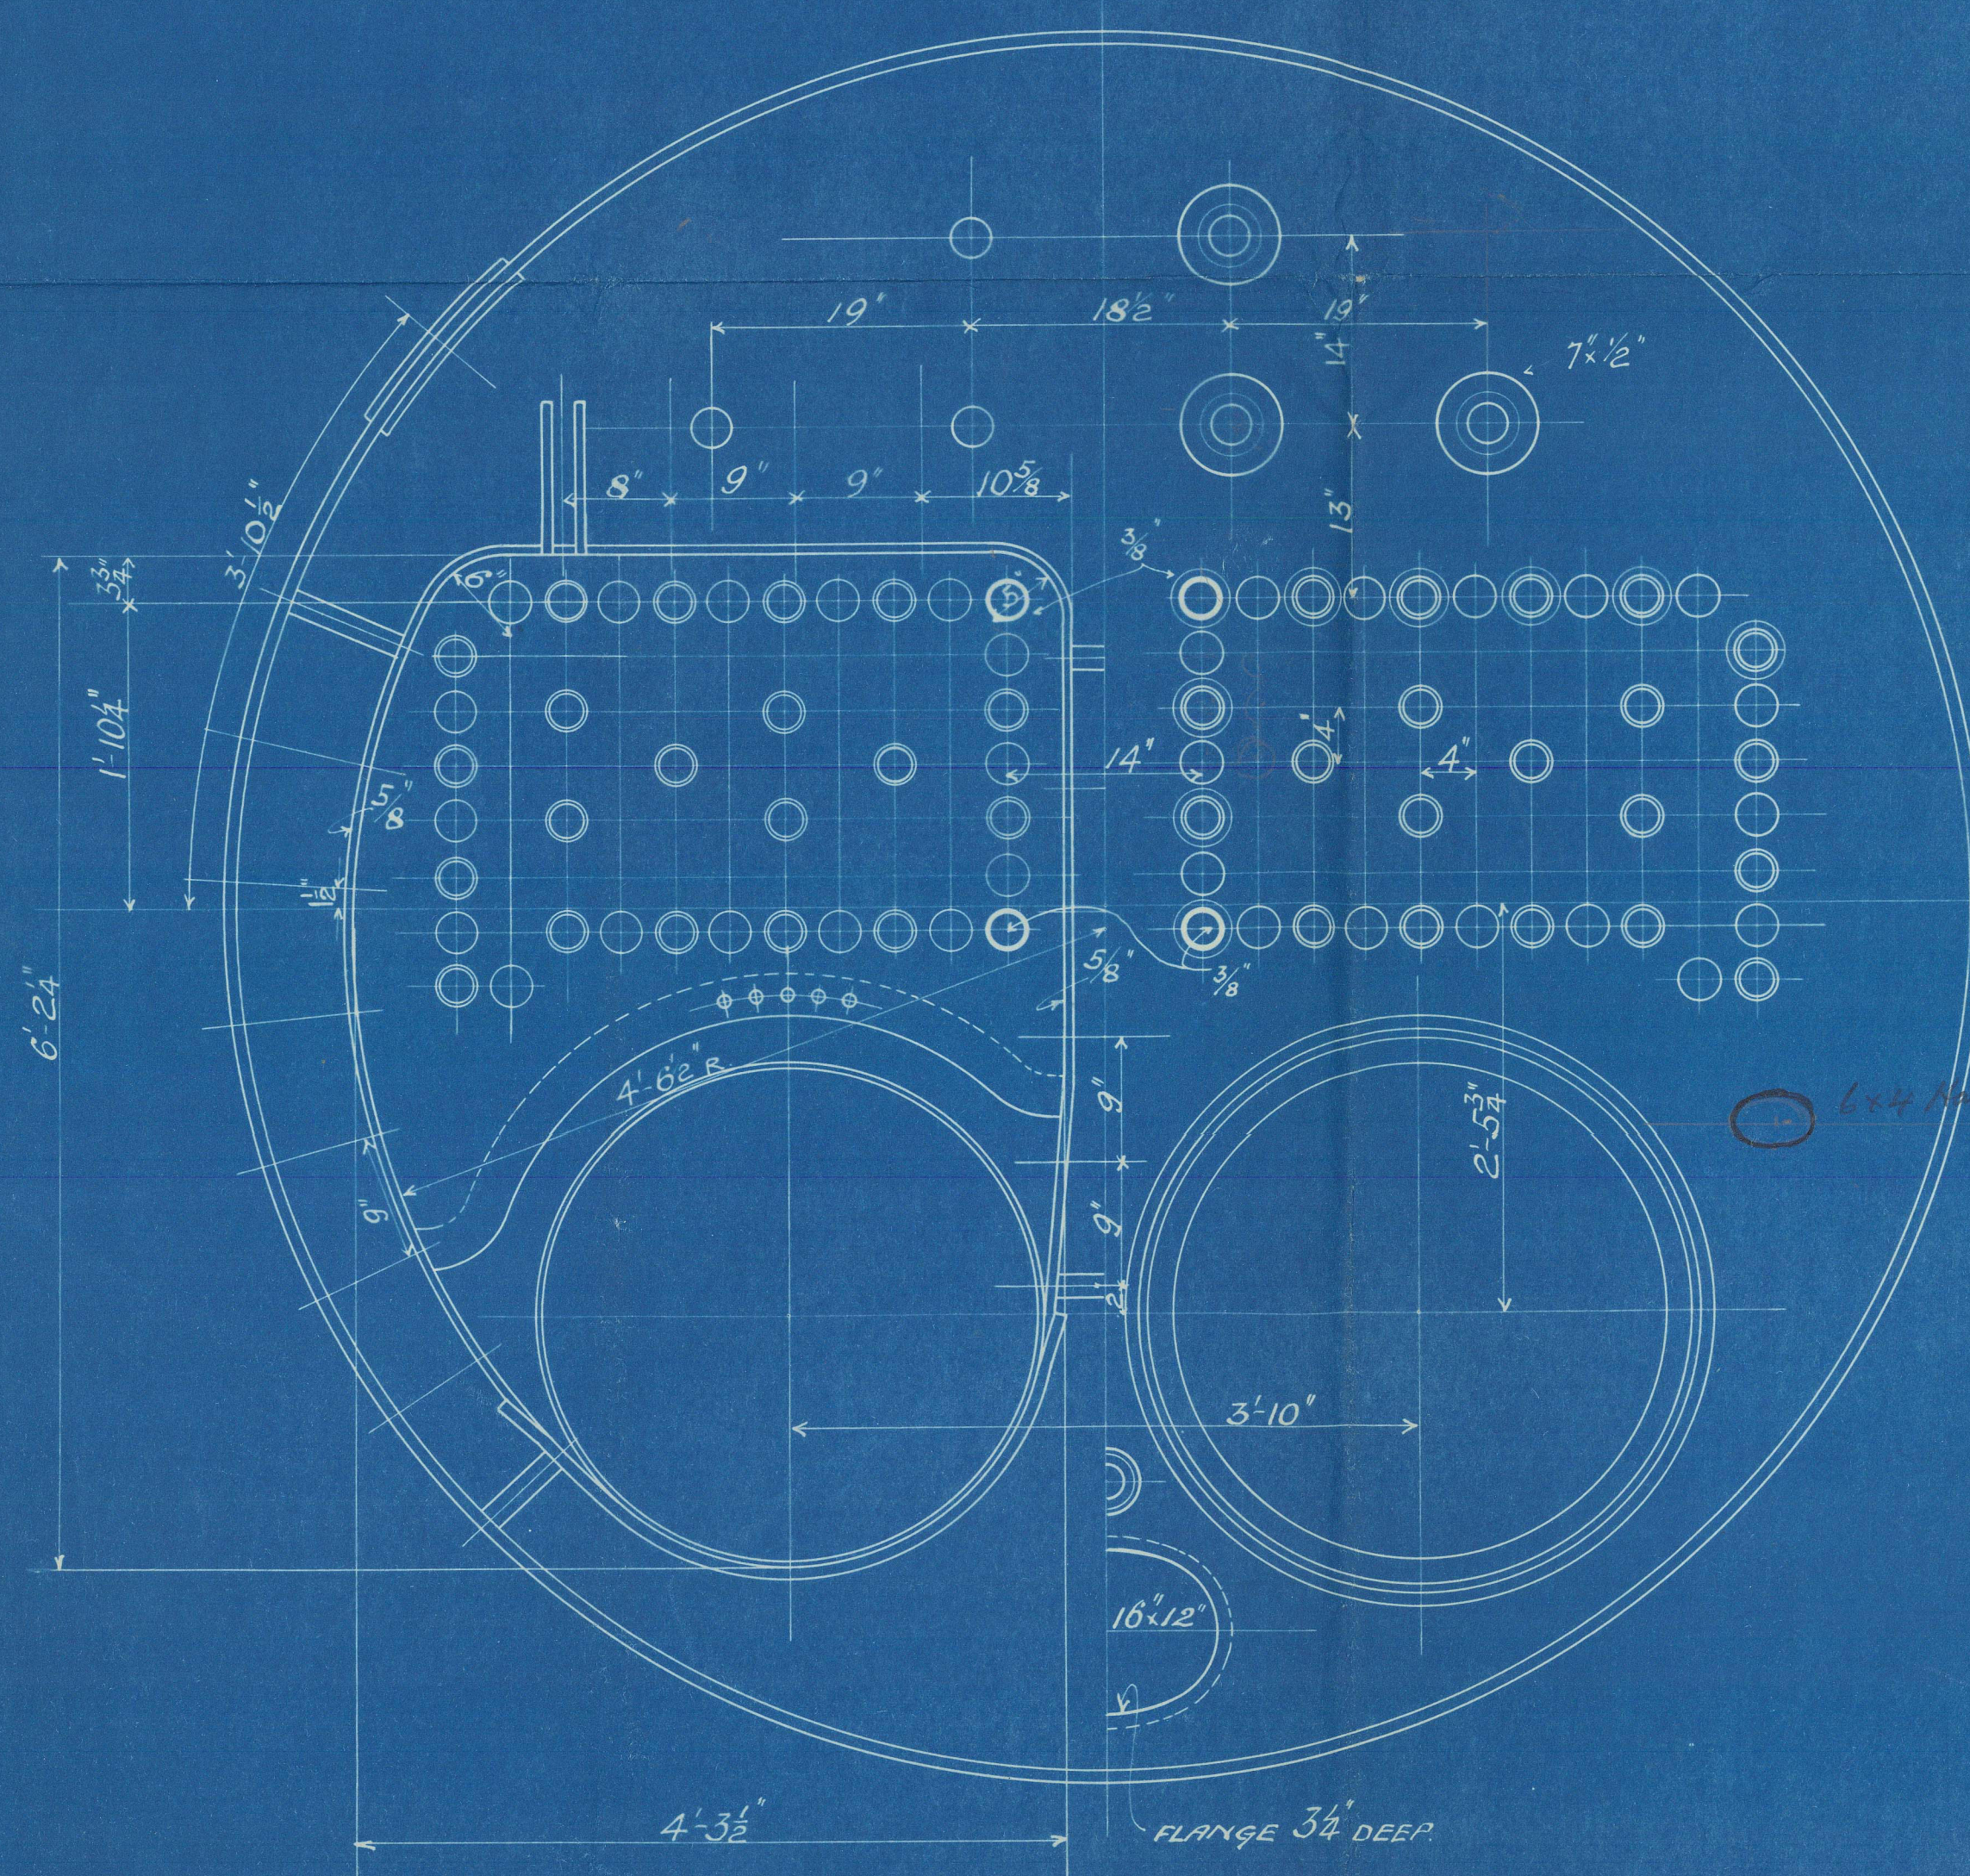


STEEL BOILER 10'-6" DIA 10'-0" LONG 185 LBS W.P. LLOYDS

4460

18/4/12

RILEY BROS. (BOILERMAKERS) LTD.
STOCKTON ON TEES.

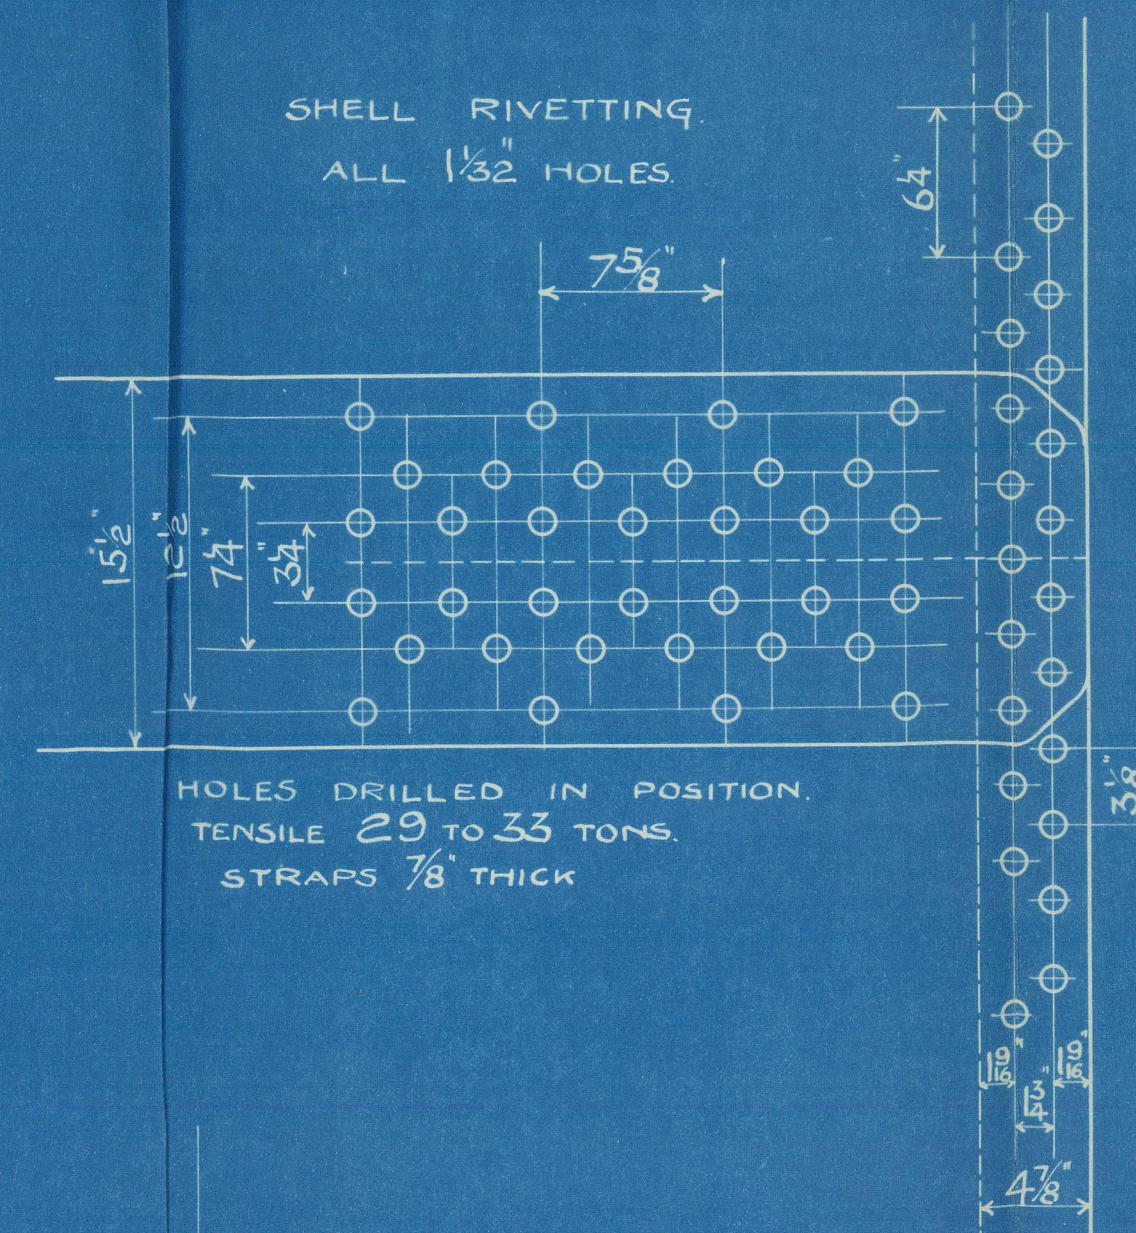

IRON STAYS 1 3/4" EFF DIA. SCREWED 9 THREADS.
NUTTED.
ALL SQUARE OFF C.C. PLATES.

9 APR 12

HEATING SURFACE 1050 sq ft.
GRATE AREA 6'-0" BARS IN 2 LENGTHS 36 sq ft.

16-4-12

A RARY
Thosn Puley Bros Ltd
Boiler No. 4460
for

Thosn Philip & Son Ltd
(of Dartmouth)
S.S. No 409

Working Pressure 185 lbs

Lab. Report 7561

17 APR 1912

LONDON

No.	4945
LLOYD'S TEST	
370 lbs.	
16.9.12 - WM	



© 2021

Lloyd's Register
Foundation