





PROPOSED SCREW TUG.

SCALE $\frac{1}{8}$ " = 1 FOOT.

TRIPLE ENGINES 104" 16" 26" x 20", RETURN TUBE BOILER.

*Noted 13³/₁₂
P.L. 11/18*

*11-3-12
15-3-12
21-5-12*

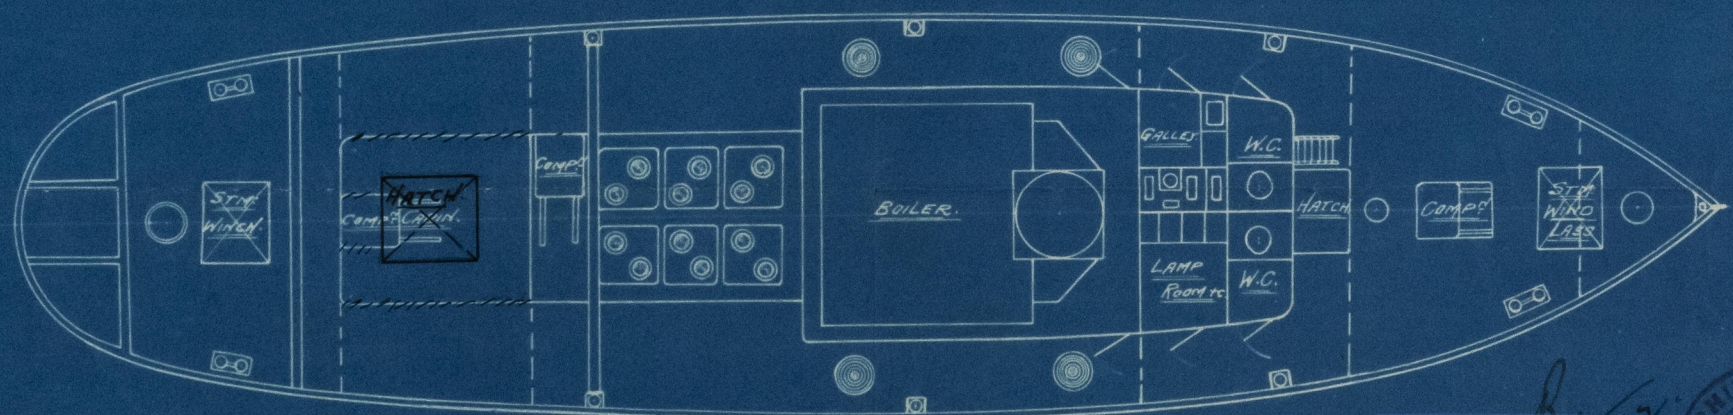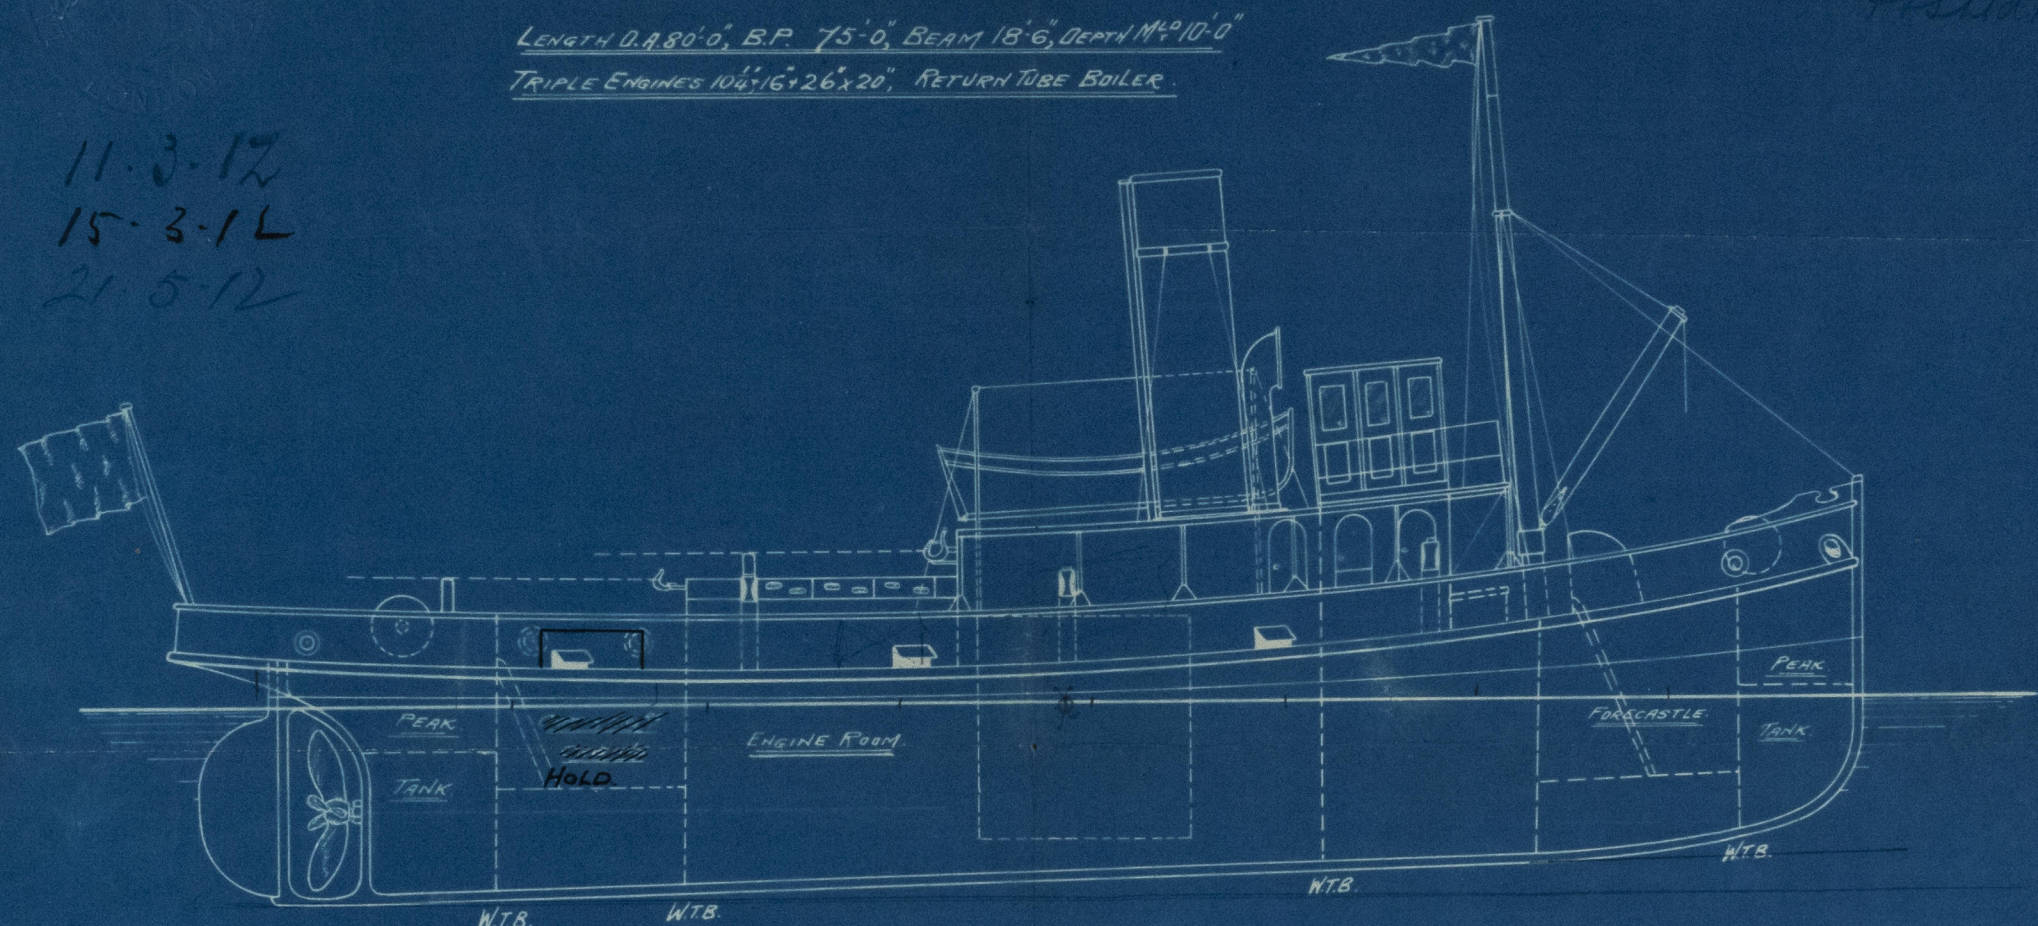



Nº 409.

9-2-12

W1373-0181

Ply Rpt 5462 "Arany"
Profile & Deck
Plan

Steel Screw Tug
No 409
Philip Lou Lin
Dartmouth

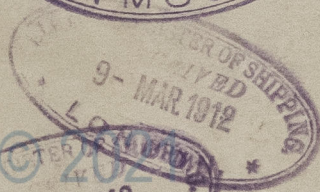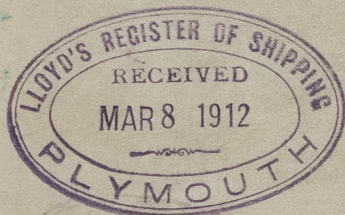

15 MAR 1912
LONDON

20 MAR 1912

W1373-0181