


23 April 1904

SCALE  $\frac{1}{8}$  INCH TO ONE FOOT

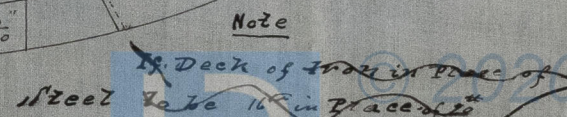

C.B.  
28-4-04

LLOR REGISTER  
OF SHIPPING  
1914  
ROLL +

7.69

W1375-0143




- No 13 -  
Profile & Deck Plan  
T. Dobson & Co  
- Newcastle

SS "Argosy"

3/4 "Argosy"  
Hull Report No. 16580

RETAIN

W1375-0143

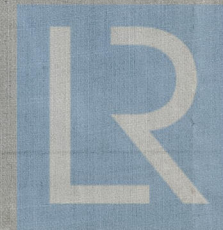

© 2020

Lloyd's Register  
Foundation