

HORIZONTAL MULTITUBULAR STEEL BOILER



12'-3" DIA X 10'-3" LONG

LLOYDS SURVEY 180 LBS. W.P.

N^o 3432.

SCALE 1" = 1 FT.

FOR MESSRS CRABTREE & CO. LTD GREAT YARMOUTH.

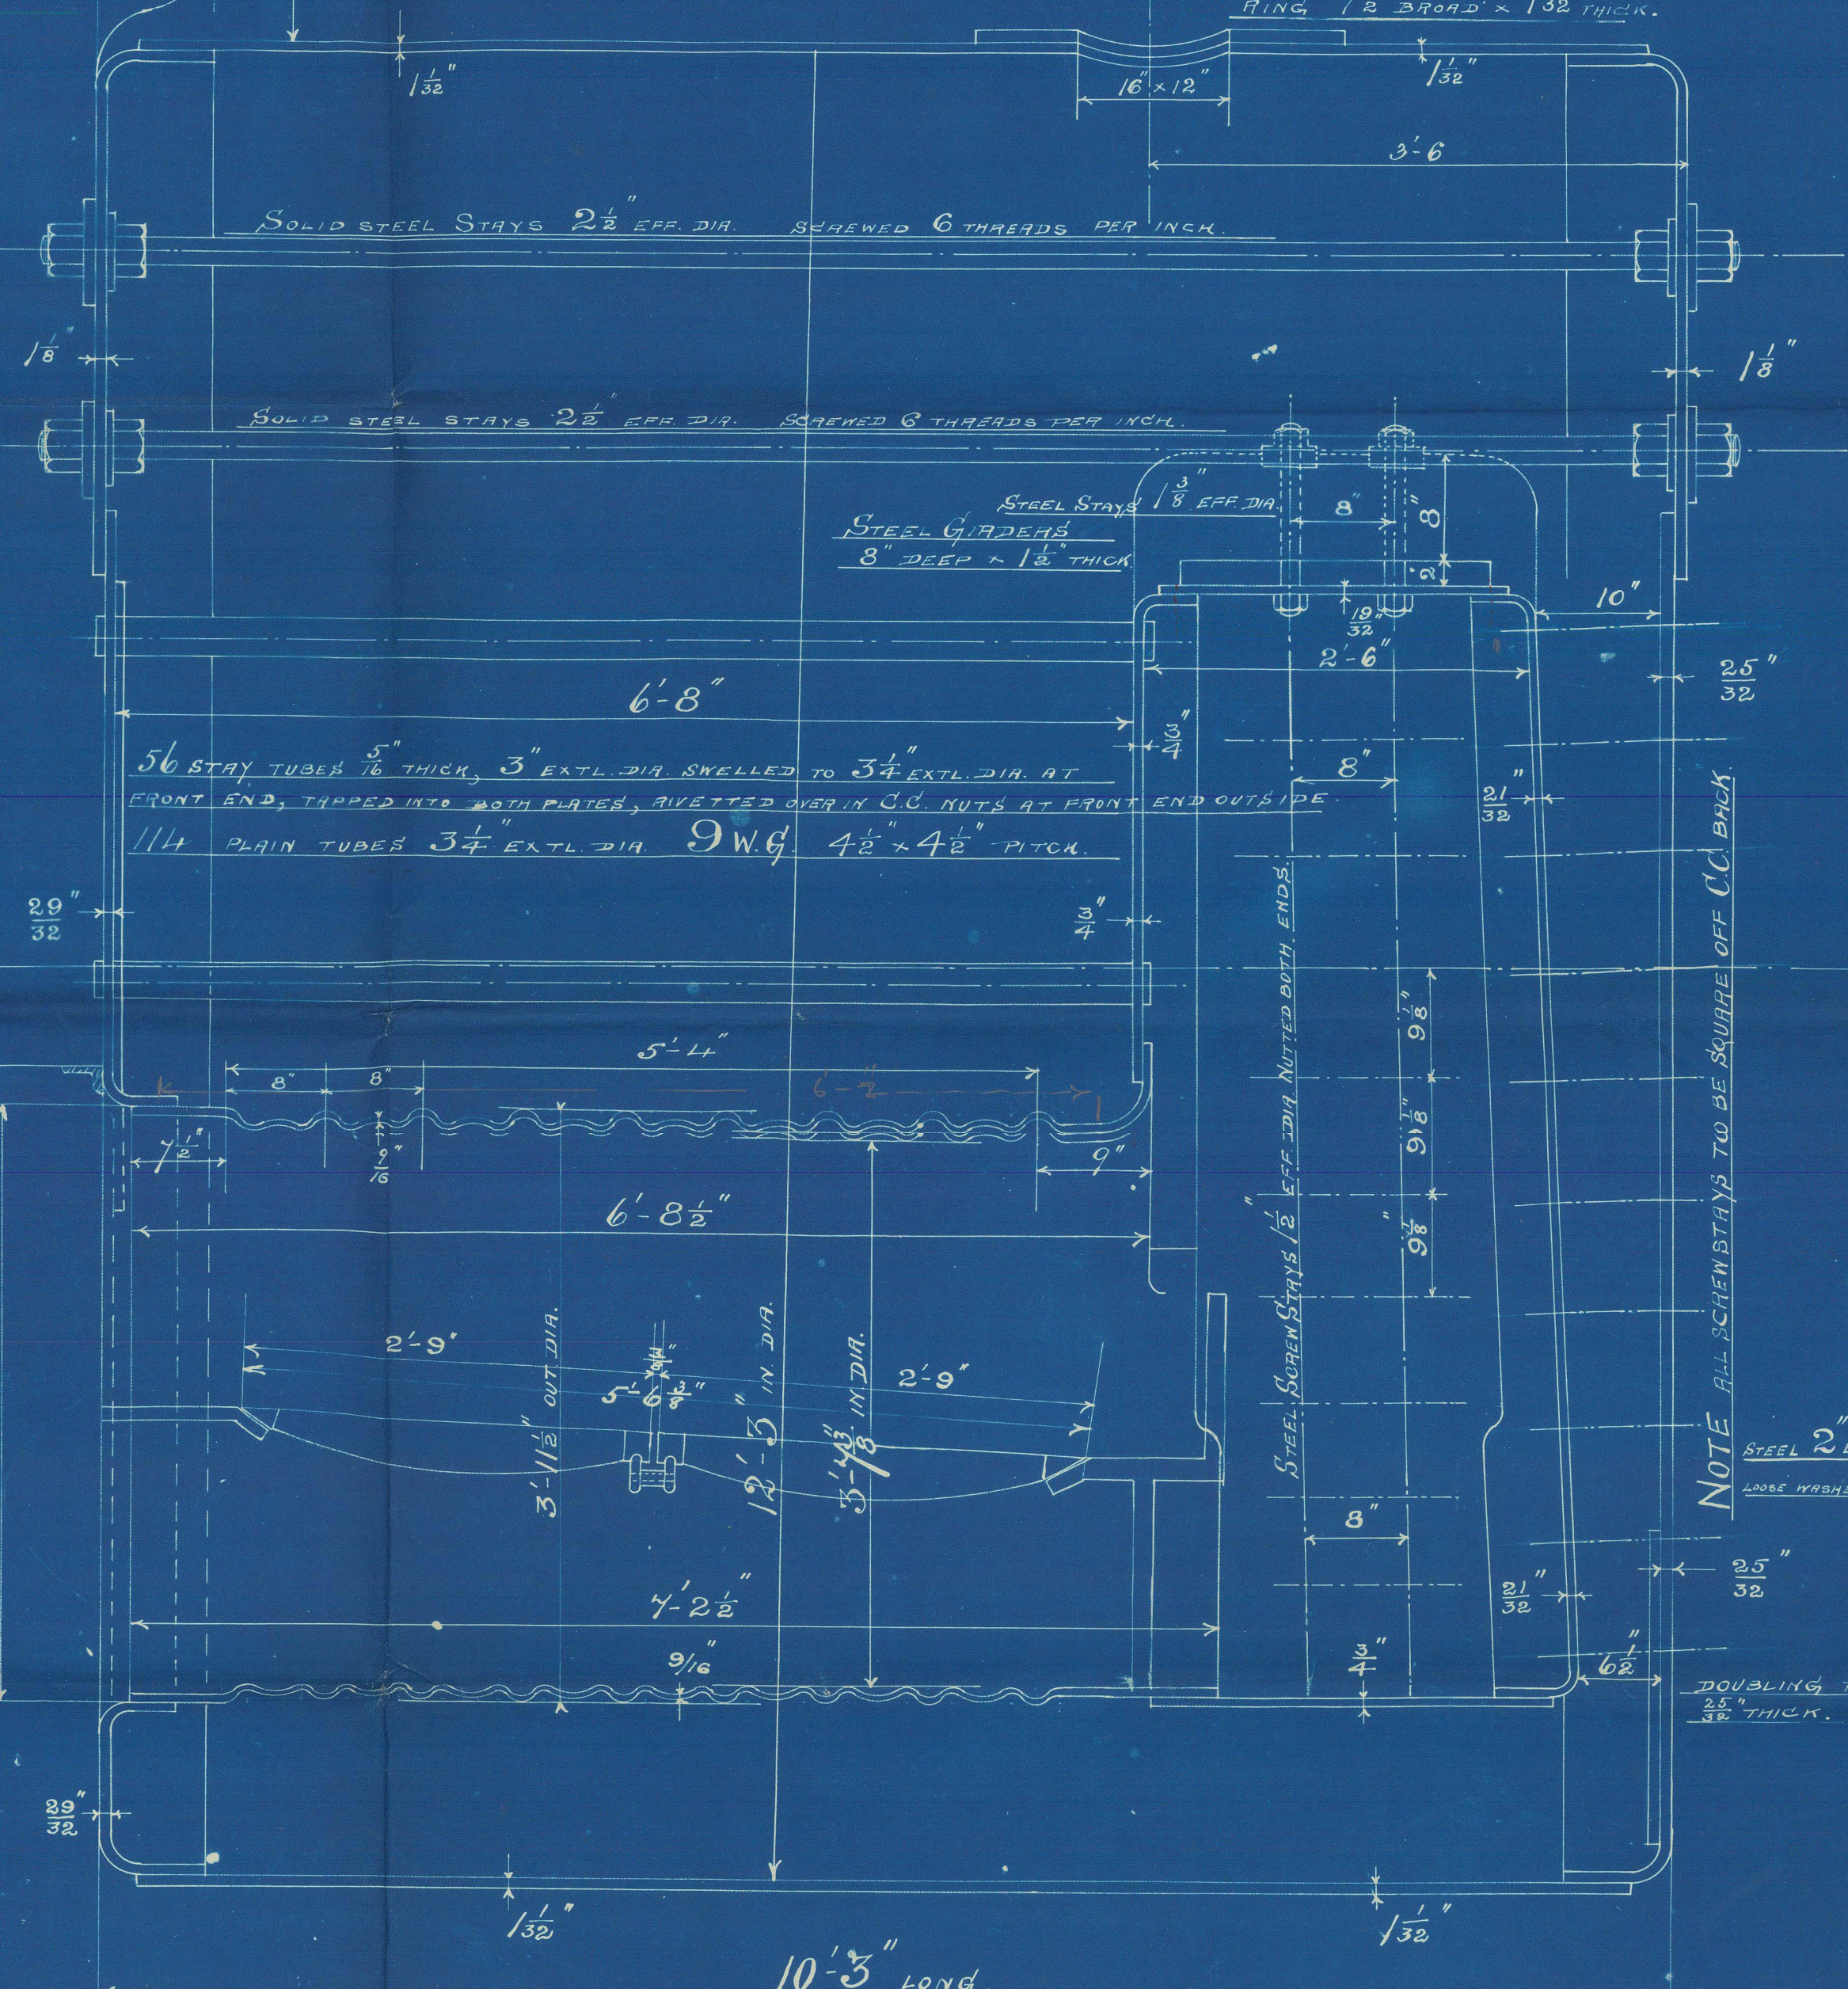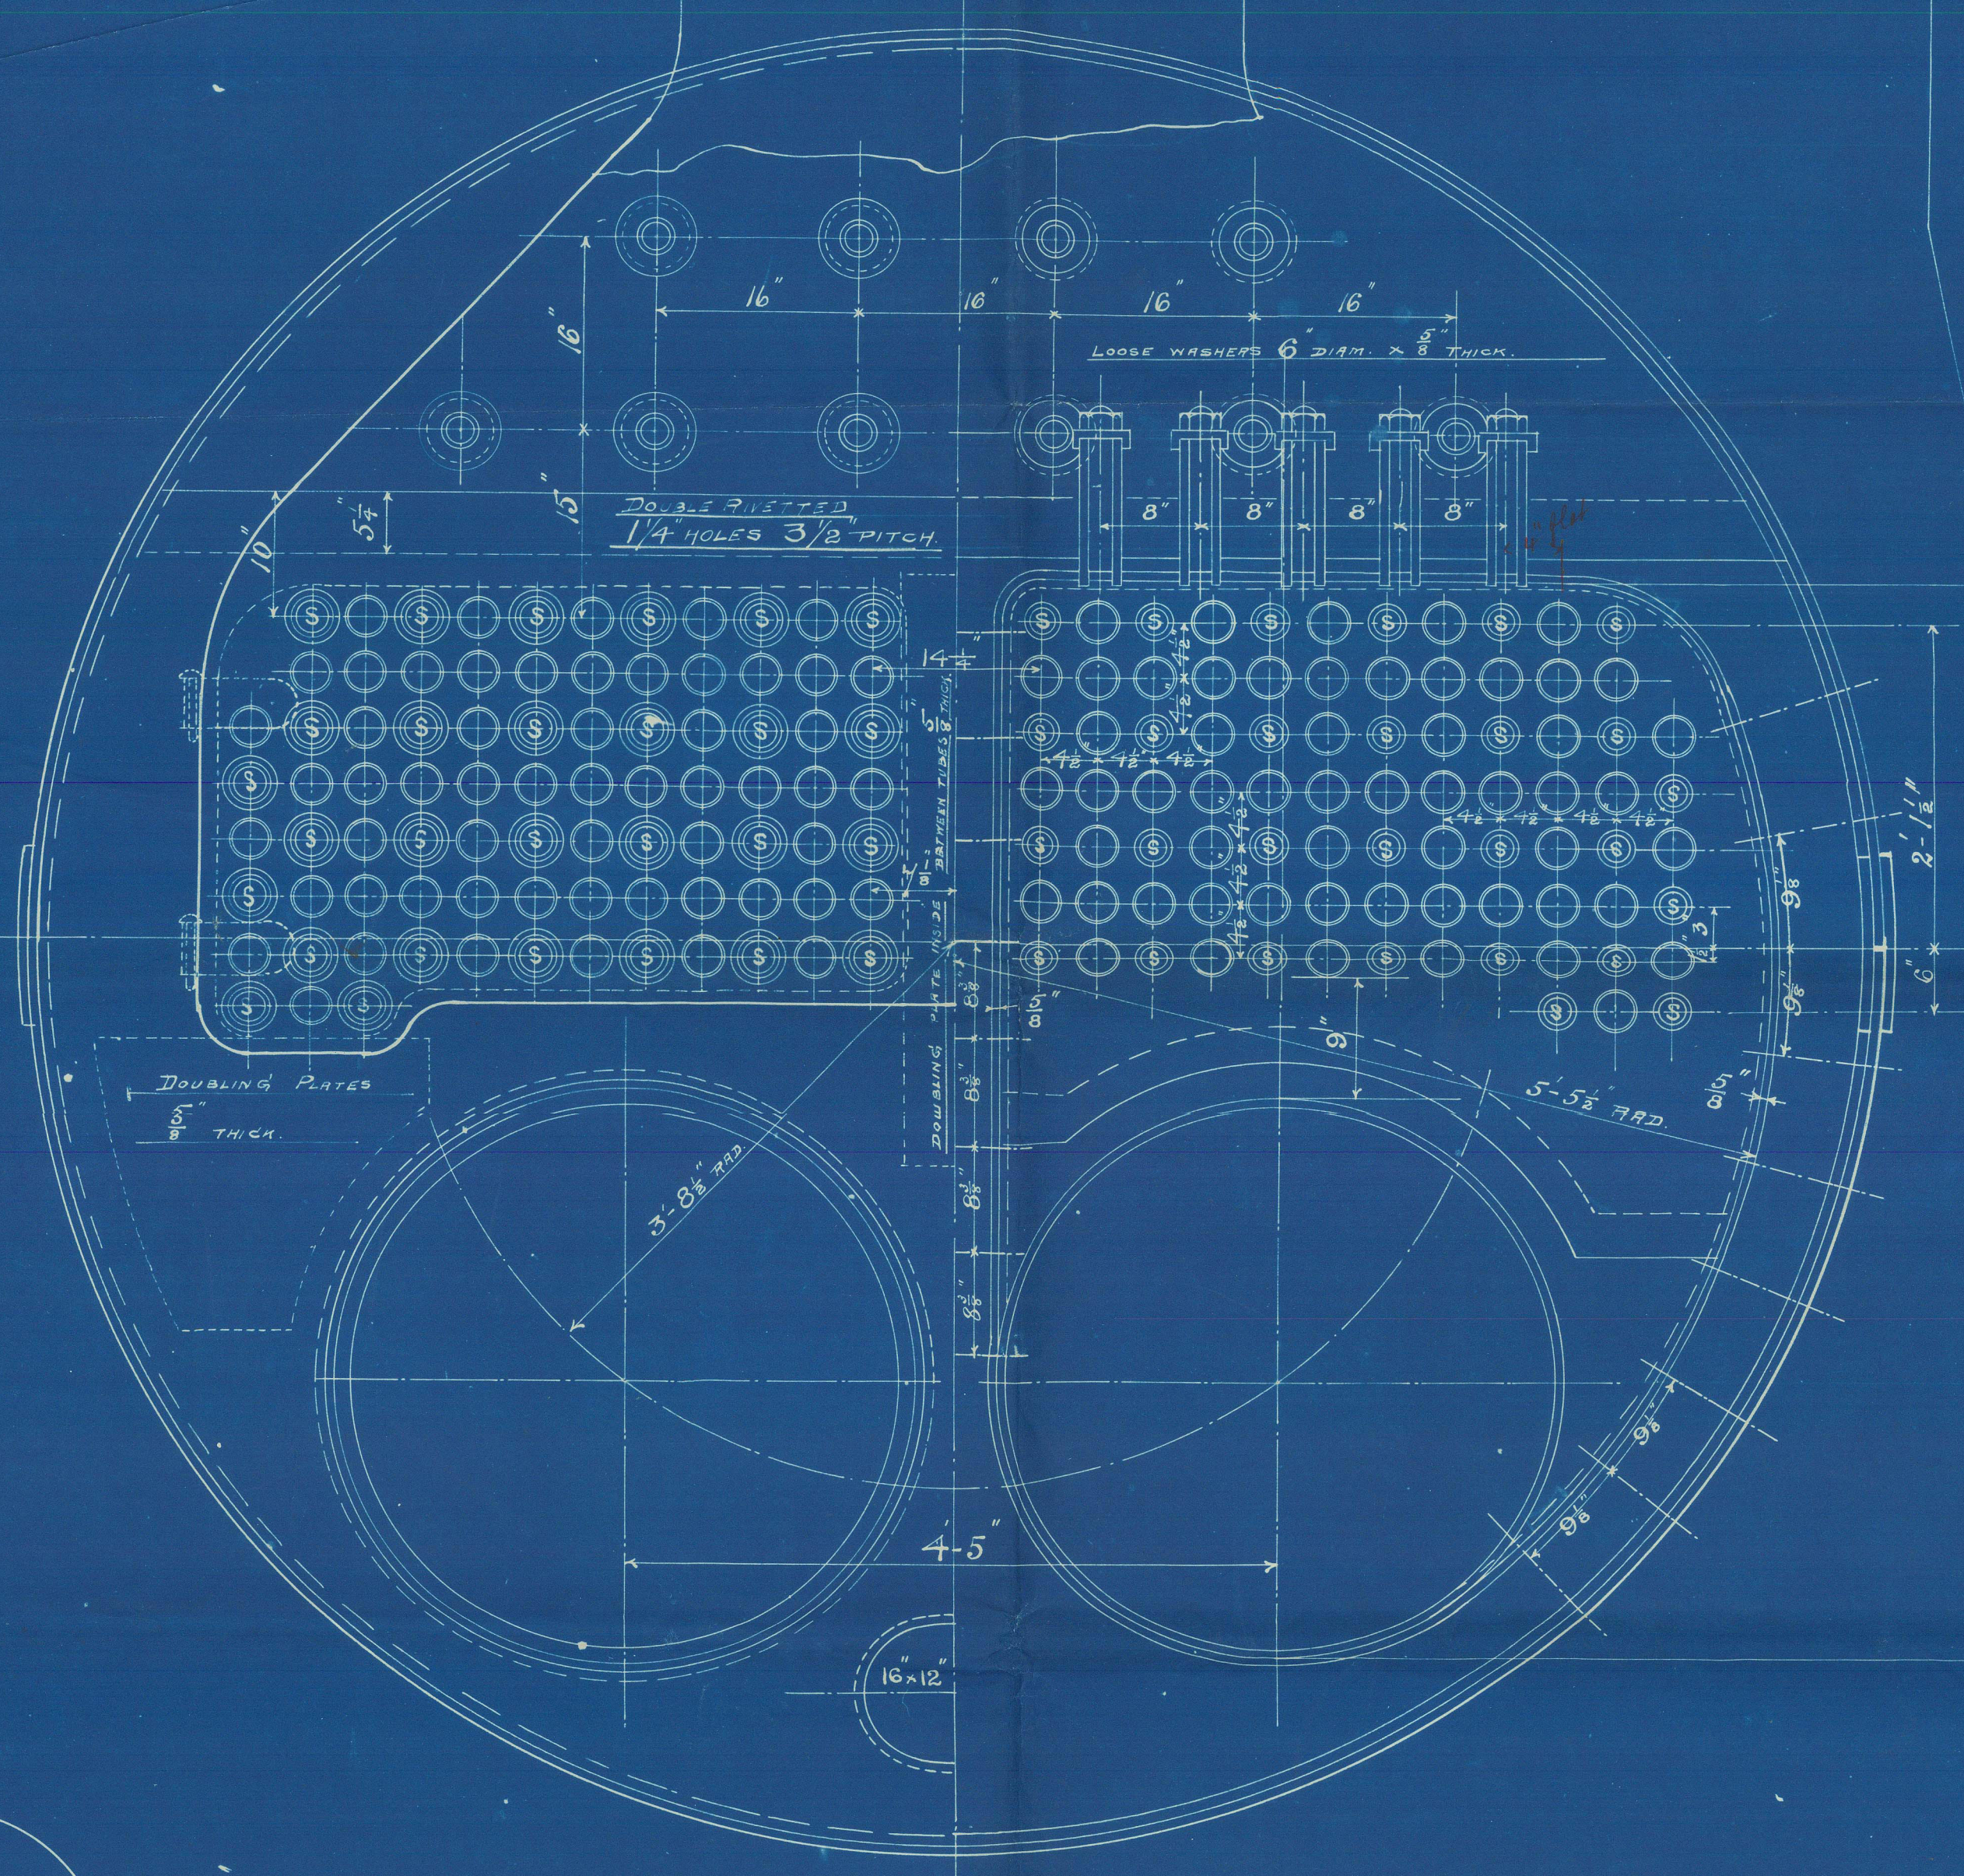

NOTE: ALL SHEET PIPES TO BE SUPPLIED OFF C.C. BACK.

HEATING SURFACE 1280 SQ. FT.

GRATE AREA, BARS 5'-6" LONG, IN 2 LENGTHS, 40.6 SQ. FT.

RATIO OF HEATING SURFACE TO GRATE AREA 33.5 : 1


Miley Bros & Co^l

3432
for

Crabtree & Co^l

Great Yarmouth

180 lbs. W.T.

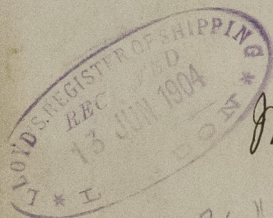

Argosy

Mdb report no 4001

Classed

S/S "Argosy"

Bouldon

The Dobson 100

Husle

Traded

28/10/04

Hull Report no. 165⁴² and.

RETAIN



© 2020

Lloyd's Register
Foundation

W1375-0144