


4.12.05  
19.12.05  
6.2.06  
22.2.06  
28.2.06

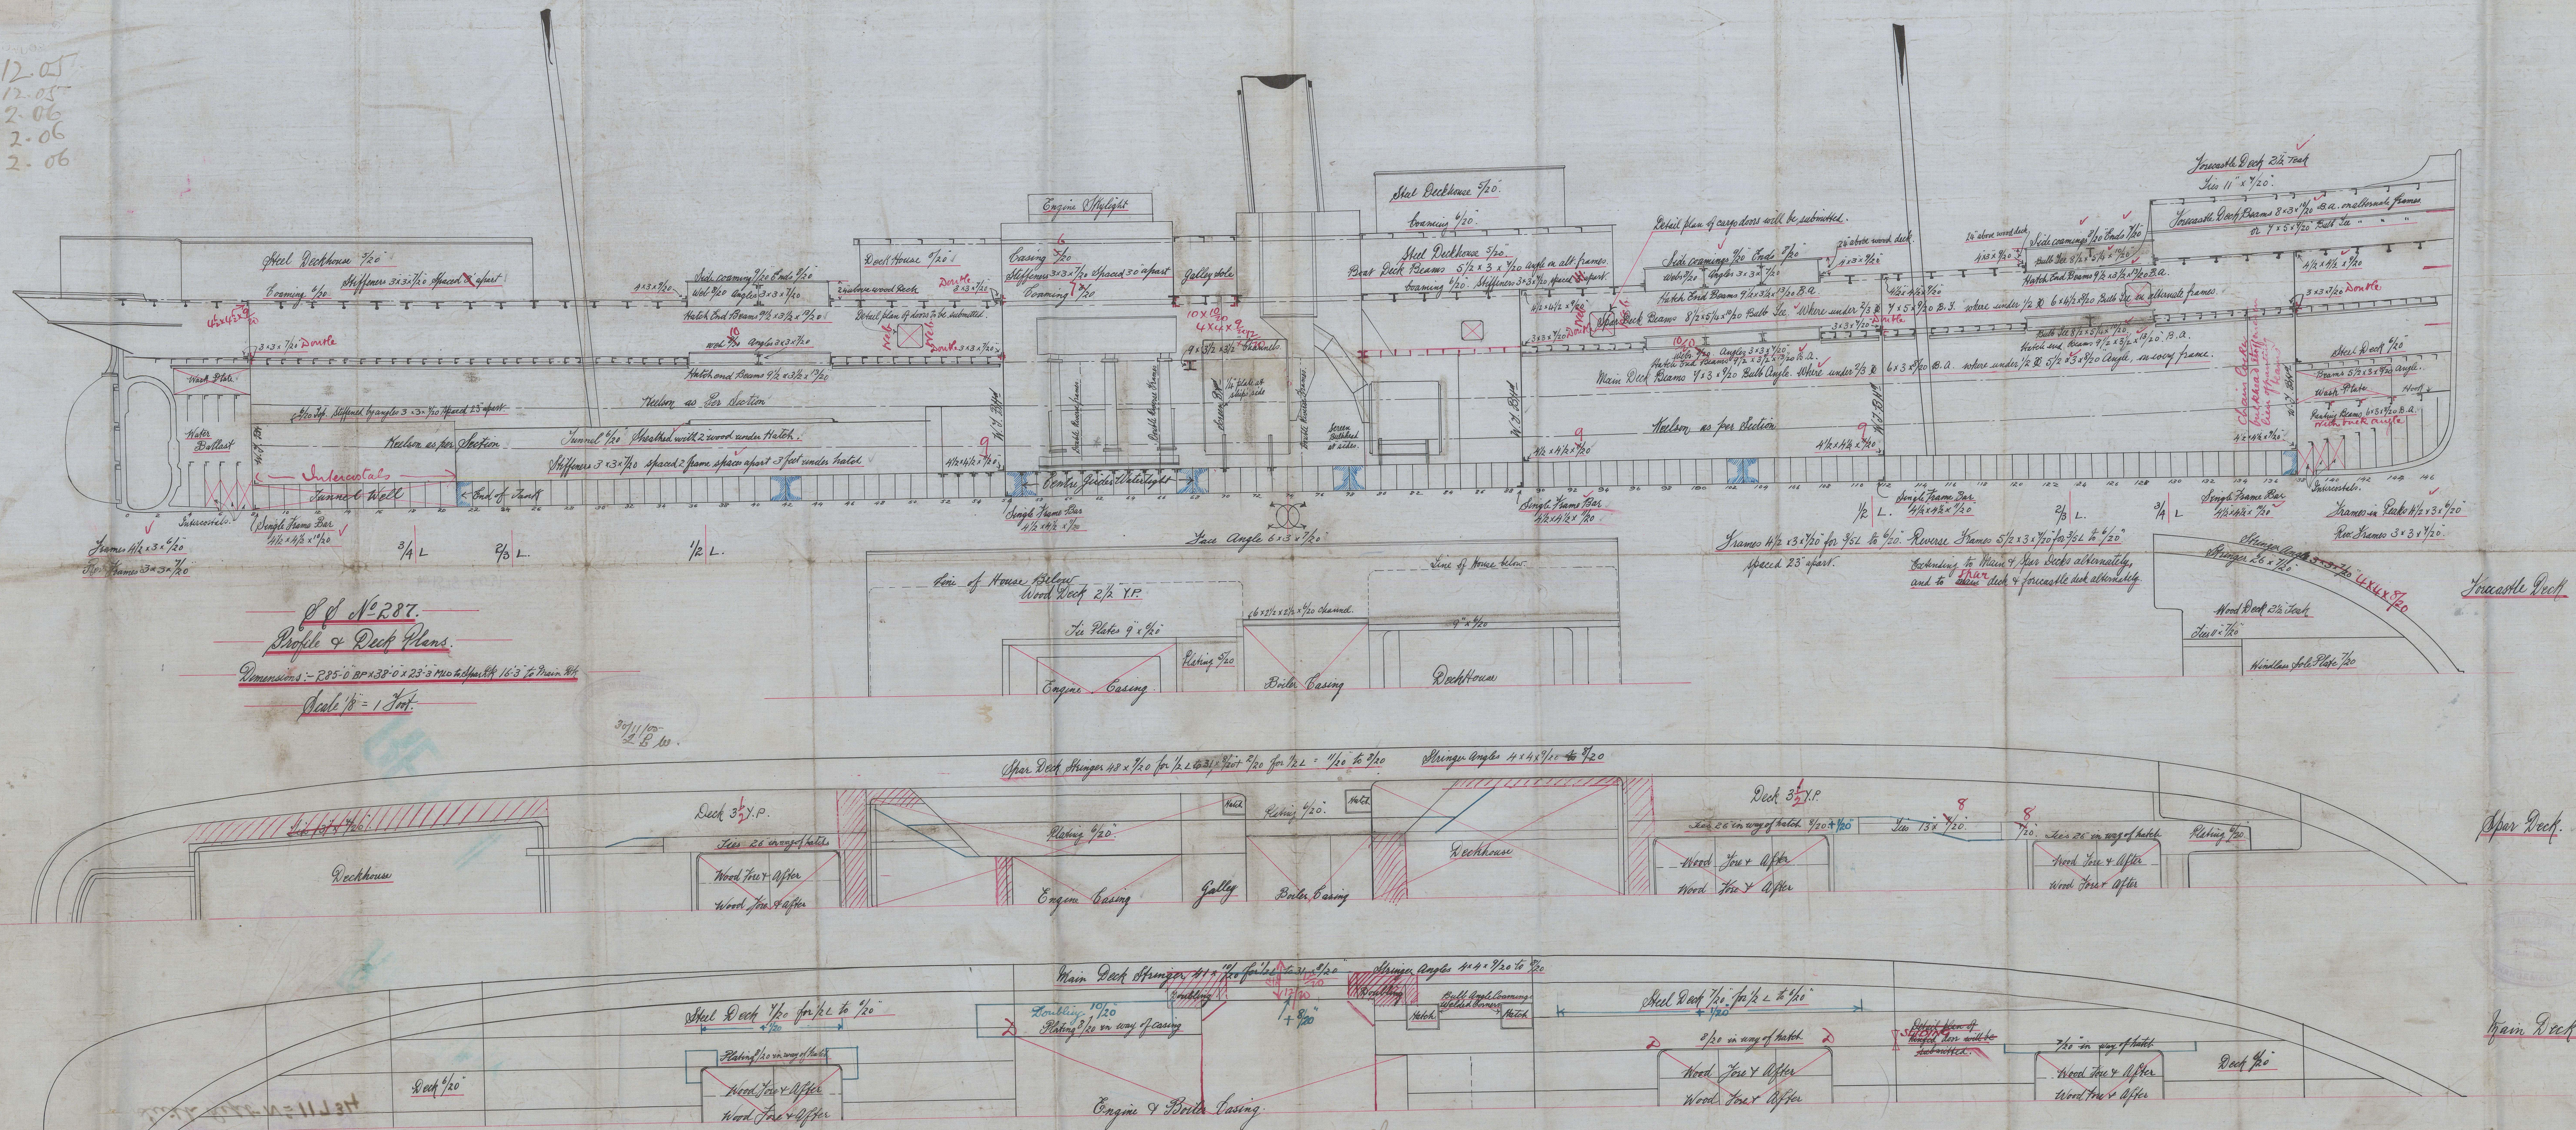

22 N 581  
 18

11/2/05  
W1378-0031 1/2



W1378-0031  $\frac{3}{2}$

PRIVATE GRAVING DOCK 275 FEET LONG.

1<sup>st</sup> Feb.

1906

GRANGEMOUTH AND GREENOCK DOCKYARD CO.,

GRANGEMOUTH, N.B.

This Enclosure is to be sent to

Ships No. 287

Tracing No. 157

Lloyds

LONDON



Profile 12

S.S. N° 287

Grangemouth & Greenock  
Dockyard Co.

Lith

Awaji Maru

Lith Rept N° 11734



© 2021

Lloyd's Register  
Foundation

W1378-0031