

4.12.05
19.12.05
6.2.06
22.2.06
28.2.06
5.5.06


N^o 287 MIDSHIP SECTION.

Numerals.
 $\frac{1}{2}$ Girth 32.42.
 $\frac{1}{2}$ Breadth 19.00
Depth 17.04

Dimensions. - R85-0 B.P. x 38-0 x R3-3 MLO to Spar Deck.
16-3 " Main Deck.
Scale $\frac{1}{2}$ " = 1 Foot.
To Class 100 A1 M.C. Lloyd's Special Survey.

Proportions.
Depth to Length 16.63
Breadth to Length 7.46

F.N. 68.76 x 283.5 = 19493.46 P.N.

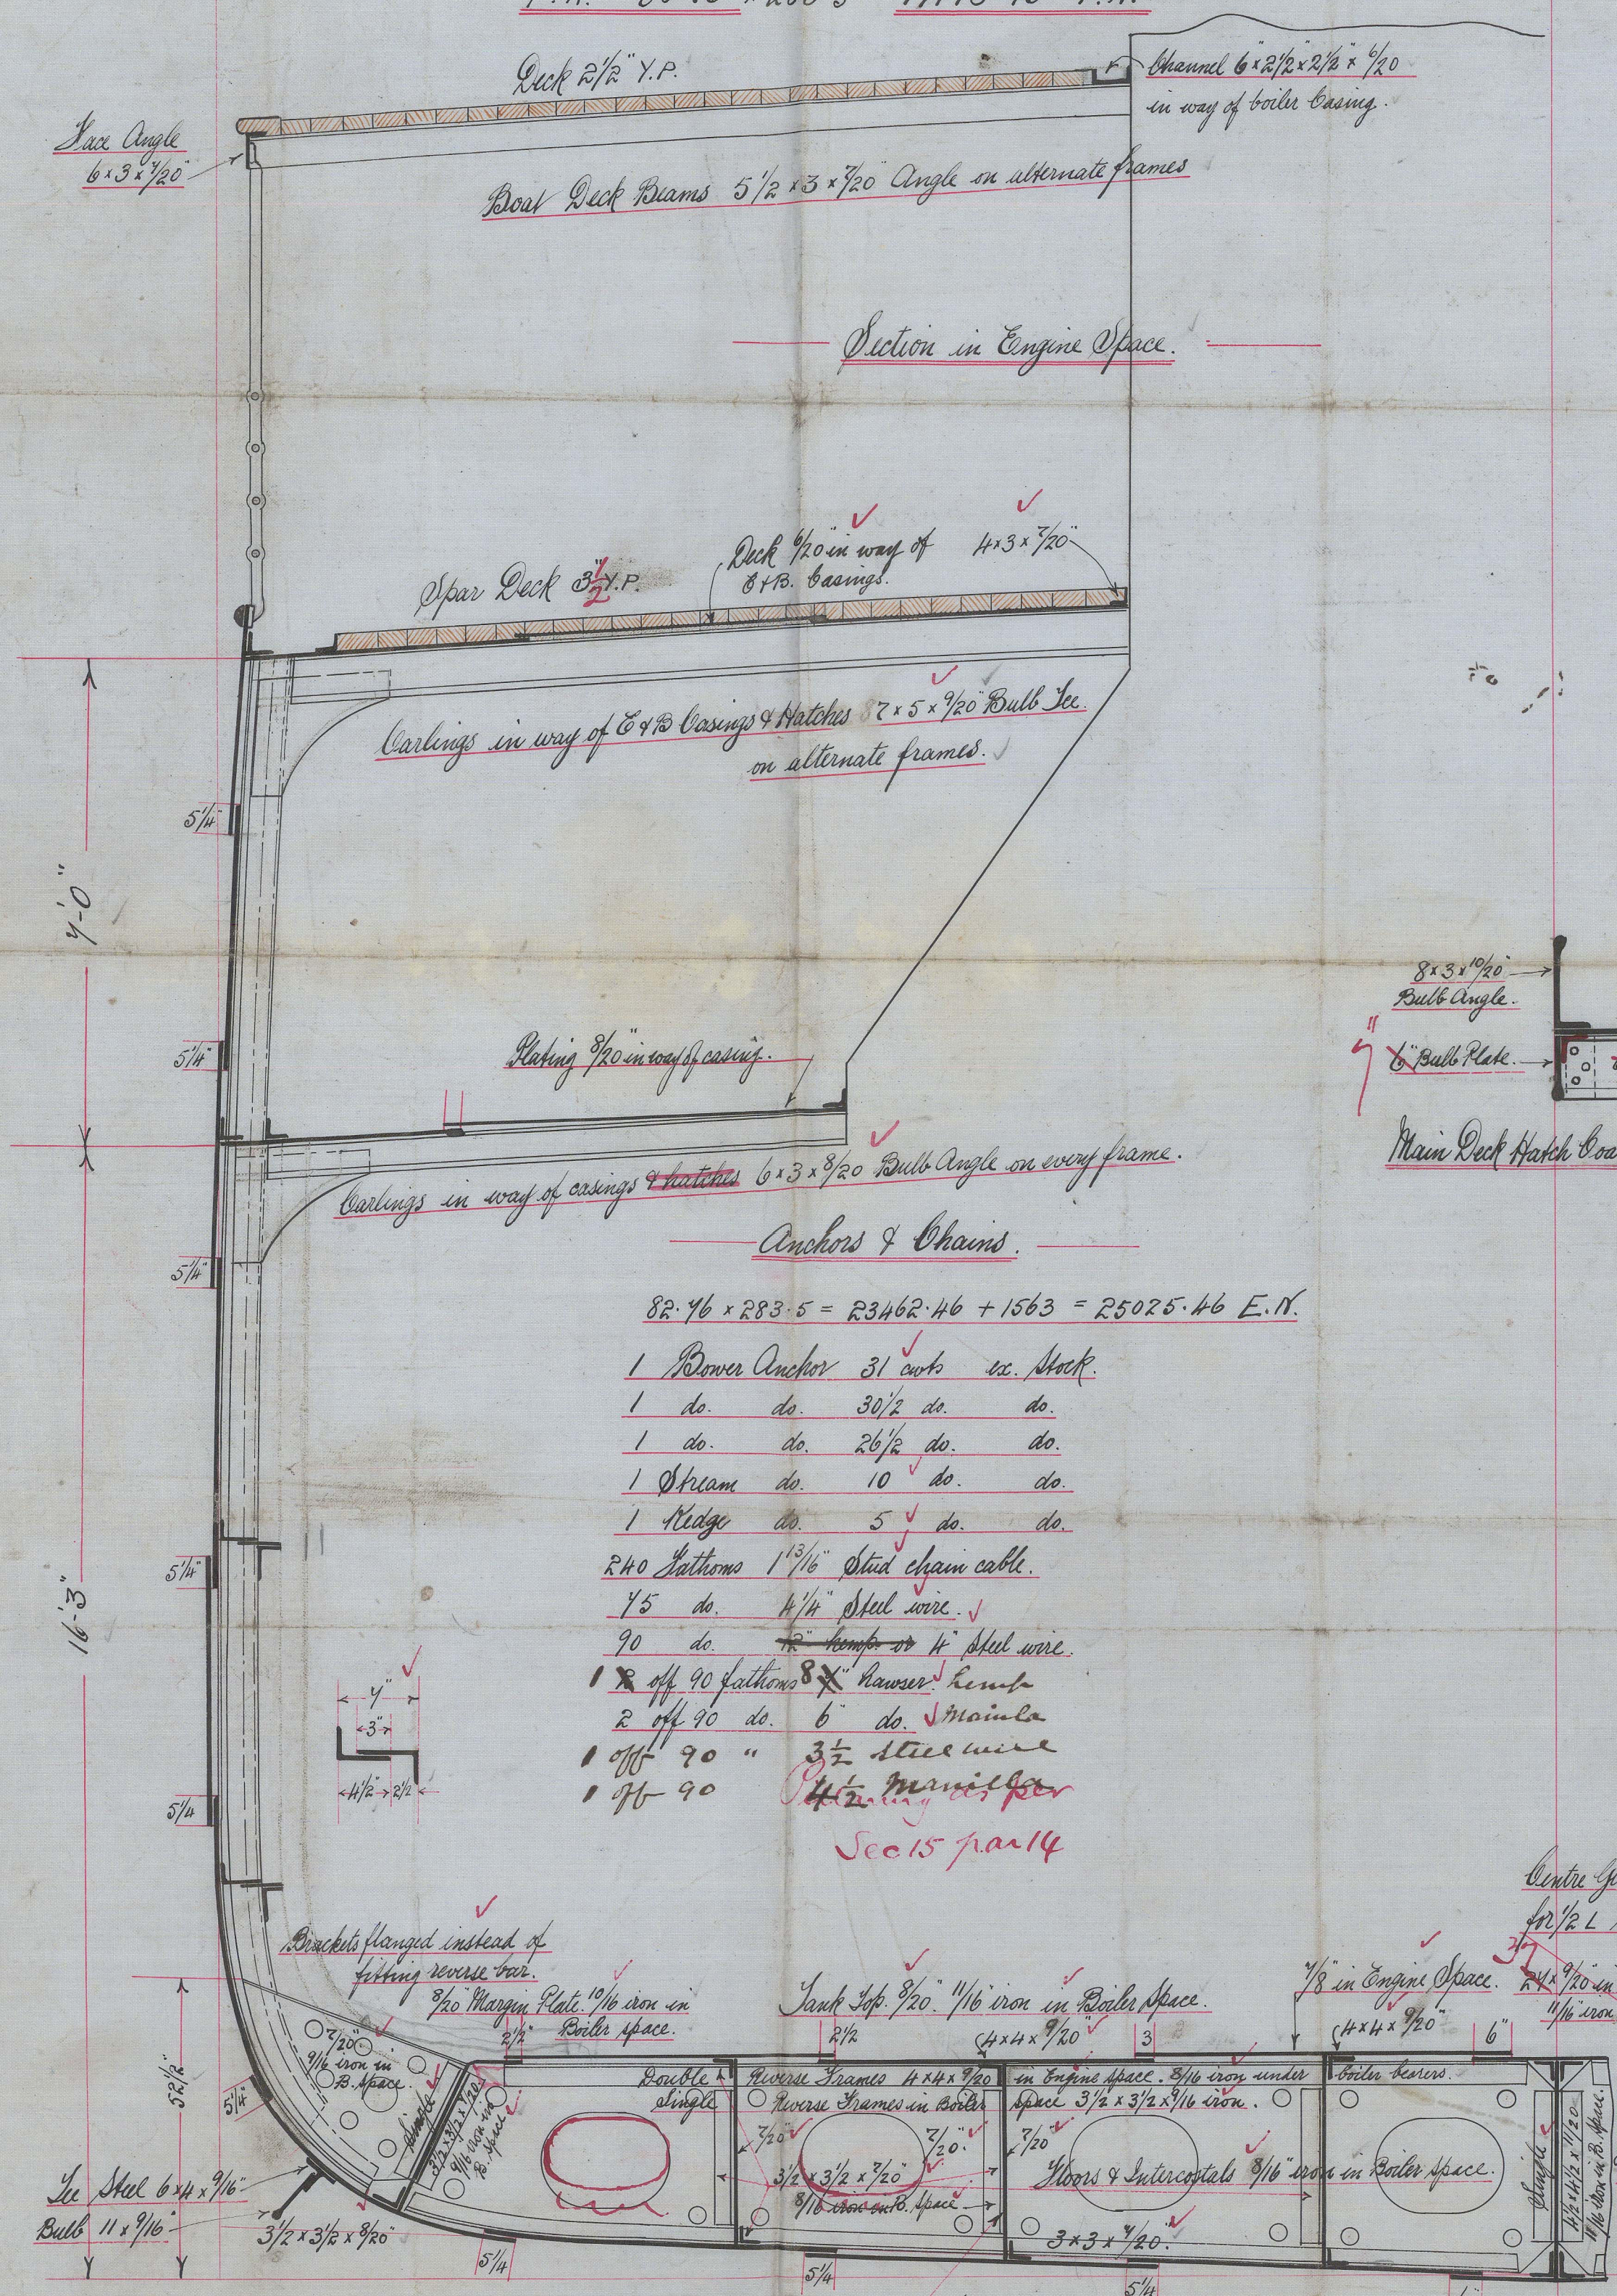

78221.20

quadruple riveted for 2 L when over rule width

quadruple riveted for 2 L when over rule width

quadruple riveted for 2 L when over rule width

M/S Section
S.S. N^o 287
Grangemouth & Greenock
Dockyard Co.

Leith

Awaji Maru

Leith Rept N^o

W1378-0032



© 2021

Lloyd's Register
Foundation