

1-STEEL DONKEY BOILER THUS FOR N^o 311


Donkey boilers
No 311.

Dunsmuir & Jackson
Amended Plan

s/s "Awaji Maru"

Ges. No. 24593

Letter Report No 11734

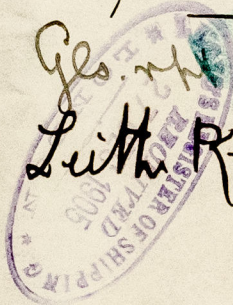

RECEIVED



© 2021

Lloyd's Register
Foundation

W1378-0034