

3.5.12

30.5.12

"Balsense"

MIDSHIP SECTION

STEEL SCREW FISHING VESSEL

Nº 542


SCALE $\frac{3}{4}$ " = 1 FOOT.

TO CLASS 100 A.I. FOR FISHING PURPOSES

DIMENSIONS 68'-6" B.P. x 17'-6" MLD x 6'-10" MOULDED

PLAN NO. 14-5-2

FOR ENCLOSURE TO
Messrs. Lloyd's Surveyors
Hull FROM
COCHRANE & SONS
SHIPBUILDERS, SELBY
DATE 30.5.12 RR

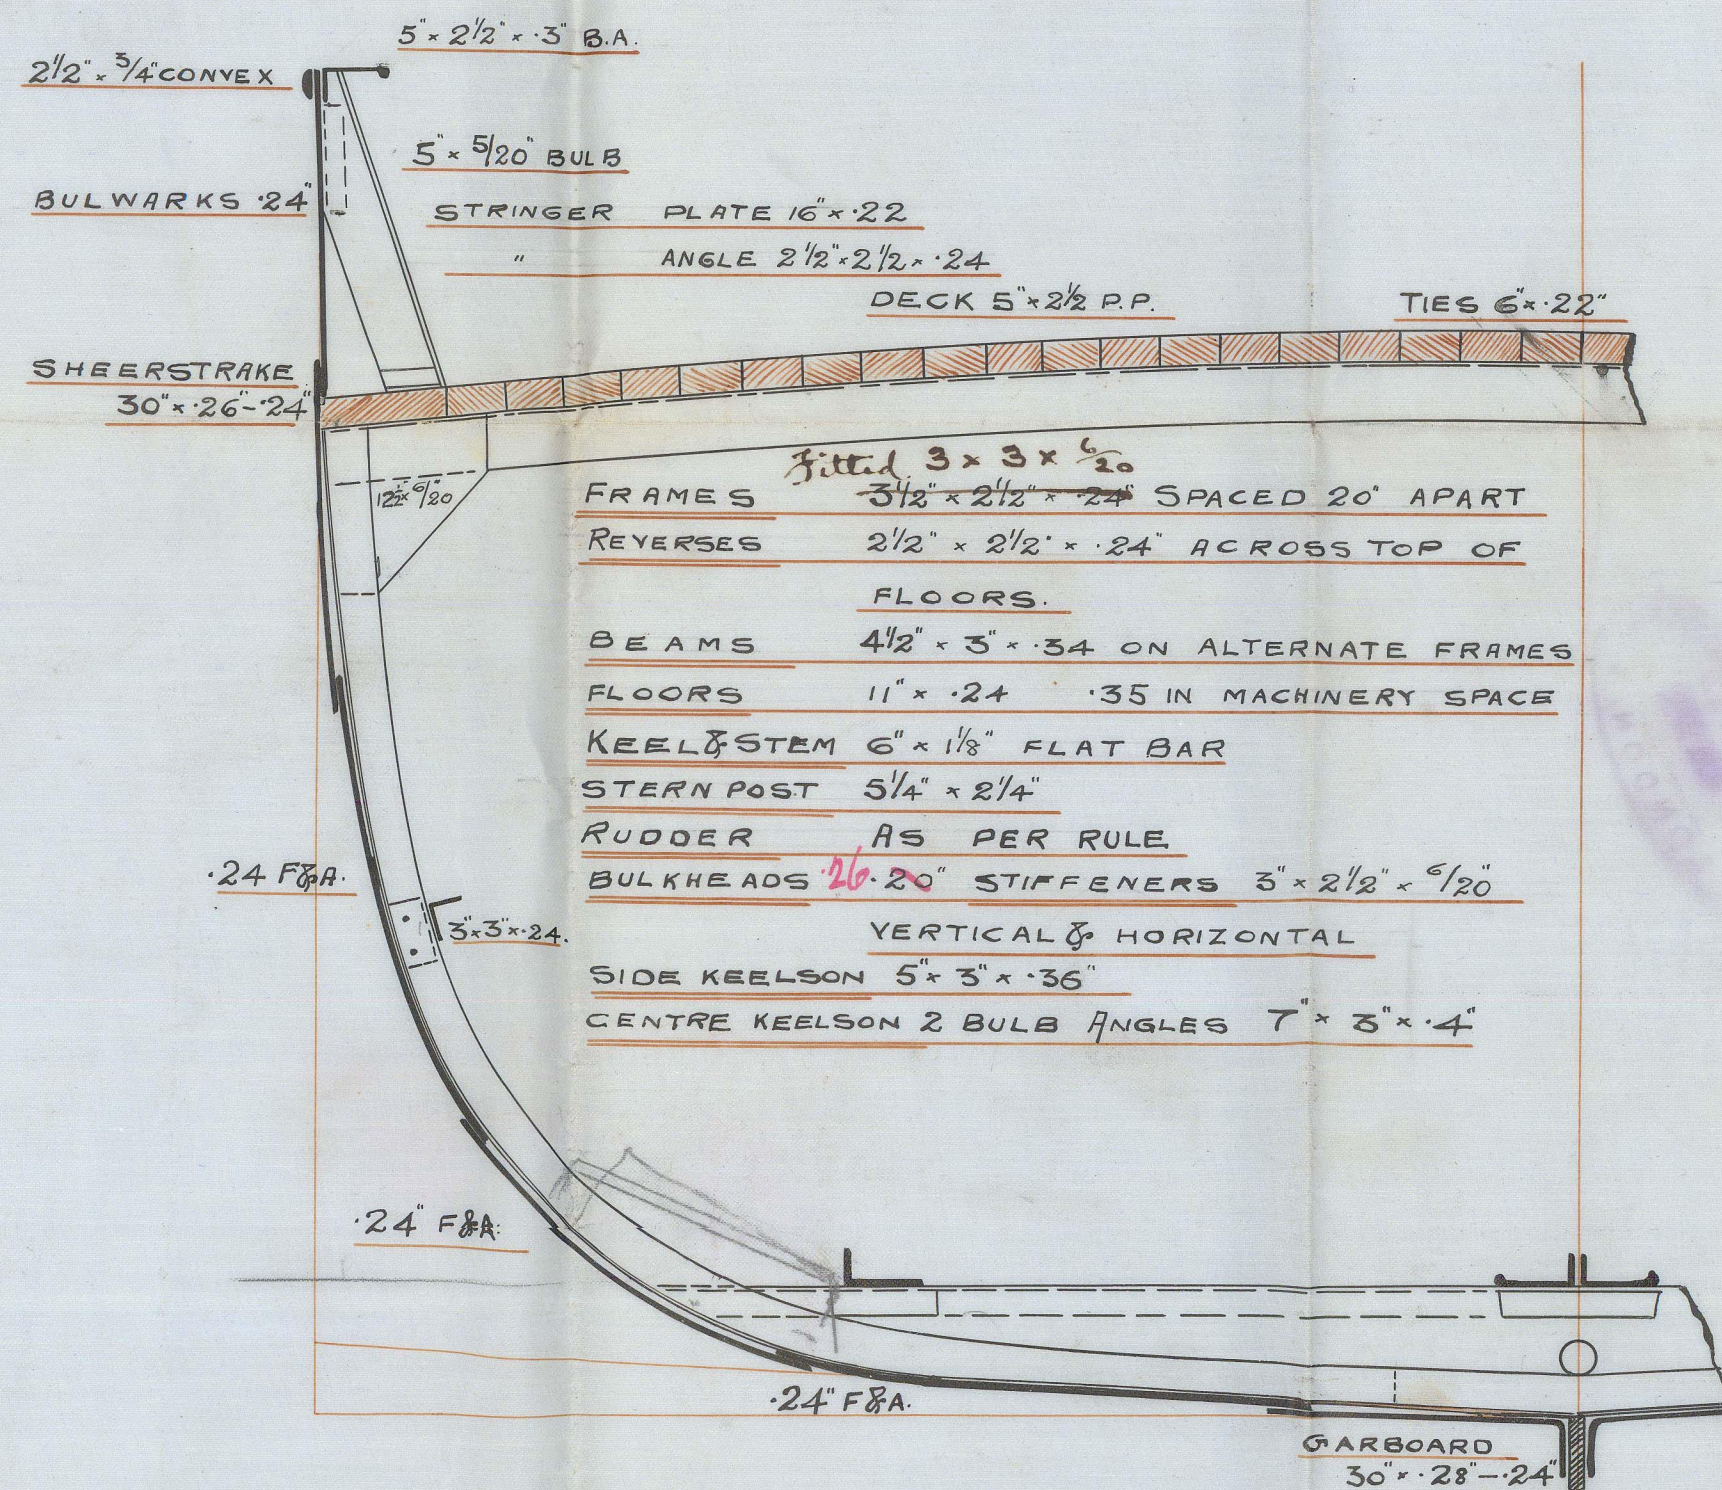

NUMERALS

B + D = 24.33

L x (B + D) = 1666.6

PROPORTIONS

$\frac{L}{D} = 10.02$ $\frac{L}{B} = 3.92$

EQUIPMENT

2 ANCHORS 2 1/2 CWT SE STOCK

1 " 1 1/2 " " "

60 FATHOMS 1/16" STUDLINK CABLE

60 " 4 1/2" HAWSER

60 " 2 1/2 WARP

RIVETING

BUTTS OF SHELL PLATING LAPPED & DOUBLE RIVETED EXCEPT GARBOARD & SHEERSTRAKE WHICH ARE TO BE STRAPPED & DOUBLE RIVETED LANDING EDGES TO BE DOUBLE RIVETED EXCEPT TOP EDGE OF SHEERSTRAKE WHICH IS SINGLE RIV. BUTTS OF STRINGER & TIE PLATES LAPPED & DOUBLE RIV.

C.B.
3.5.12.





Cochran & Sons


N. 542.

Midship Section.
"Balsense"

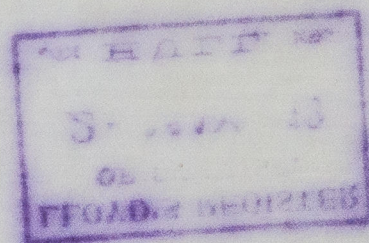

3-2-18

12

 

14











W1374-0073



Lloyd's Register
Foundation