

arrd p mnded  
 542 N  
 "Balsense"



01825. N. 148. 11. 11. 11.

3.5.12  
 30.5.12

"Balsense."

N<sup>o</sup> 542  
 PROFILE & DECK PLAN  
 DIMENSIONS 68'-6" B.P. x 17'-6" MLD x 6'-10" MLD  
 SCALE 1/4" = 1 FT.

PLAN No. 114-63  
 FOR ENCLOSURE TO  
 Messrs Lloyd's Surveyors  
 Hull FROM  
 GOSCHANE & SONS  
 SHIPBUILDERS, BEL  
 DATE 30/4/12 RK

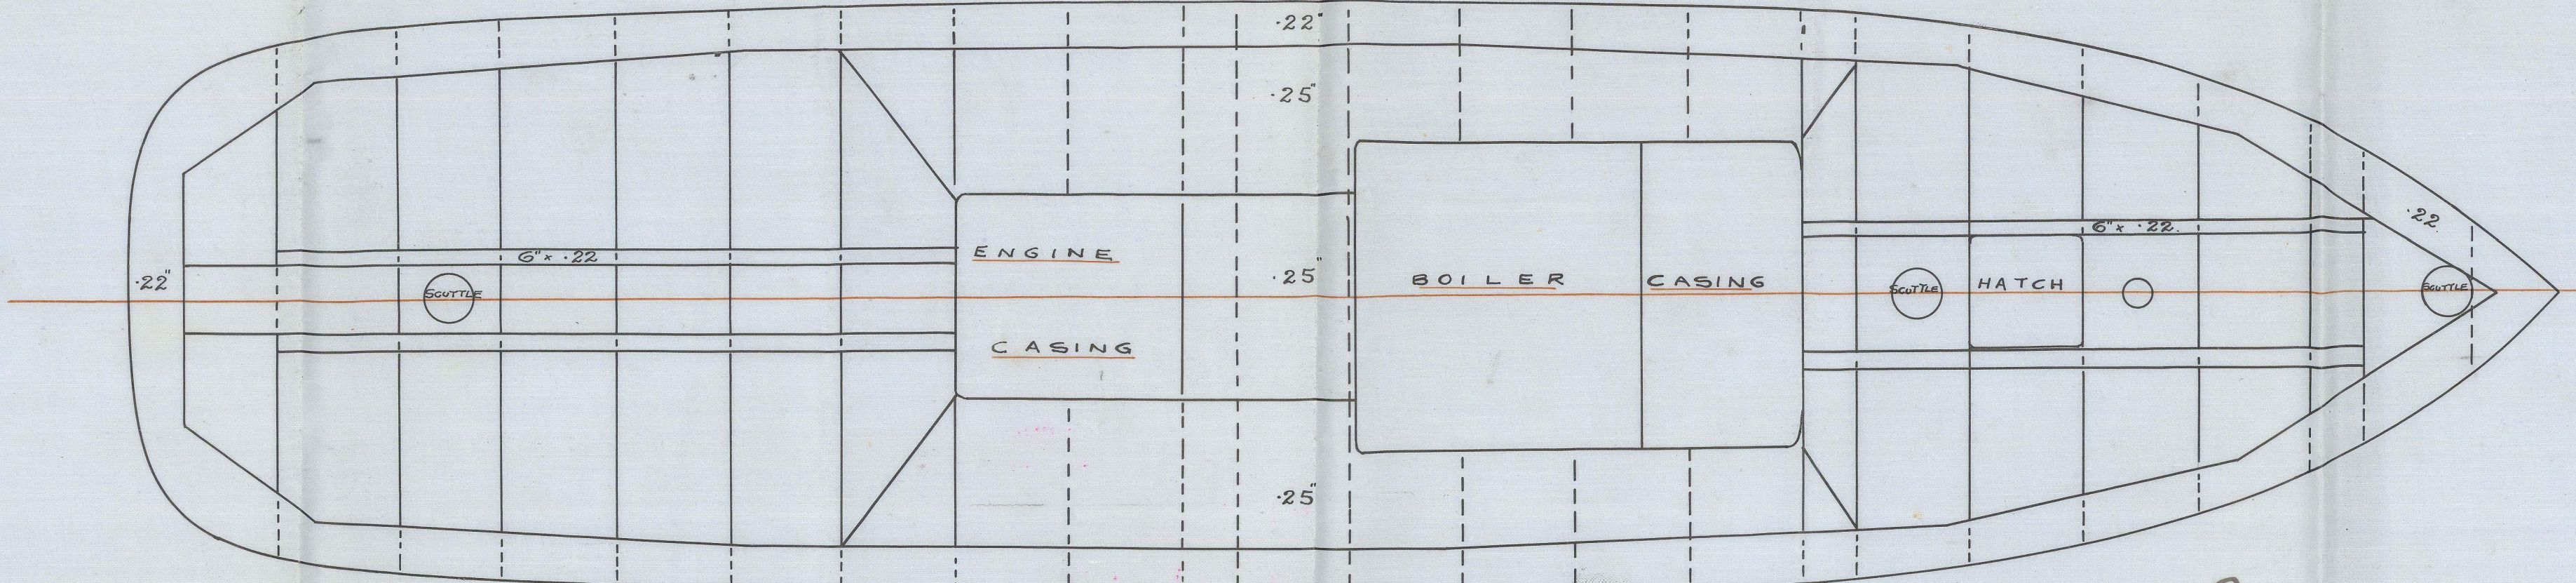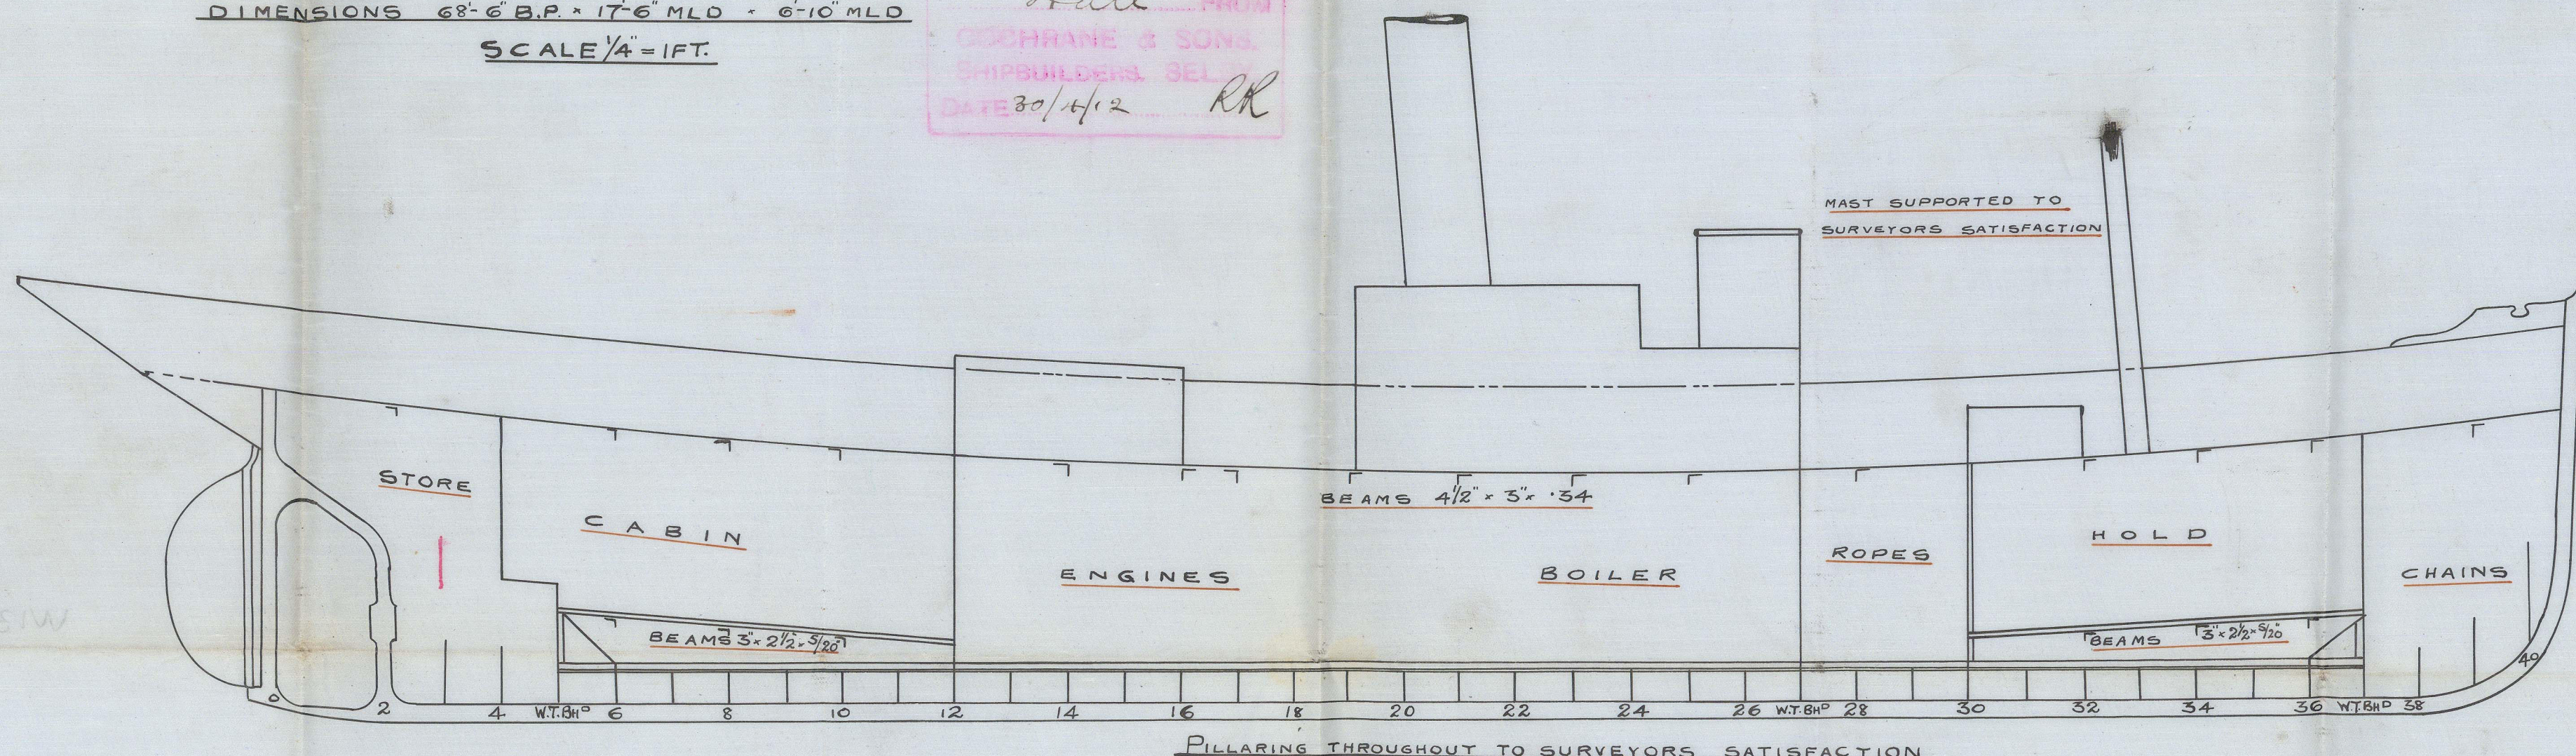

APR  
 2-5-12

C.B.  
 3.5.12.

LLOYD'S REGISTER  
 OF SHIPPING.  
 2-MAY 1912  
 HULL NO.



Cochrane & Sons.

Nº 542

Profile + Deck.  
"Balsense"

Hull Rph. No. 25310

W1378-0074



© 2021

Lloyd's Register  
Foundation