


STEEL BOILER

8'-0" DIA 8'-0" LONG 130 LBS W.P. LLOYDS

4444


RILEY BROS. (BOILERMAKERS) LTD.
STOCKTON ON TEES.

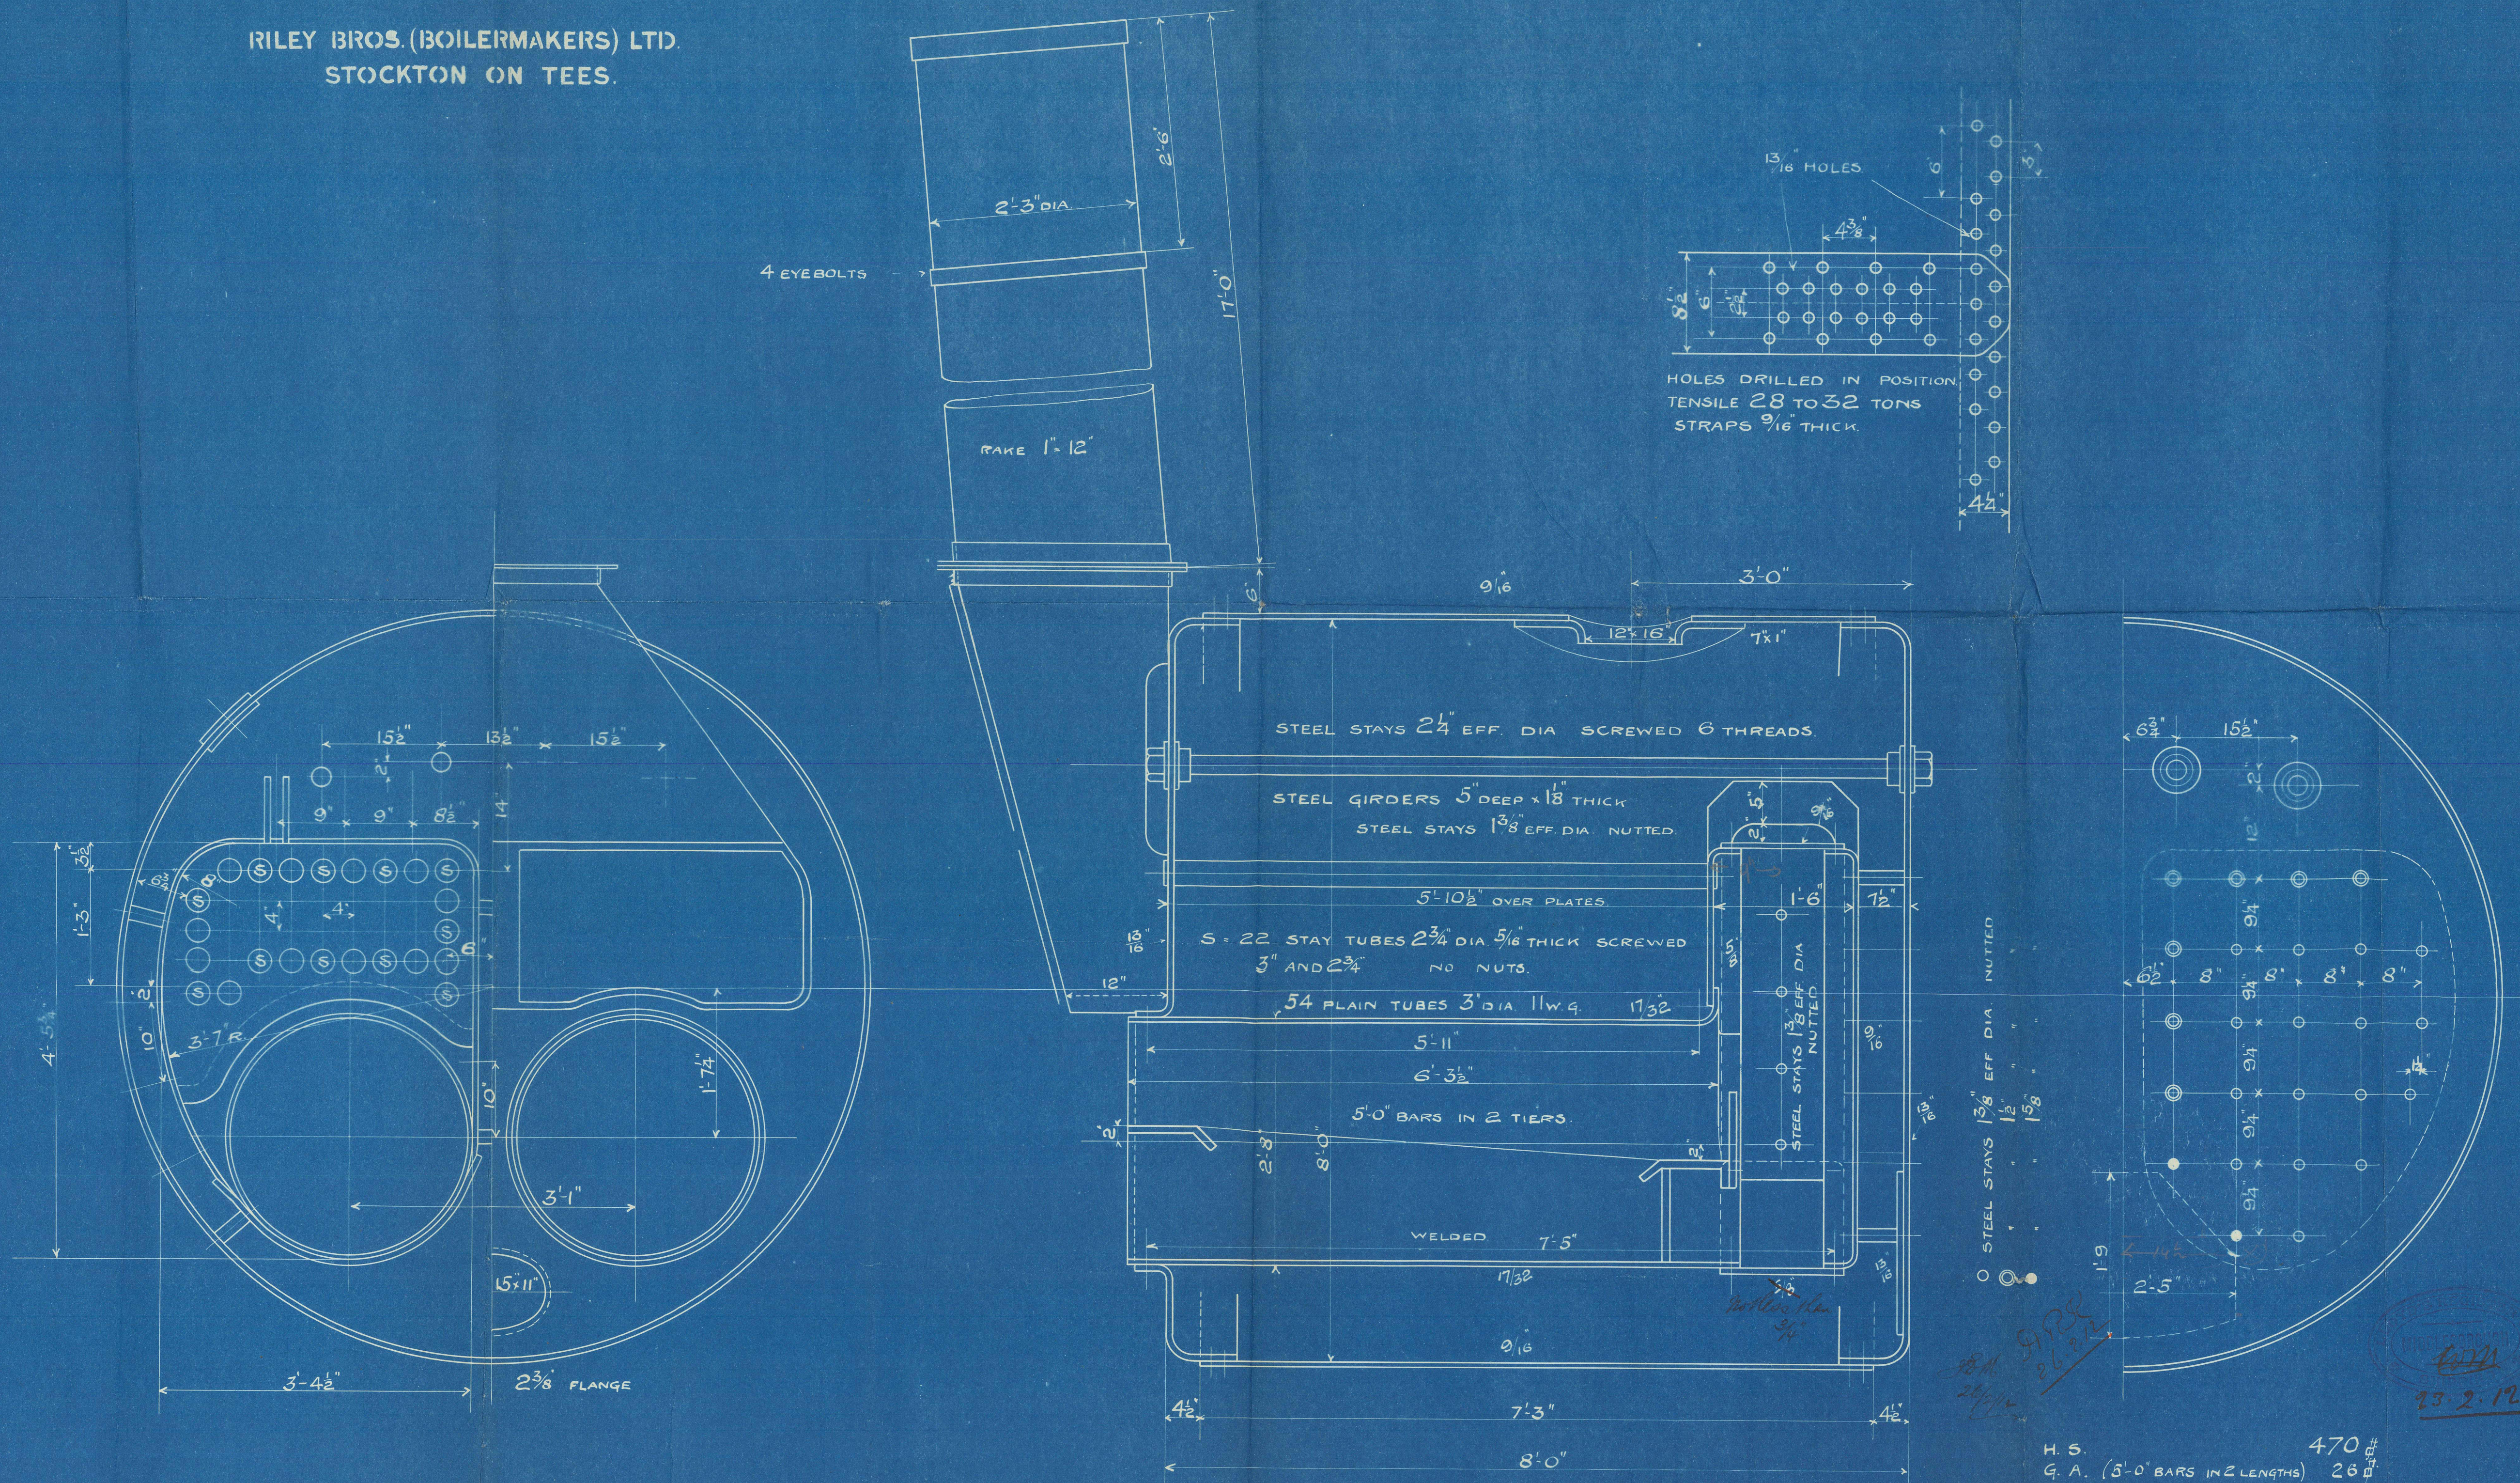

Thoson Riley Bros
Boiler No. 4444
for 4478

Thoson Brattree & Co

Working Press 130 lbs

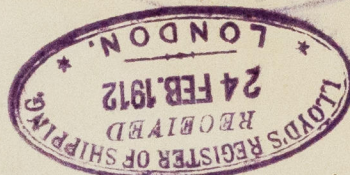

4444

No.	4892
LLOYD'S TEST	
260	lbs.
15.6.12 - W.M.	

Lab. Report
7/4/30

4478

No.	4901
LLOYD'S TEST	
260	lbs.
27.6.12 - WM	

Lab. Report
7/4/29

S. L. Balseuse

Skull - 25310