


2/3/27

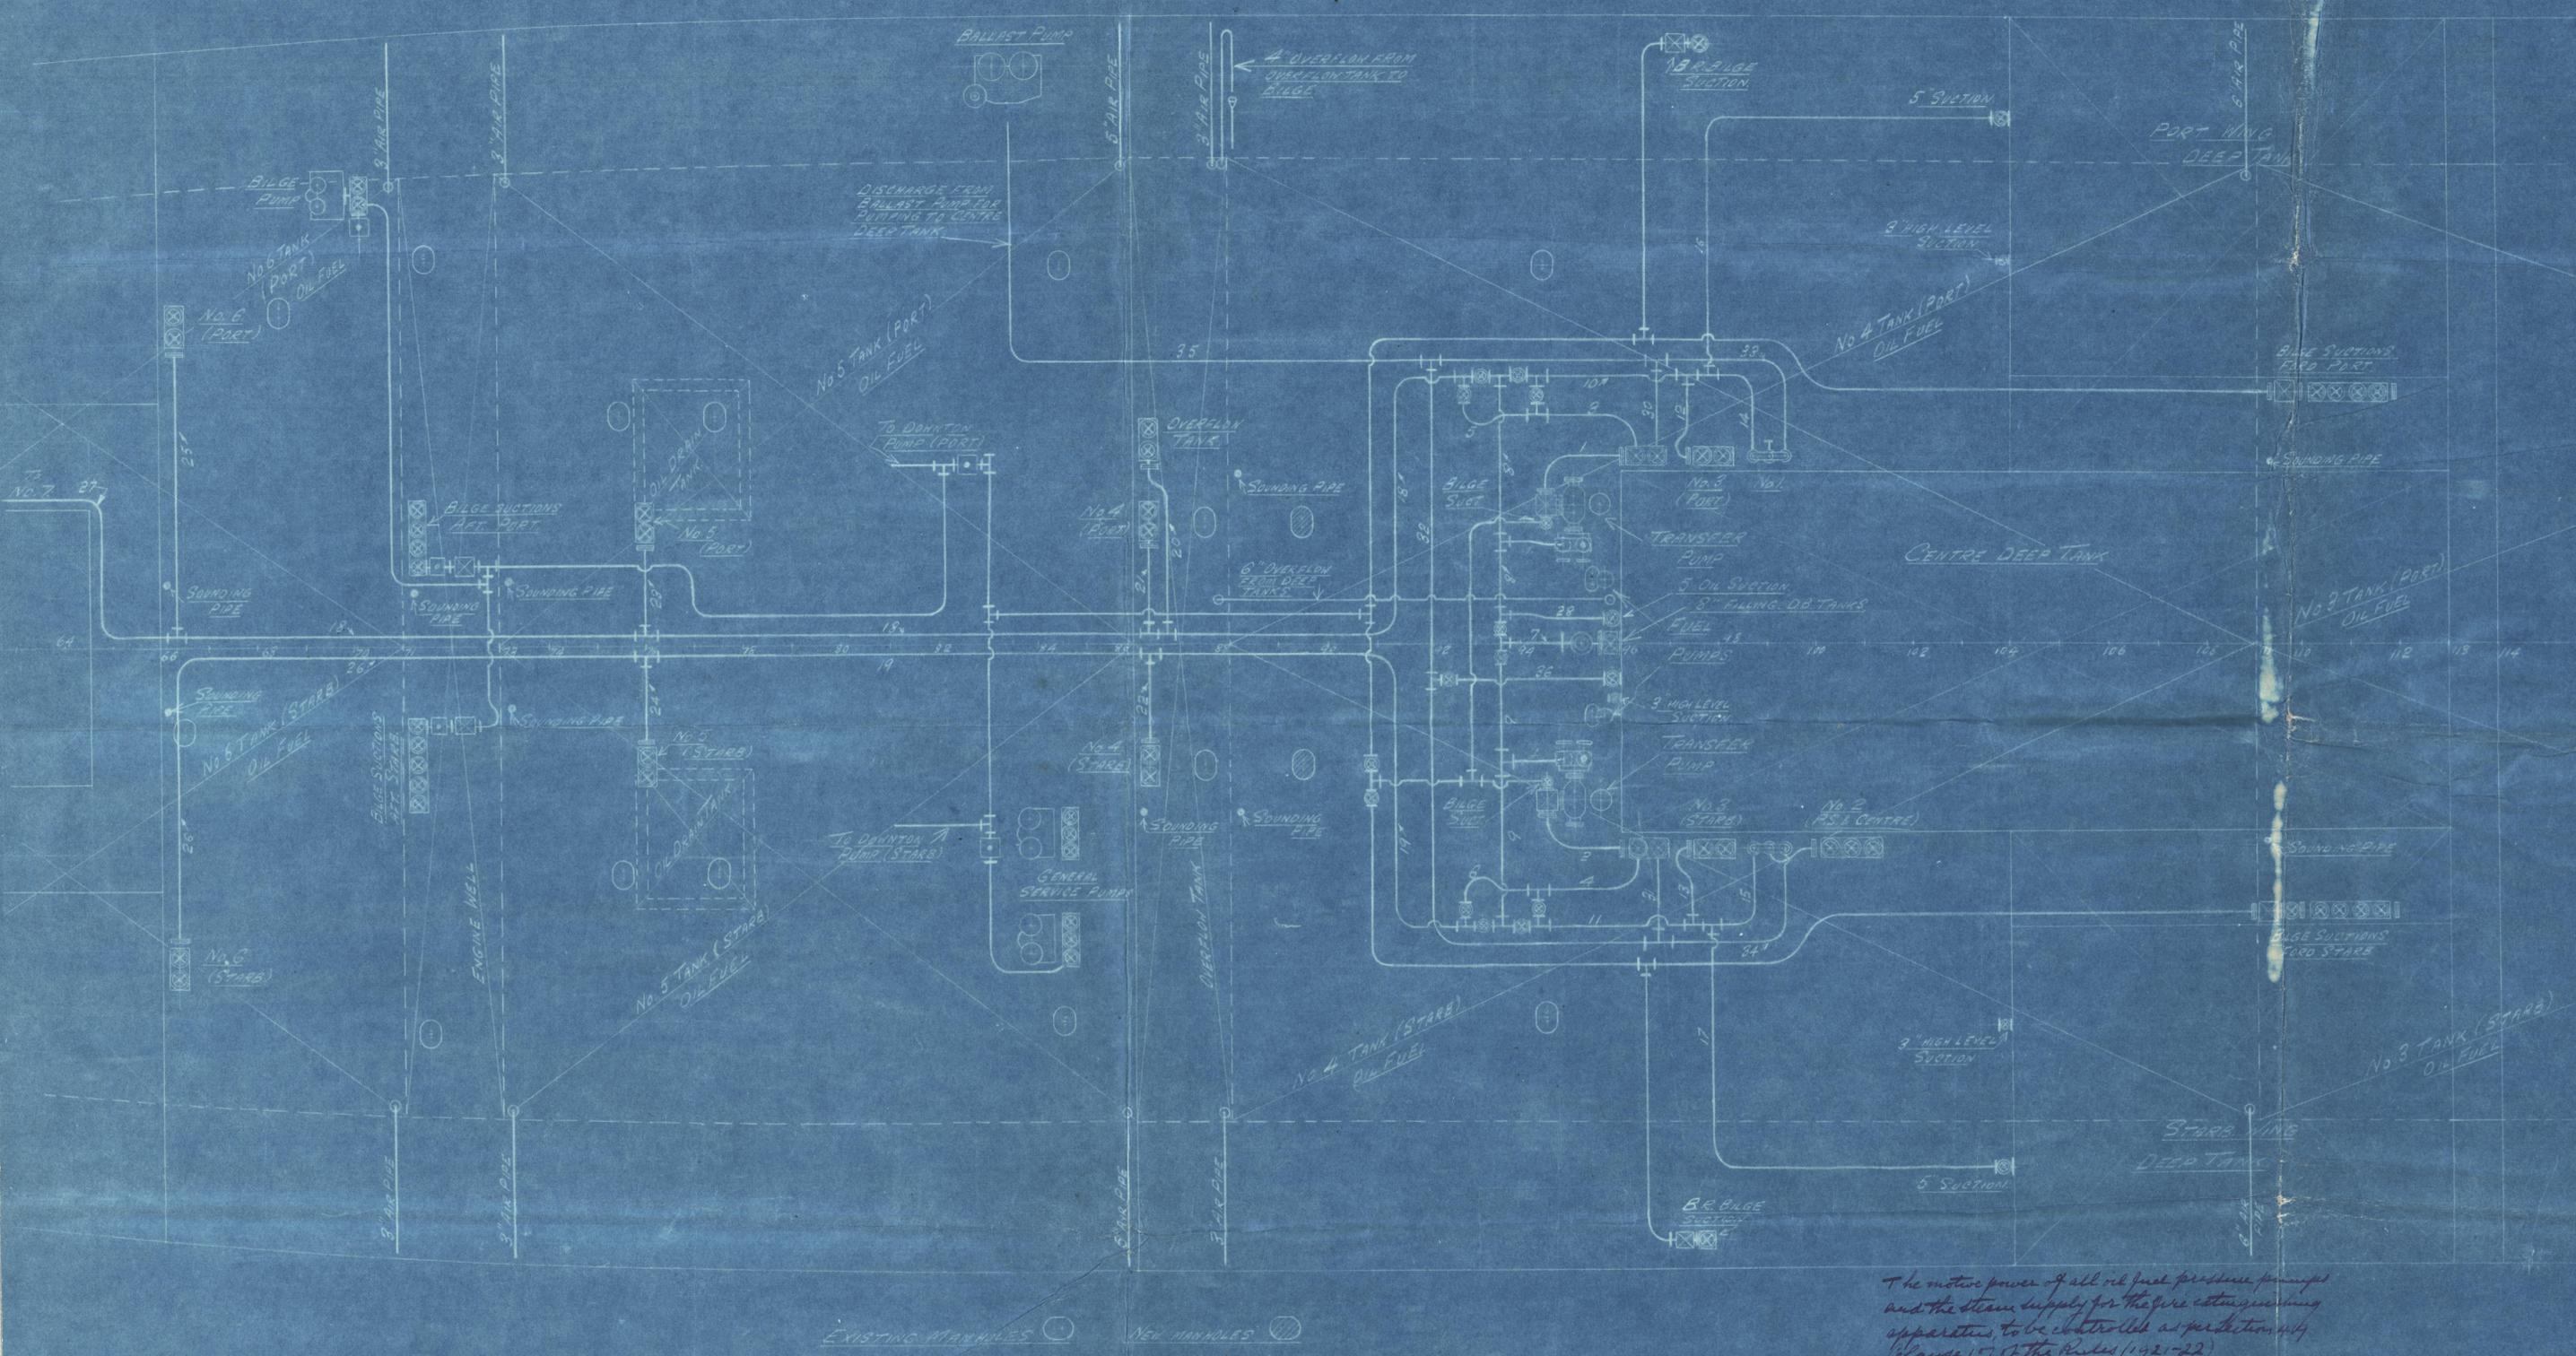

PROPOSED ARRANGEMENT OF OIL FUEL PLANT (DIAGRAMMATIC)

T.S.S. WESTMORELAND

SCALE 1/4\"/>

The motor power of all oil fuel pressure pumps and the steam supply for the fire extinguishing apparatus, to be controlled as per section 44 (Clause 17) of the Rules (1921-22)

The remaining requirements of section 39 of the rules (1921-22) to be complied with.

The flash point of the oil fuel to be above 150° F. and the remaining requirements of section 40 of the rules (1921-22) to be complied with.

Handwritten signature: A.T.G.
28-2-27.



Lloyd's Register
REG. NO. 8567

1927

W138-0060



© 2020

Lloyd's Register
Foundation