


SCALE $\frac{1}{4}" = 1$ FOOT.

SECTION THRO DTBHD 104.


EXISTING FLANGE CUT DOWN TO 4"

NEW 7" x 3 1/2" x 50 SHELL BAR.

SECTION AT O.T. BULKHEAD 113.
LOOKING FORWARD.

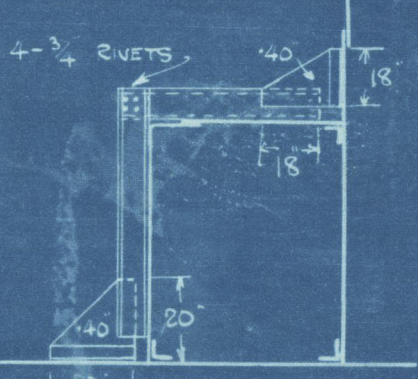

SECTION THRO
PIPE TUNNEL

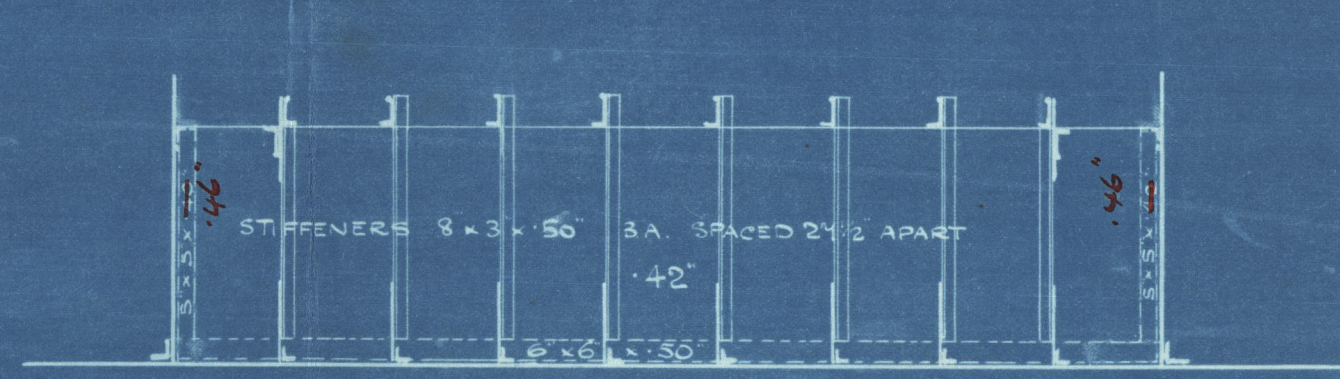

S.O. 1112.

Fal Rpt No 6668

W138-0062

S. S. WESTMORELAND

OIL FUEL DEEPTANK.



© 2020

Lloyd's Register
Foundation