
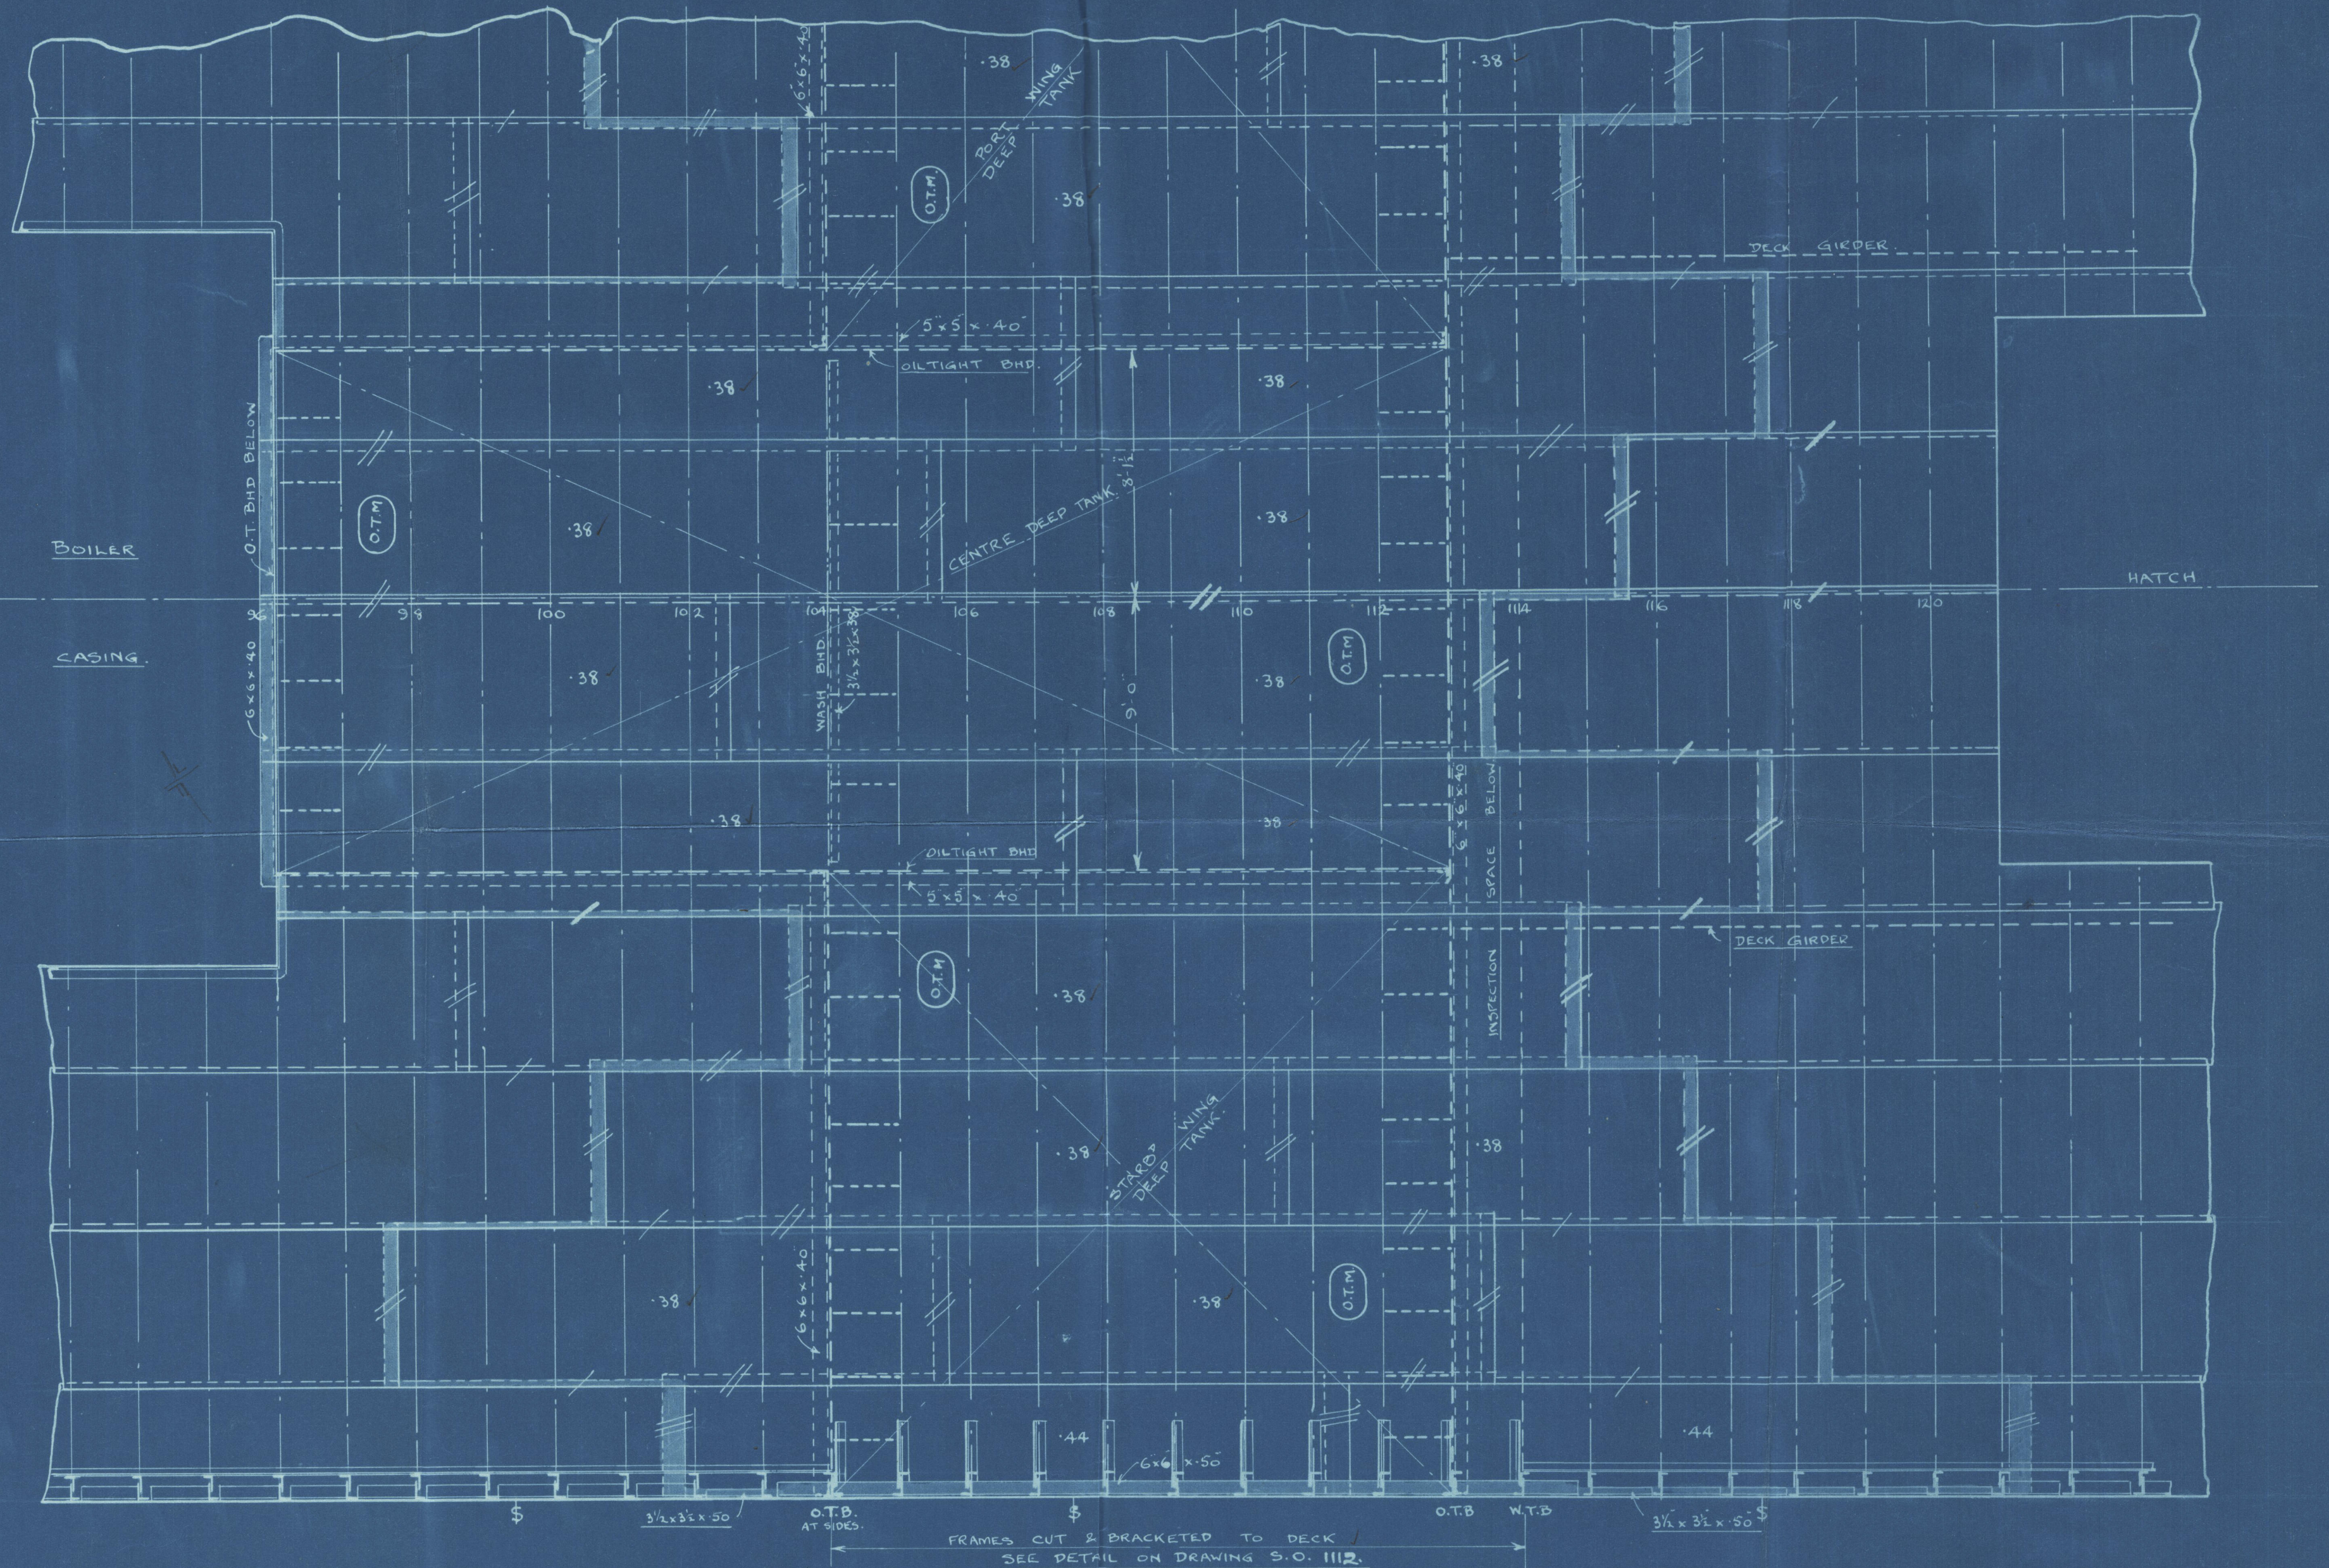


21/2/27

S.S. "WESTMORELAND."

UPPER DECK PLATING IN WAY OF OIL FUEL BUNKERS.

SCALE 1/4 INCH = 1 FOOT.

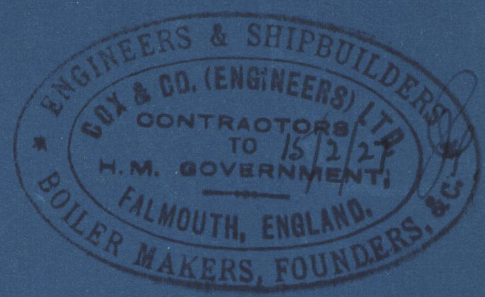

RIVETING.

SEAMS & BUTTS TO BE DOUBLE RIVETED ✓
 BUTTS OF STRINGER PLATES TREBLE RIVETED ✓
 ALL 3/4" DIA. RIVETS SPACED 3 1/2 DIAS. APART. ✓
 BOUNDARY ANGLES & DECK STRINGER ANGLE TO
 BE DOUBLE RIVETED 3/4" DIA RIVETS SPACED 5 DIAS. ✓

NOTES.

ALL MANHOLES TO BE MADE GASTIGHT ✓
 TANKS TO BE TESTED TO A HEIGHT OF 8' 7 1/2" ✓
 ABOVE CROWN. HEIGHT OF OVERFLOW 4'-6" ✓
 EXTENT OF NEW WORK SHOWN THUS:

Handwritten notes:
 21.2.27
 15.1.27

S. S. WESTMORELAND

UPPER DECK PLATING IN WAY OF OIL FUEL BUNKER

Fal Rpt - No 6668

W138-0066



© 2020

Lloyd's Register
Foundation