


MODIFIED ARRANGEMENT OF MANHOLE DOORS MAIN BOILERS No 492

SCALE 1" = 1 FOOT.

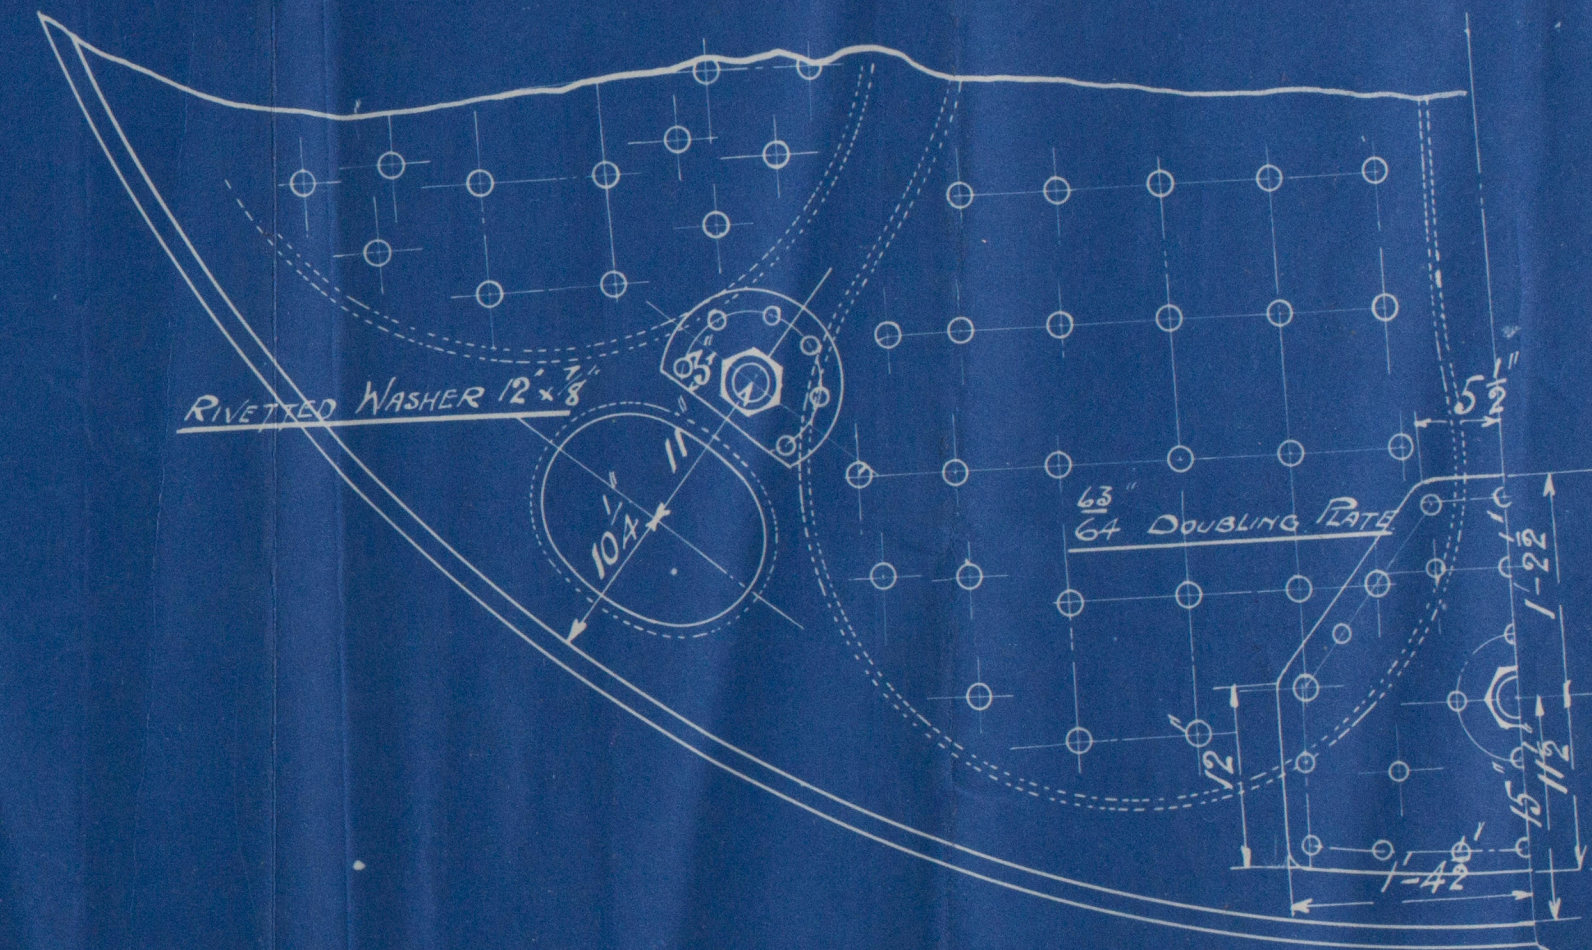

LR

HC
15.1.11