

7.1.36

No 983. FRAMING & BULKHEAD PROFILE.


Scale 1/8" = 1 Foot.

DIMS 230' B.P. x ^{39'}38' MLD x 22' MLD TO UPPER DK (SHELTER DK)

TO CLASS LLOYDS 100 A.I. with *mk.*

DRAFT CORRESPONDS TO A COMPLETE SUPERSTRUCTURE
VESSEL HAVING A TONNAGE OPENING.

SECTIONS N.B.S.

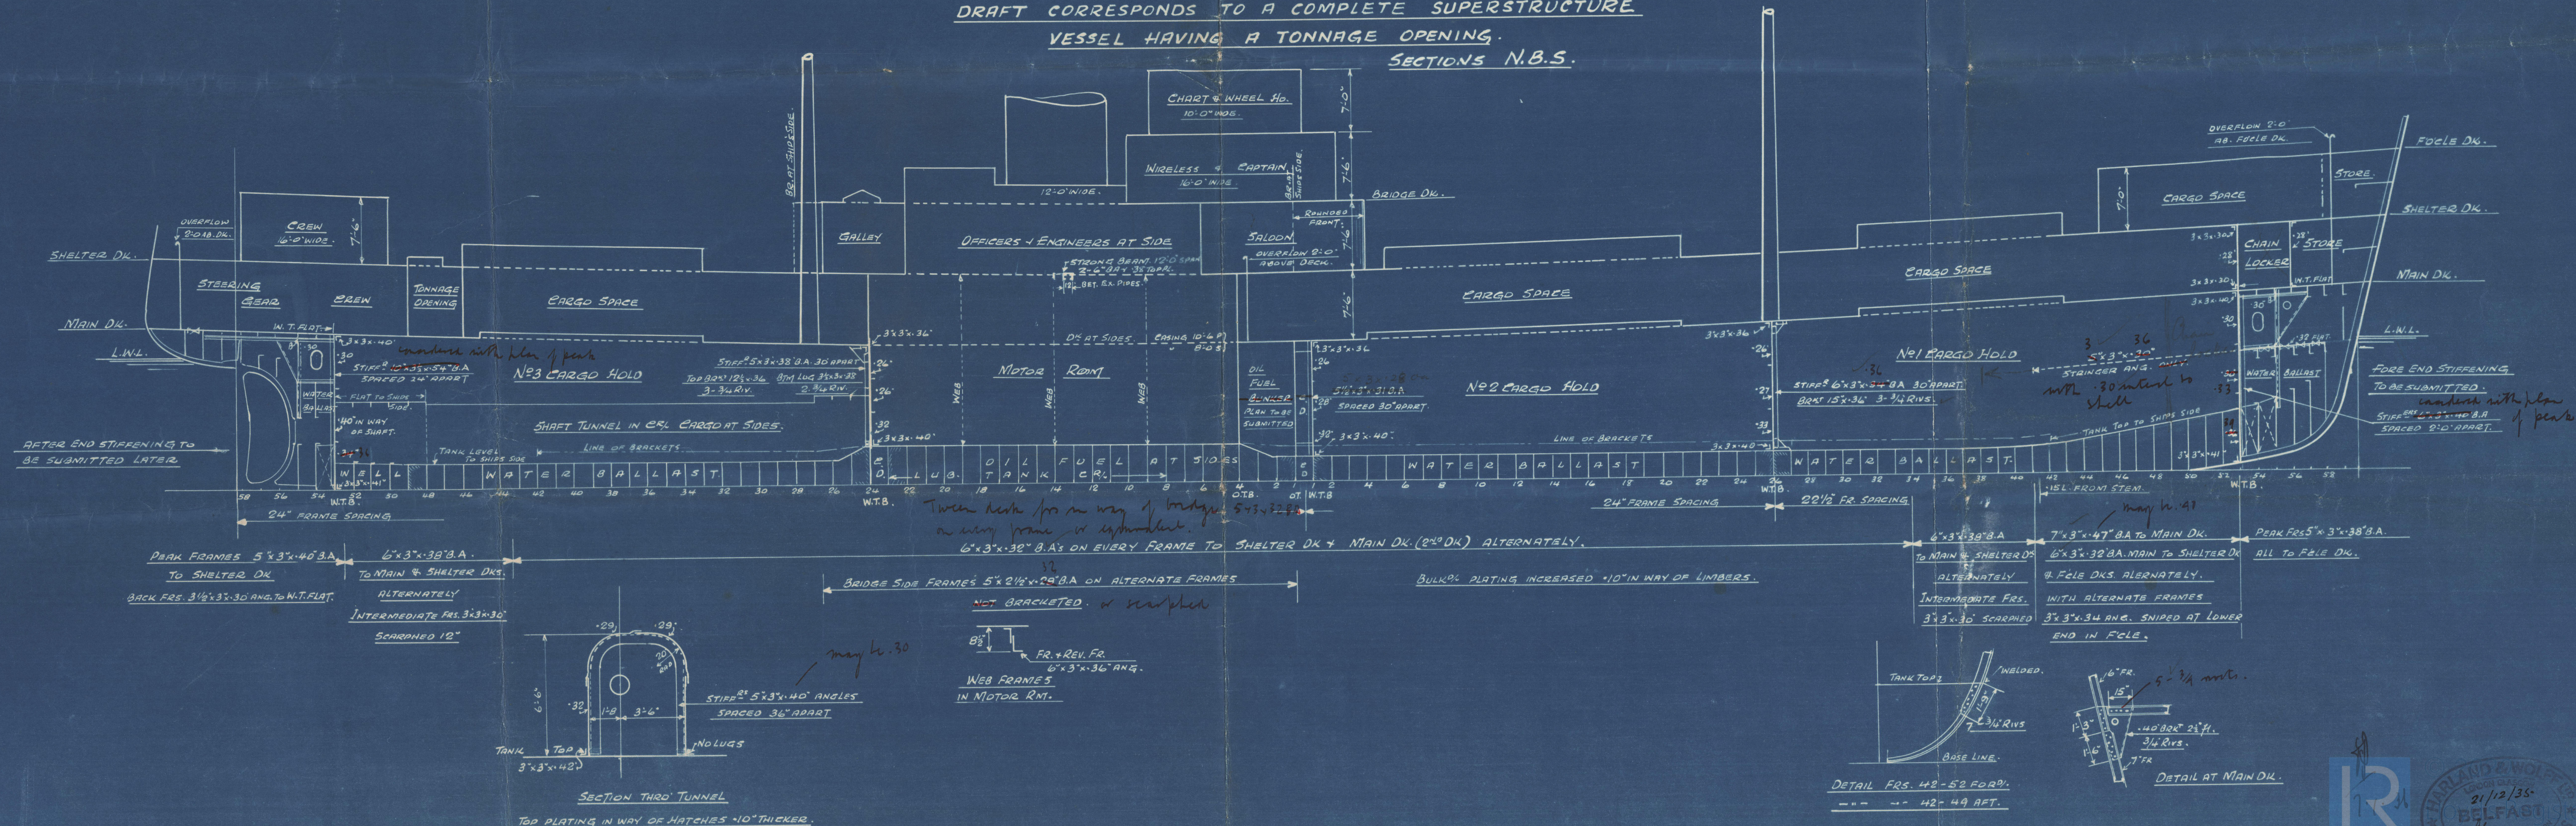

W38-0186



Harland & Wolff

N^o 983

" WALMER CASTLE "

Tramway & Bulwark Profile

Bel-11852.

(2)

W138-0186



© 2020

Lloyd's Register
Foundation