

7.1.36

·No 983· ·MIDSHIP SECTION·

Scale 1/2 Inch = 17 feet.


NUMERAL	
D.	22.0
L x D.	506.0
L x (B + D)	230 x (38 + 22) 13,800
d	11.83
L/D.	10.45

DIMENSIONS 230' B.P. x 38' M⁴ x 22' TO UPPER D^K (SHELTER D^K)

TO CLASS LLOYDS 100 A.I. *with plan*

DRAFT CORRESPONDS TO A COMPLETE SUPERSTRUCTURE
VESSEL HAVING A TONNAGE OPENING.

SECTIONS N.B.S.

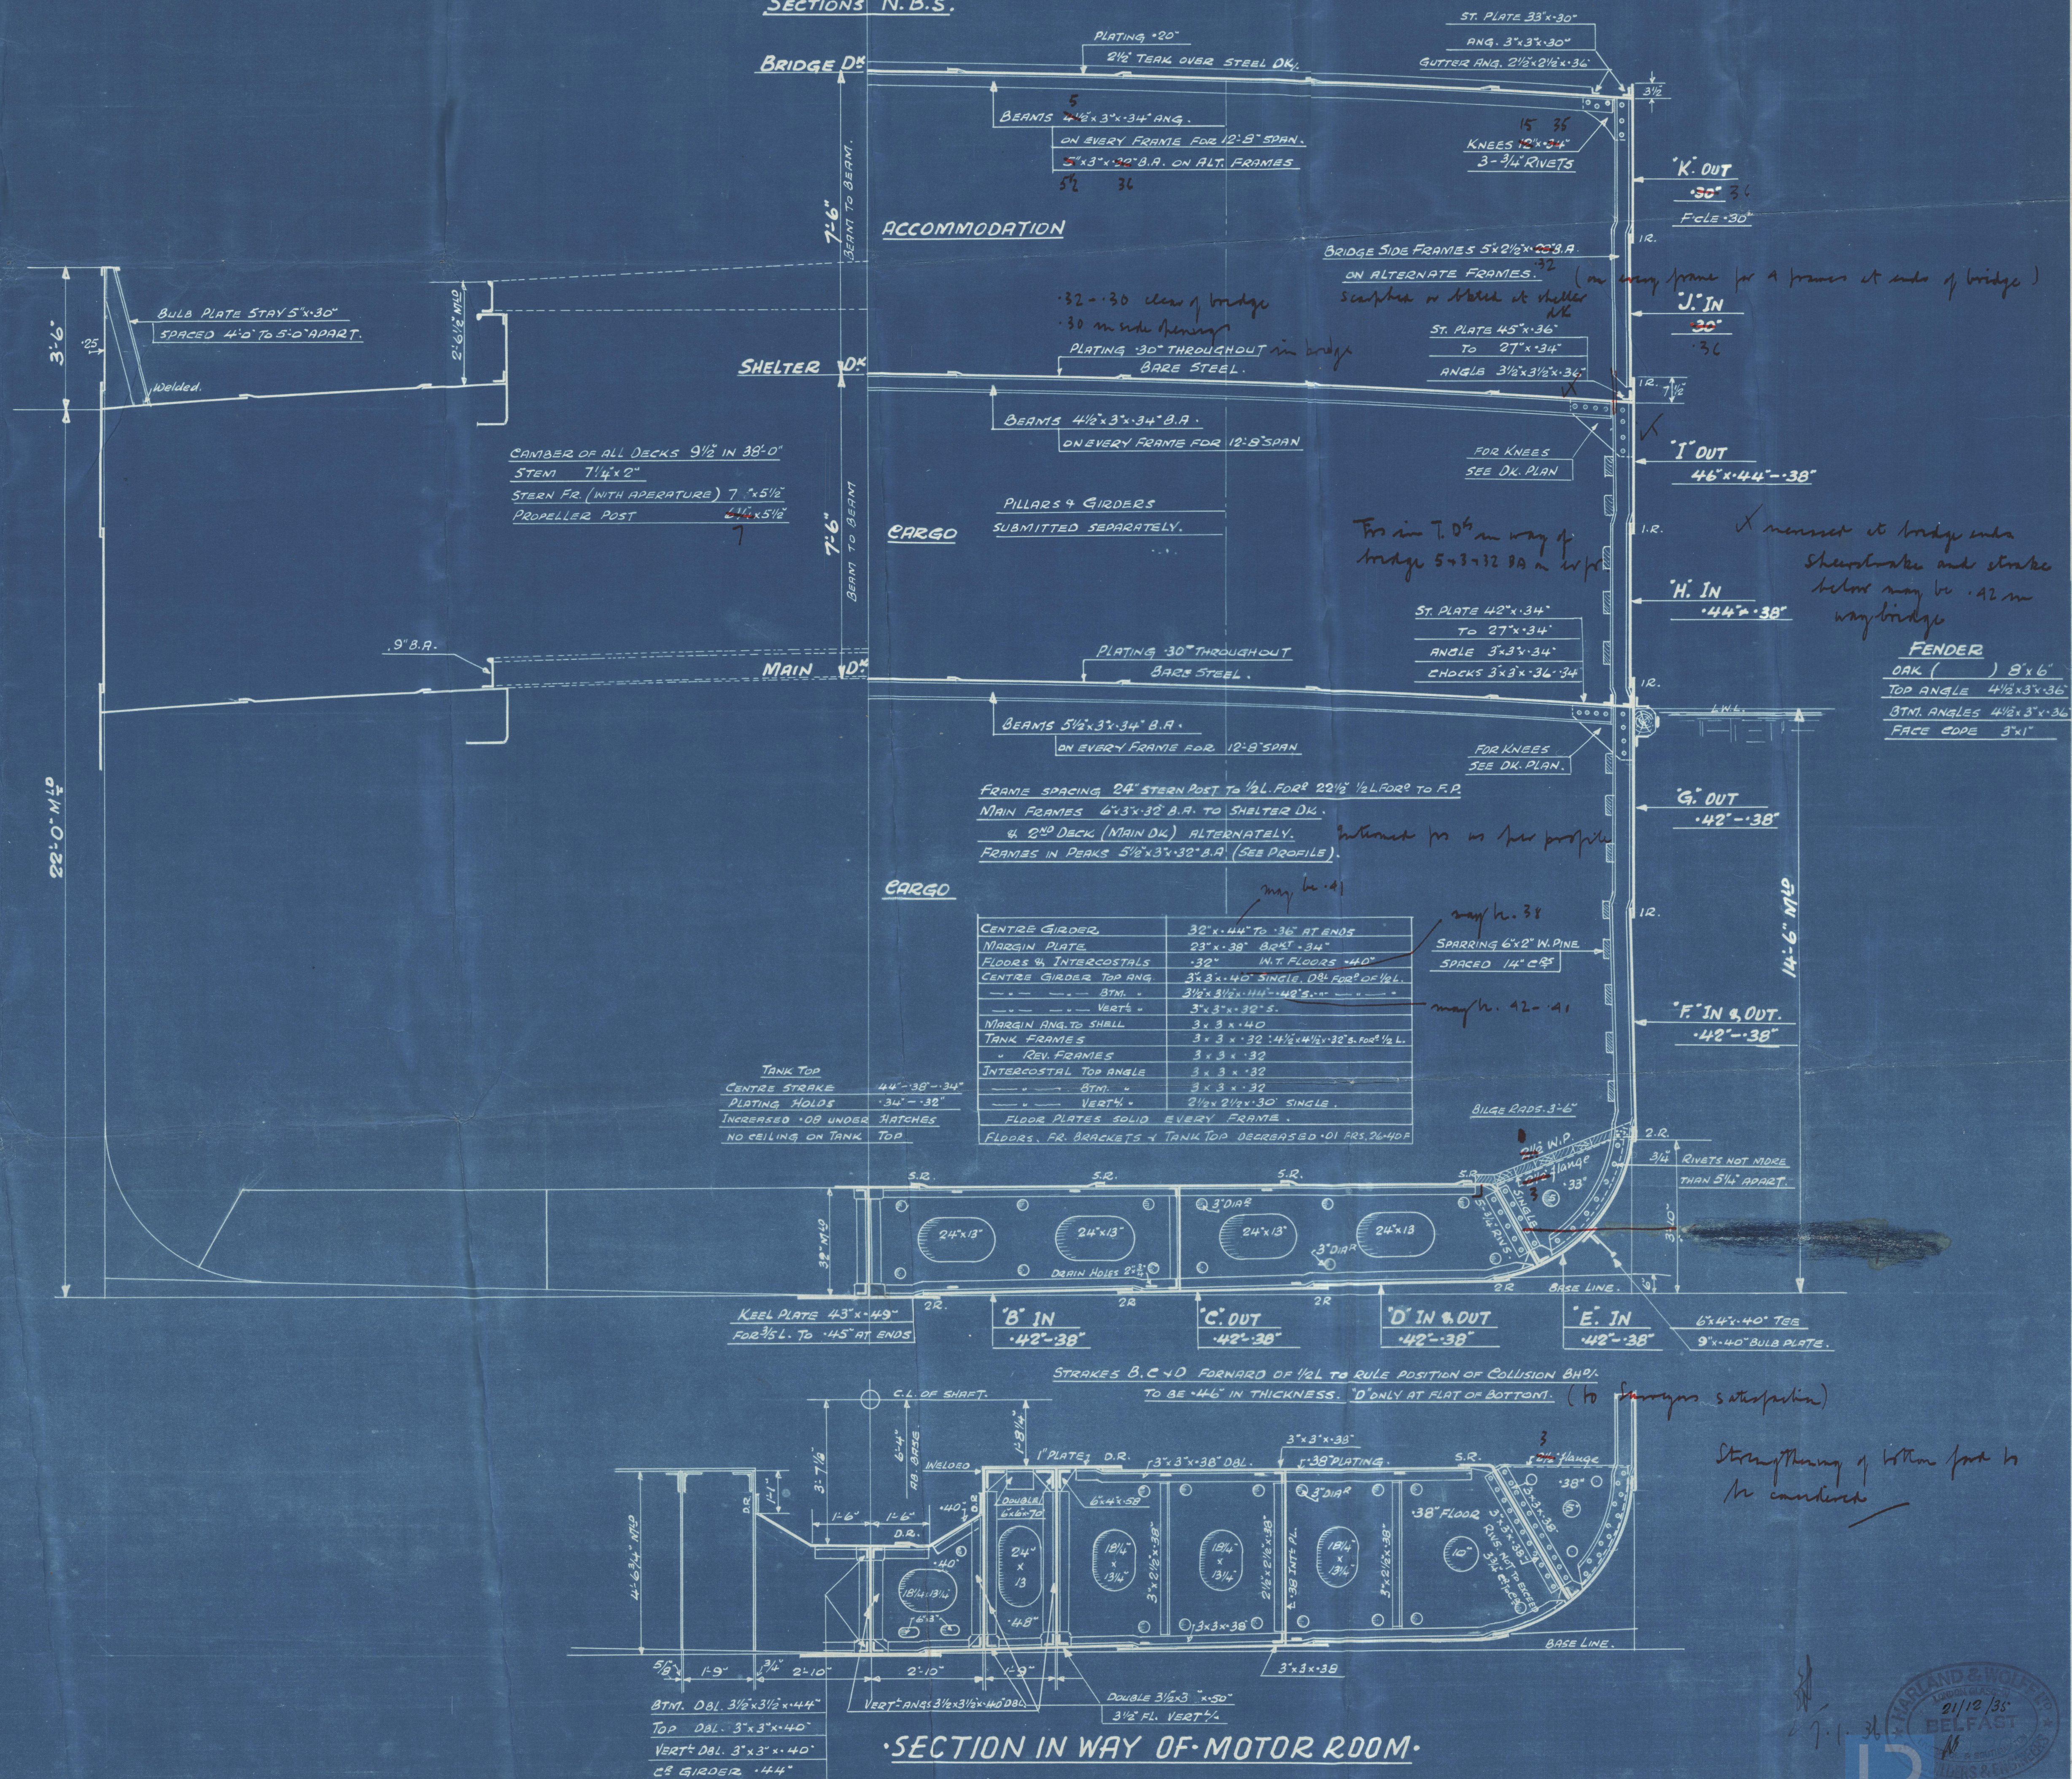


Harland & Wolff

N° 983

"WALMER CASTLE"

Midship Section

Bel. 11852

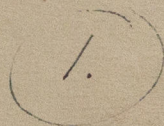

W189-0190



© 2020

Lloyd's Register
Foundation