

5/7/18

MIDSHIP SECTION OF WOODEN BARQUE

140 BP x 30 OVER x 15-0 MLD

1/2" SCALE

To class A T LLOYDS FOR 16 YEARS TEAK THROUGH

OUTSIDE PLANKING FASTENED WITH TEAK TREENAILS

UNDER 400 TONS

TONNAGE U/D 380

SNEERFORD 4-0

AFT 1-6

GROSS TON 418-5

BOLTS

KEEL - SCARP BOLTS 1/4" 7 BOLTS IN SCARP

KEELSON - 1" 1/2" KEEL AT EACH FLOOR

POOP KEELSON - 1" 1/2"

HEEL & NEE, STEWSON & DEADWOOD 1 3/16"

BILGE, LINBER STRAKE & THRO BUTT BOLTS 1/2" OTHER BUTTS 1/4"

WATERWAY & SHELF BOLTS IN & OUT 1/2"

HANGING ANCE ARM BOLTS 1/2" THROAT 1/4"

HARDWOOD TREENAILS 1/4"

INNER WATERWAY 2 VERTICAL BOLTS IN CH. BEAMING

KEEL RIDER BOLTS 1/2" NOT MORE THAN 24" APART

DOWELS

ALL DOWELS TO BE AT LEAST 1/4" OF THE MOULDING OF THE TIMBER WHERE FITTED

TREENAILS

1/4" TO BE STRAIGHT & CIRCULAR OF TEAK. ALL TO BE EITHER CAULKED OR WEDGED OUTSIDE

EQUIPMENT

2 BOWER ANCHORS 13 1/2 CWTs EX STOCK 68 1/2 CWT

1 STREAM " 11 1/2 " " " "


1 KEDGE 2 1/2 " " " "

210 FT 1 1/4" STUD CHAIN CABLE

60 " 1/4" STREAM CHAIN

75 " 8" TOWLINE

80 " 5 1/2" HAUSER

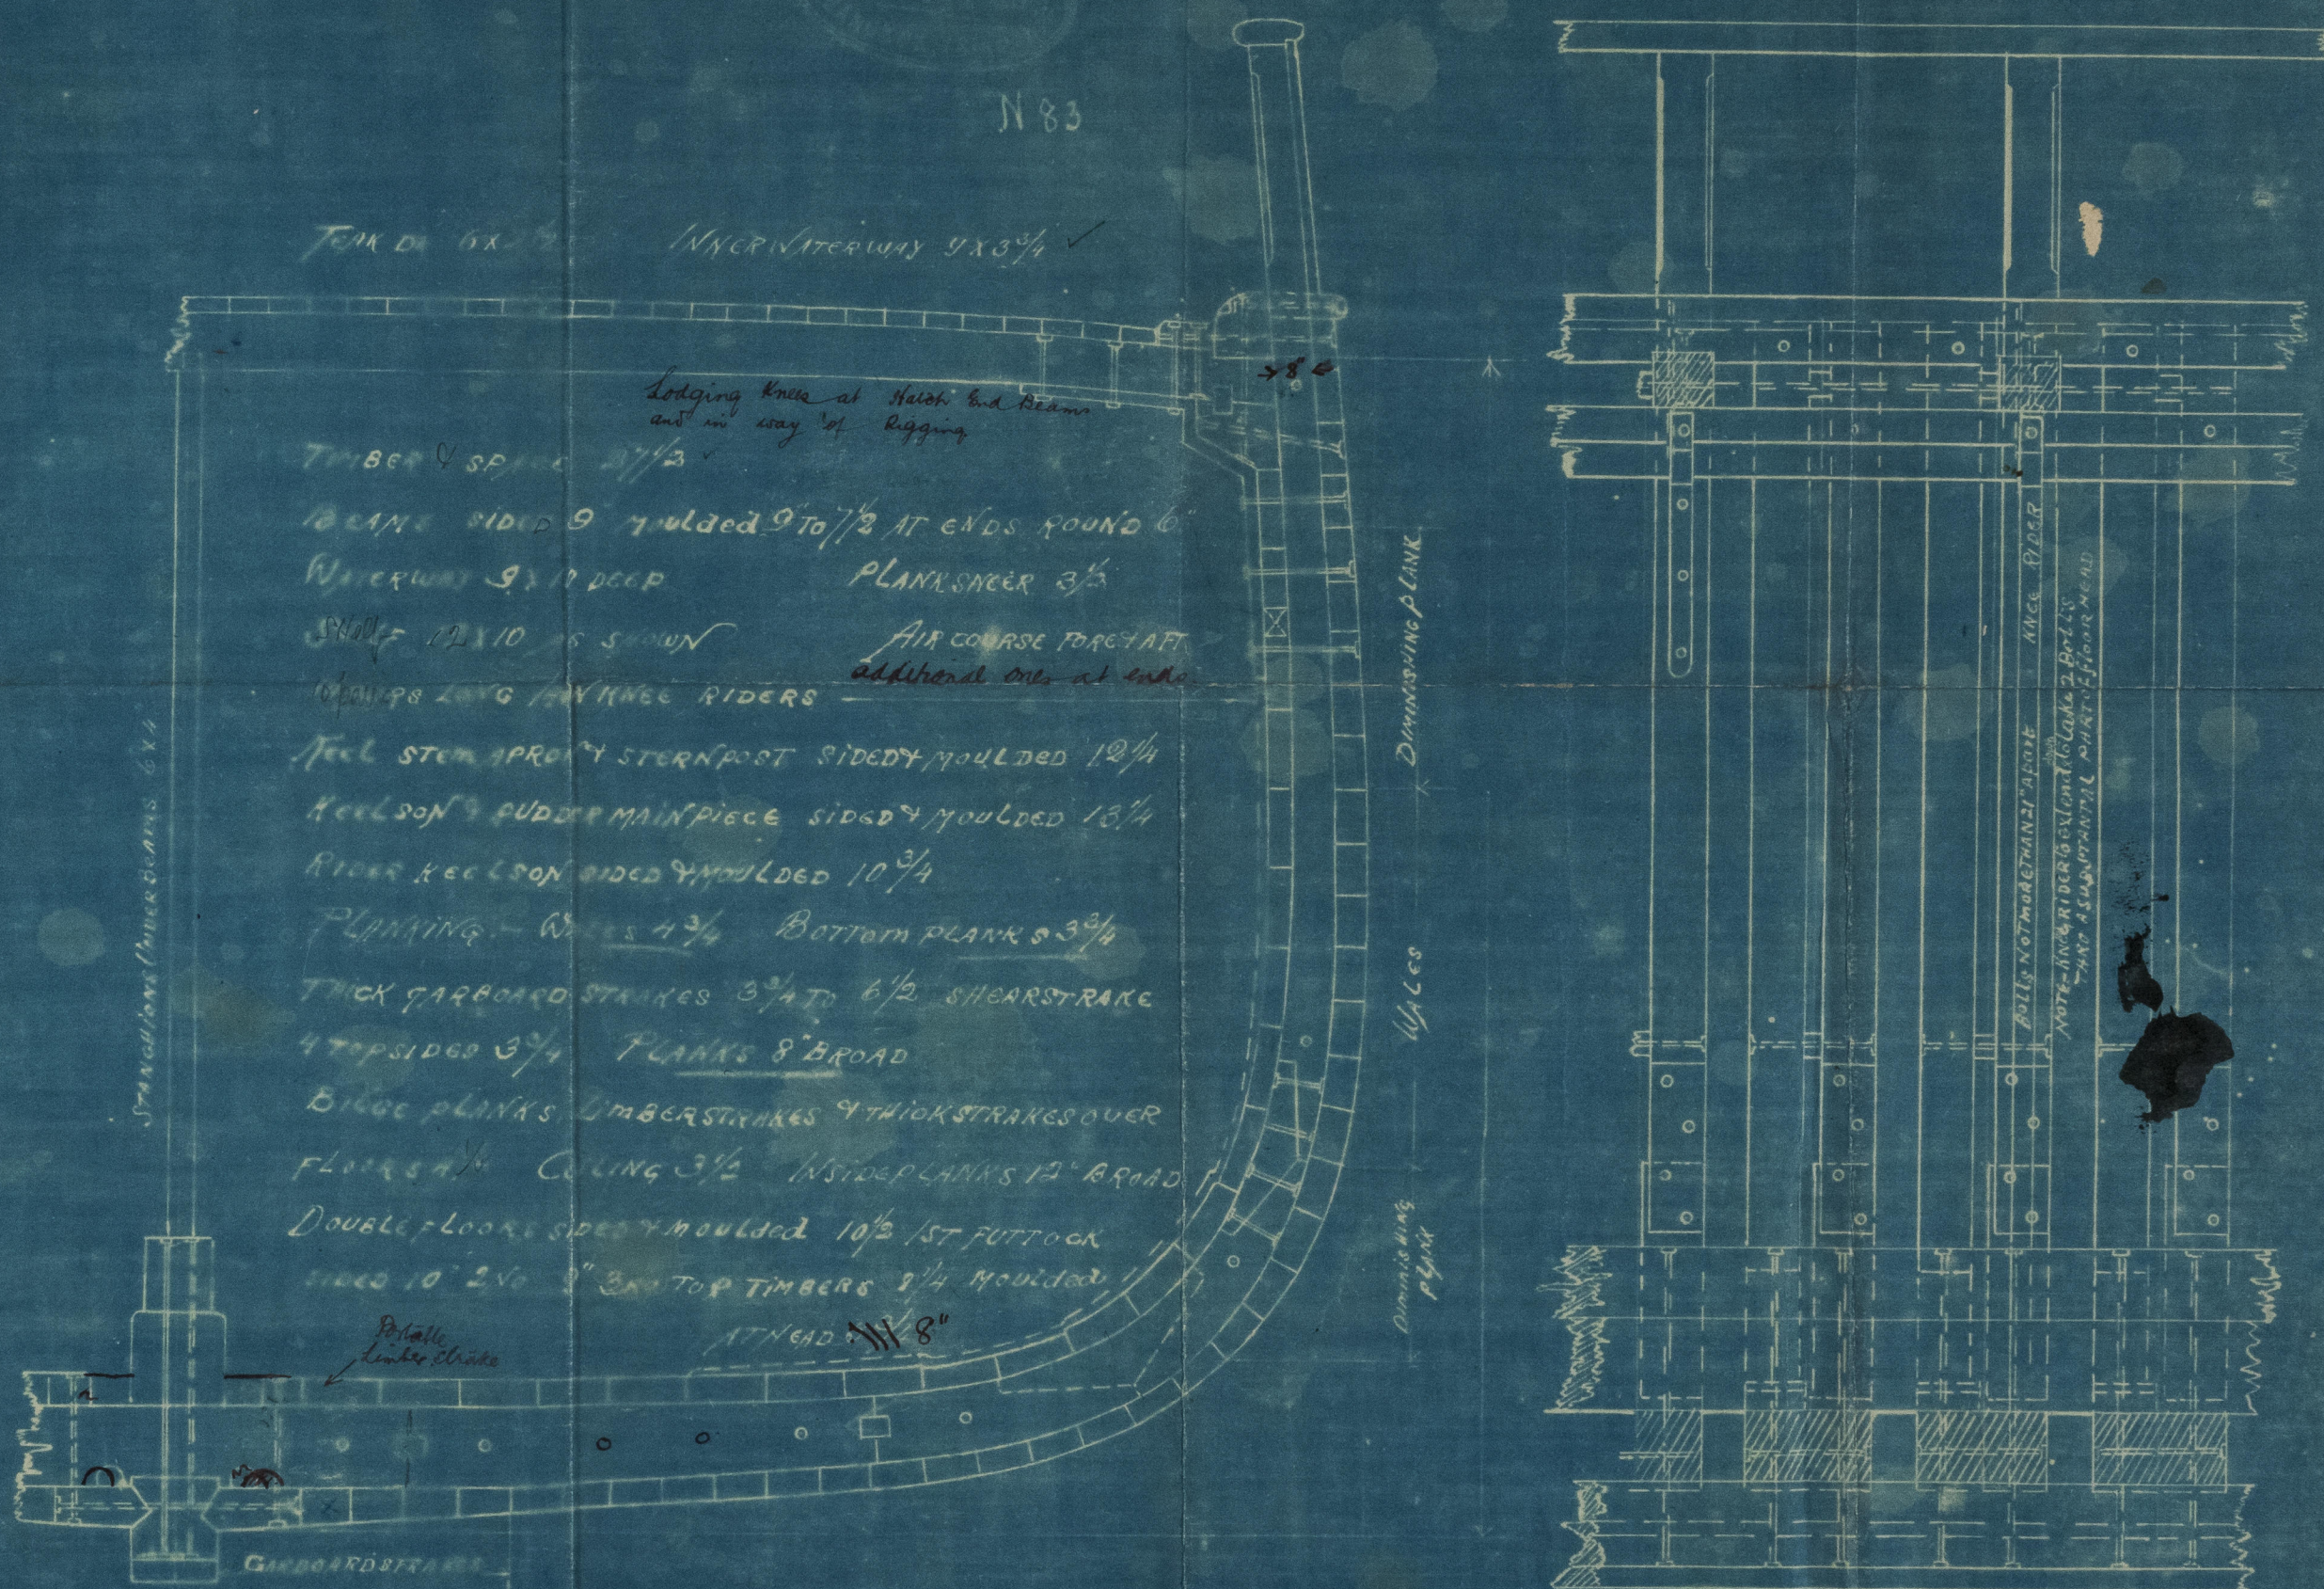

CT. 18
27-6



Lloyd's Register Foundation

W1381-010

Bangkok. Sum

per Lyons Sum

RECEIVED



© 2021

Lloyd's Register
Foundation

W1381-0110