

SCALE :  $\frac{1}{2}$  = 1 FOOT.

EQUIPMENT.

1 COIR TOW ROPE 75 FATHOMS LONG. 10 CIRC.

1 COIL MANILLA " 60 " " 8 "

1 " OF COIR " 60 " " 7 "

1 " " MANILLA " 120 " " 4 " "



1 n n n n 60 n y 3 n

1 " " RATLINE, 18" THREAD 60 FATHOMS LONG

## ANCHOR & CHAIN TO BOARD OF TRADE REQUIREMENTS

22.11.12

17.12.10

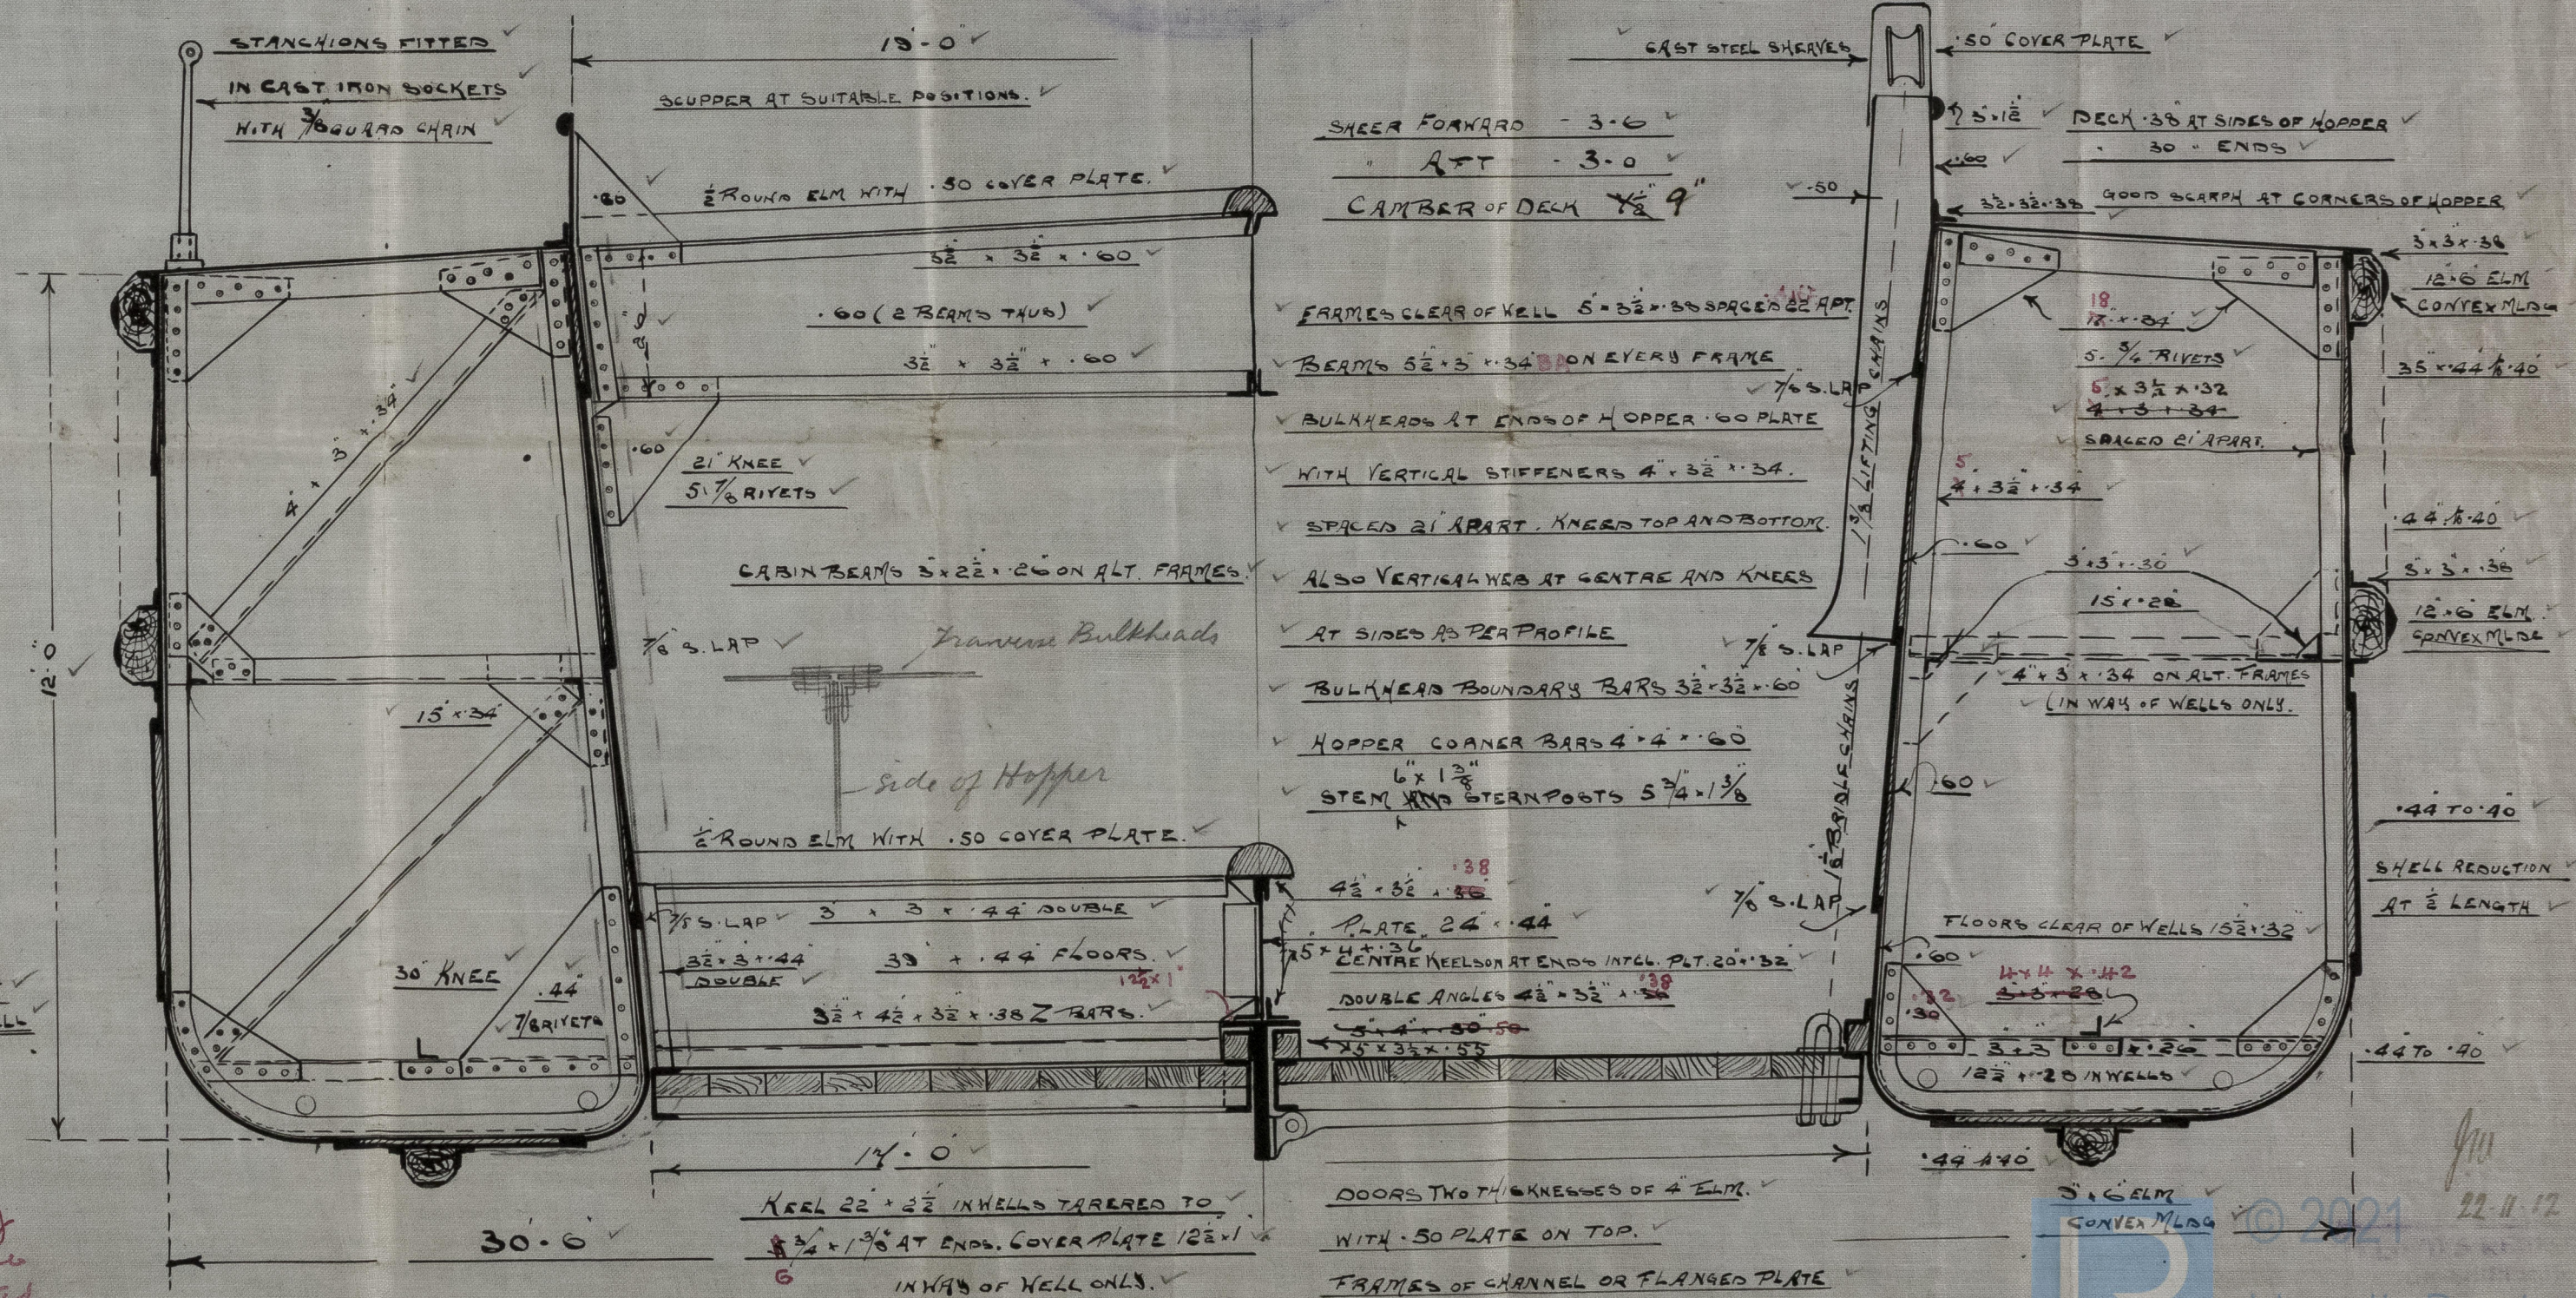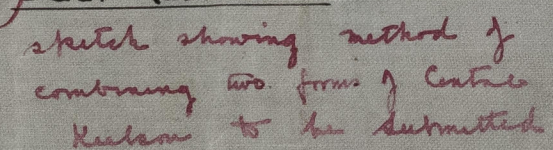

A SECTION IN WAY OF DOOR FLOOR

## SECTION IN WAY OF CHAIN PIPE



W.H. Warren's  
No. 112

Midslip Section

Bge BHC No 15  
12

Hull Rpt No 27835



W1381-0151



© 2021

Lloyd's Register  
Foundation