



3rd. 10

Scale  $\frac{1}{4}" = 1 \text{ ft.}$

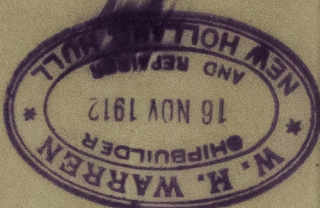

17.12.12

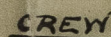


ENTRANCE  
TO WING

-42-0

STORE

CHAINS ✓

28. 29.

LLOYD'S REGISTER  
OF SHIPPING.  
19 NOV 1912  
HULL. No.

✓ FRAMES SPACED 22" APART

FRAMES SPACED 2' APART

FRAMES SPACED 21" APART

FRAMES SPACED 22 APART

Pillars throughout to surveyor's satisfaction

5210-1881W

W1381-0152





W. H. Warren's  
no. 112


Profile

20 NOV 1912  
LONDON

16 DEC 12

By "BAC No 15"

Hull Pt. No. 2783

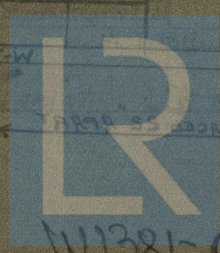

© 2021

Lloyd's Register  
Foundation

W1381-0152