

25. 11. 12




GENERAL ARRANGEMENT

N^o 1104111

$$75.0 = 25.0 + 10.0$$

SCALE $\frac{1}{4}$ = 1 FOOT


CLASS 100, A.1

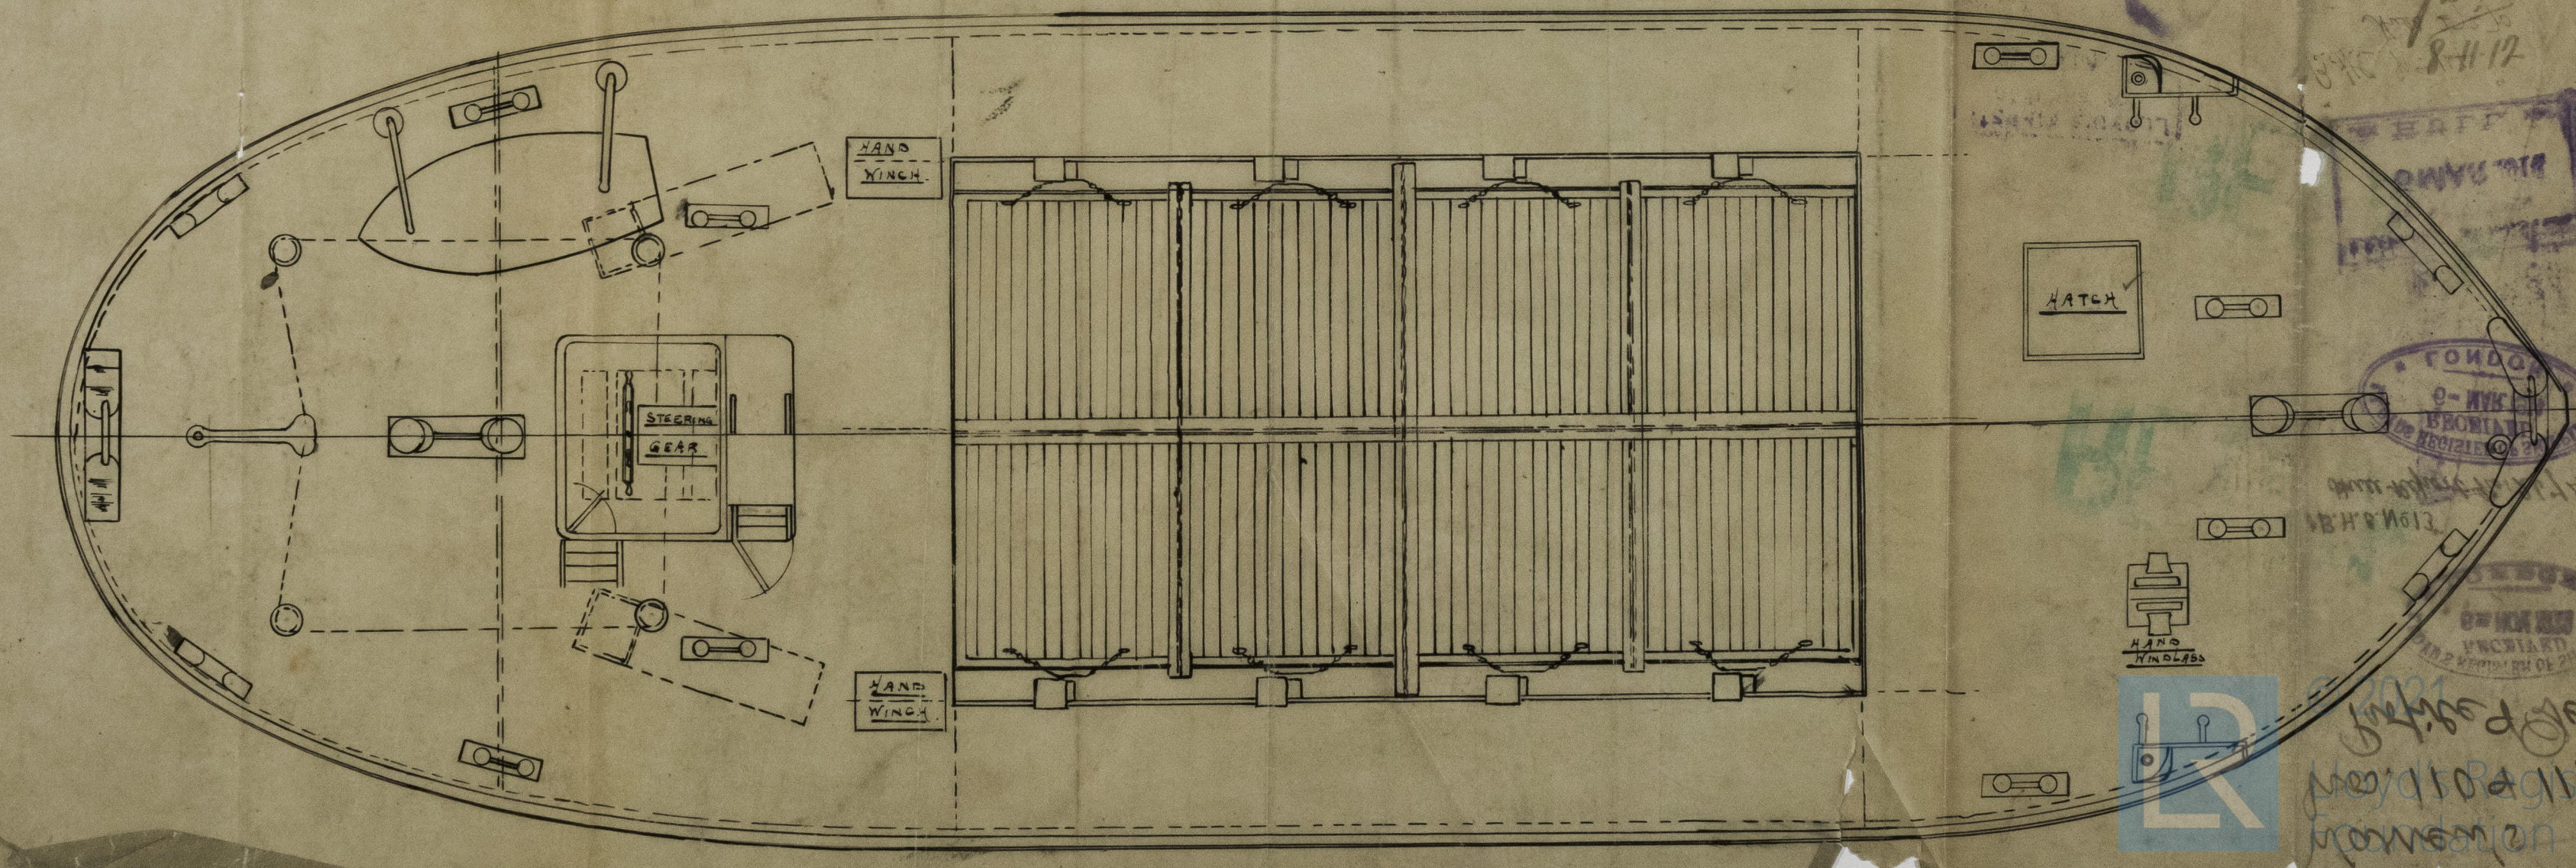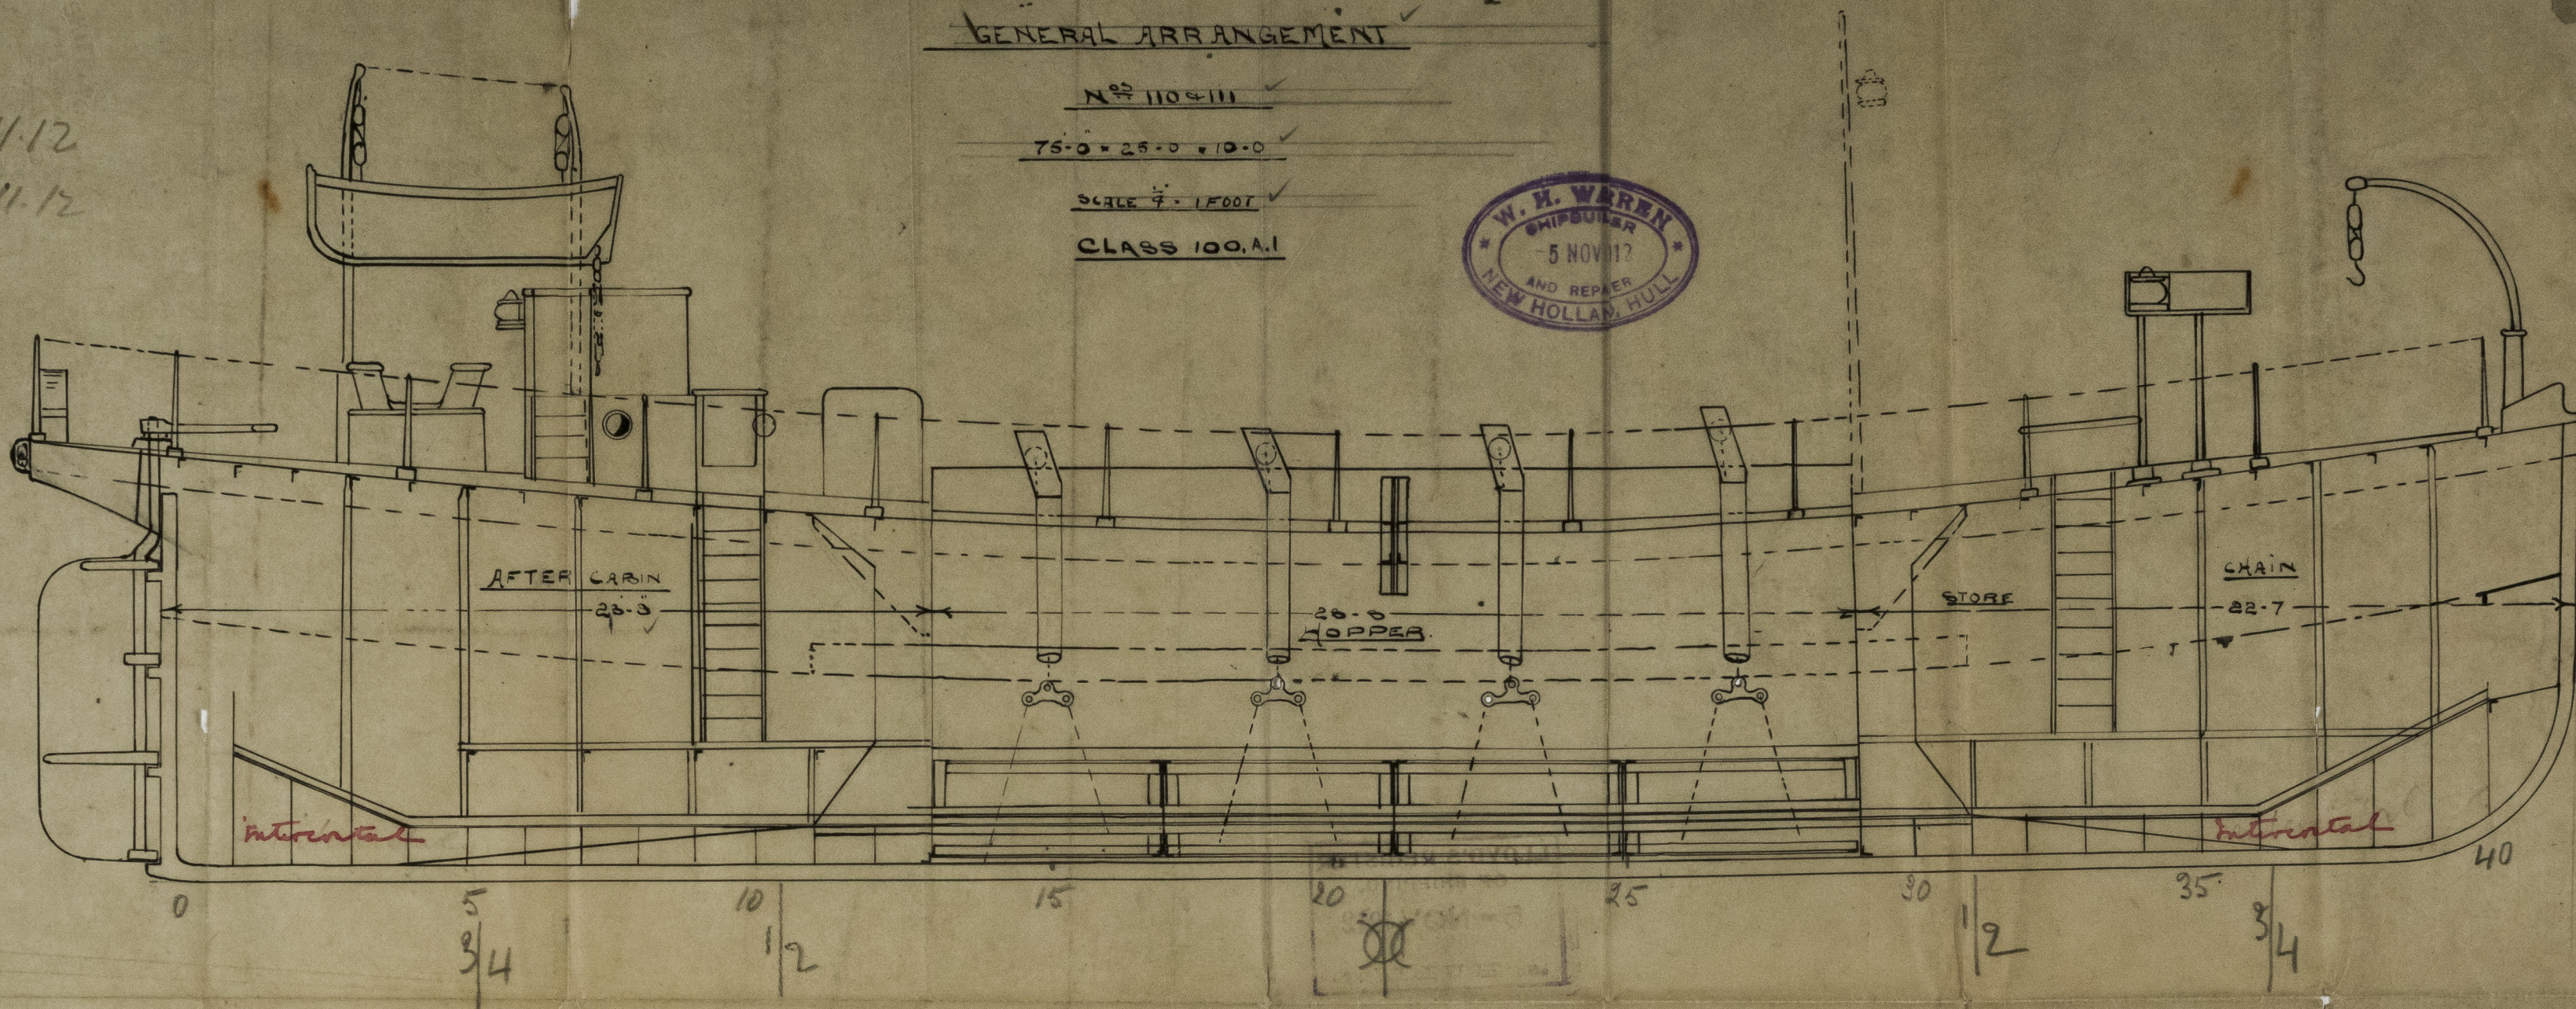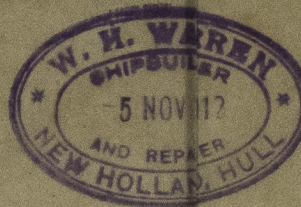

W1381-0191



2021
Meyd's Registe
Foundation

Warren's
nos. 110 & 111
Profile & Deck

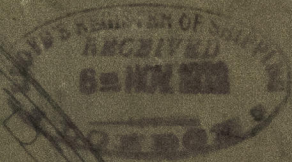

B.H.C. No 13

Hull Report No 26743

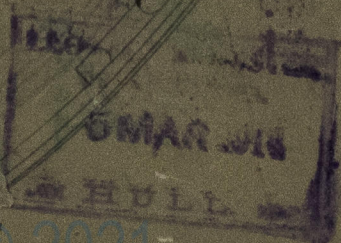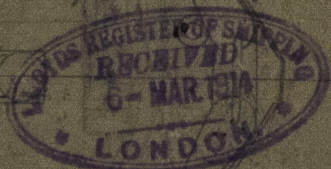

© 2021
Lloyd's Register
Foundation

W1381-0191