

8.11.12
22.11.12

MIDSHIP SECTION


N^{os} 110 & 111

1/2 = 1 FOOT.

75.0 x 25.0 x 10.0



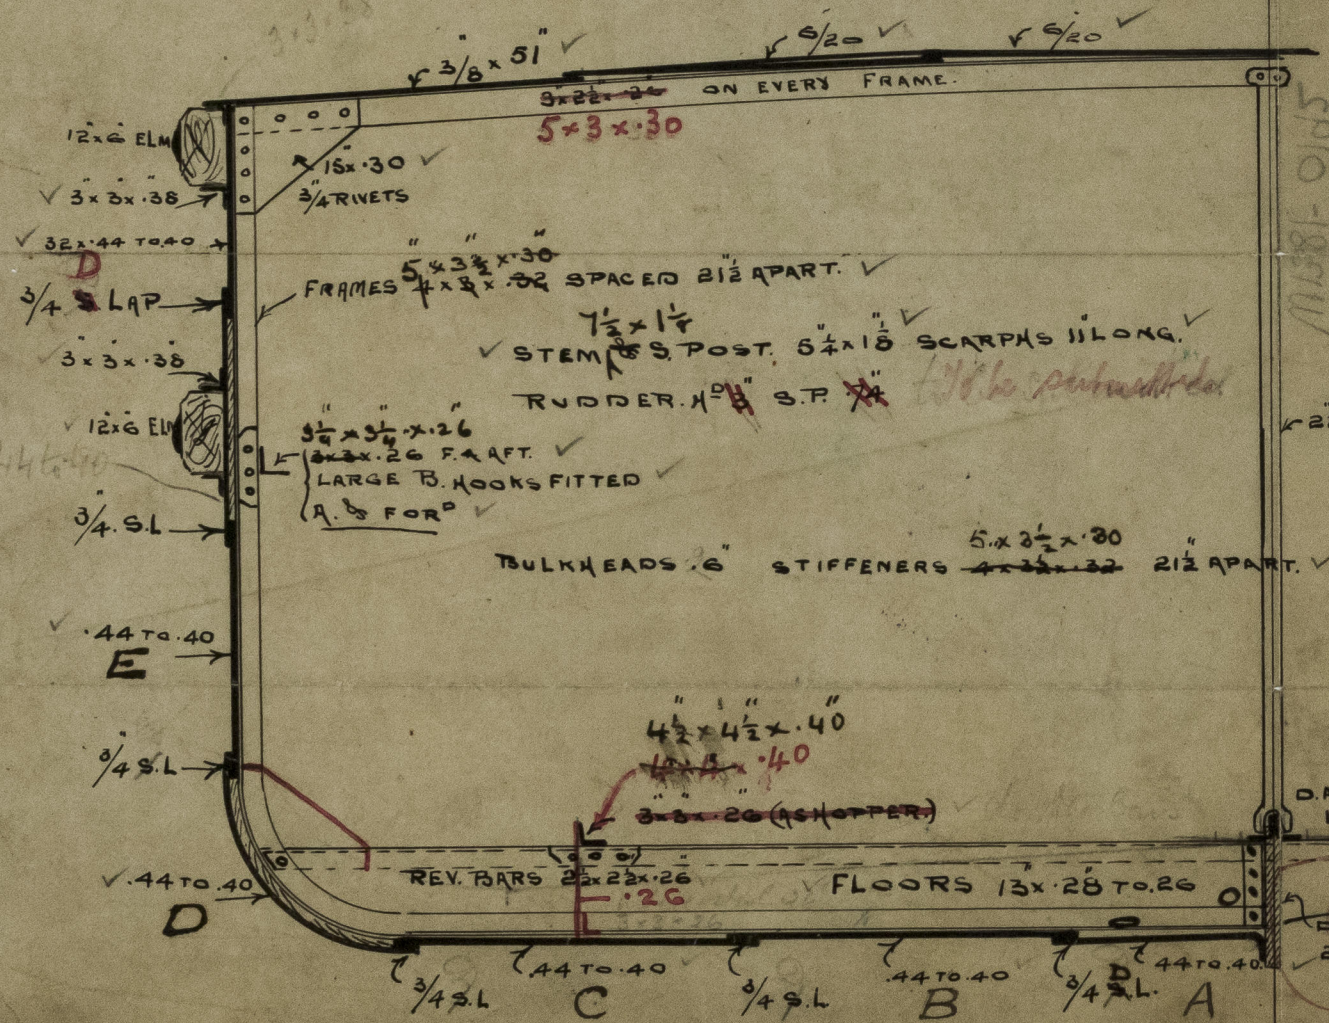


35
2625

LONDON
8-MAY-1914
REGISTERED
TRADE MARKS

LONDON
8-MAY-1914
REGISTERED
TRADE MARKS

EQUIPMENT

75 FATHOMS COIR ROPE (TOW): 3" CIRC.

60 20 MANILLA 5 1/2 CIRC.

60 02 00 3

1 COIL 18 THREAD RATLINE.

ONE ANCHOR & CHAIN TO B/T REQ^{TS}

W. H. WARREN
SHIPBUILDER
-4 NOV 1917
AND REPAIRER
NEW HOLLAND, HULL

CLASS 100.A.1.

D.A. 32x32x.34 F&A OF WELL
I.P. 162x.30

DEEP KEEL
20 x 2 1/4

Sketch showing method
of combining two forms
of centre keelson to be
submitted



LR

© 2021
Lloyd's Register
Foundation




W1381-0192

Warren's
Nos. 1109 111
Kiddulph Section

Hopper Bay
"B.H.C. No. 13"
Hull 26743
"B.H.C. No. 14"
Hull 27270

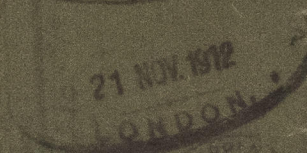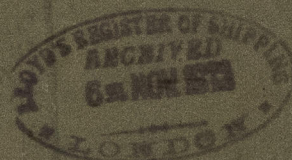

"B.H.C. No. 13"
Hull Report No. 26743

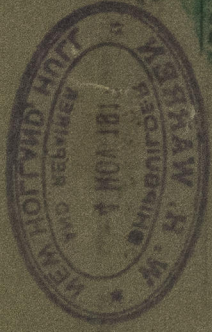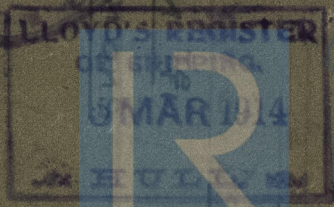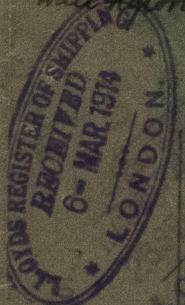

1. A.O.C. 1821

THE LLOYD'S REGISTER OF SHIPPING

THE LLOYD'S REGISTER OF SHIPPING

W1381-0192

© 2021

Lloyd's Register Foundation