


*Keel as built
in old
23rd June 1920*

— M. B. "EVELYN - HOPE" — — MIDSHIP SECTION —

SCALE: 1/2 IN. = 1 FT

PORTABLE BEAMS IN WAY OF HATCHES.

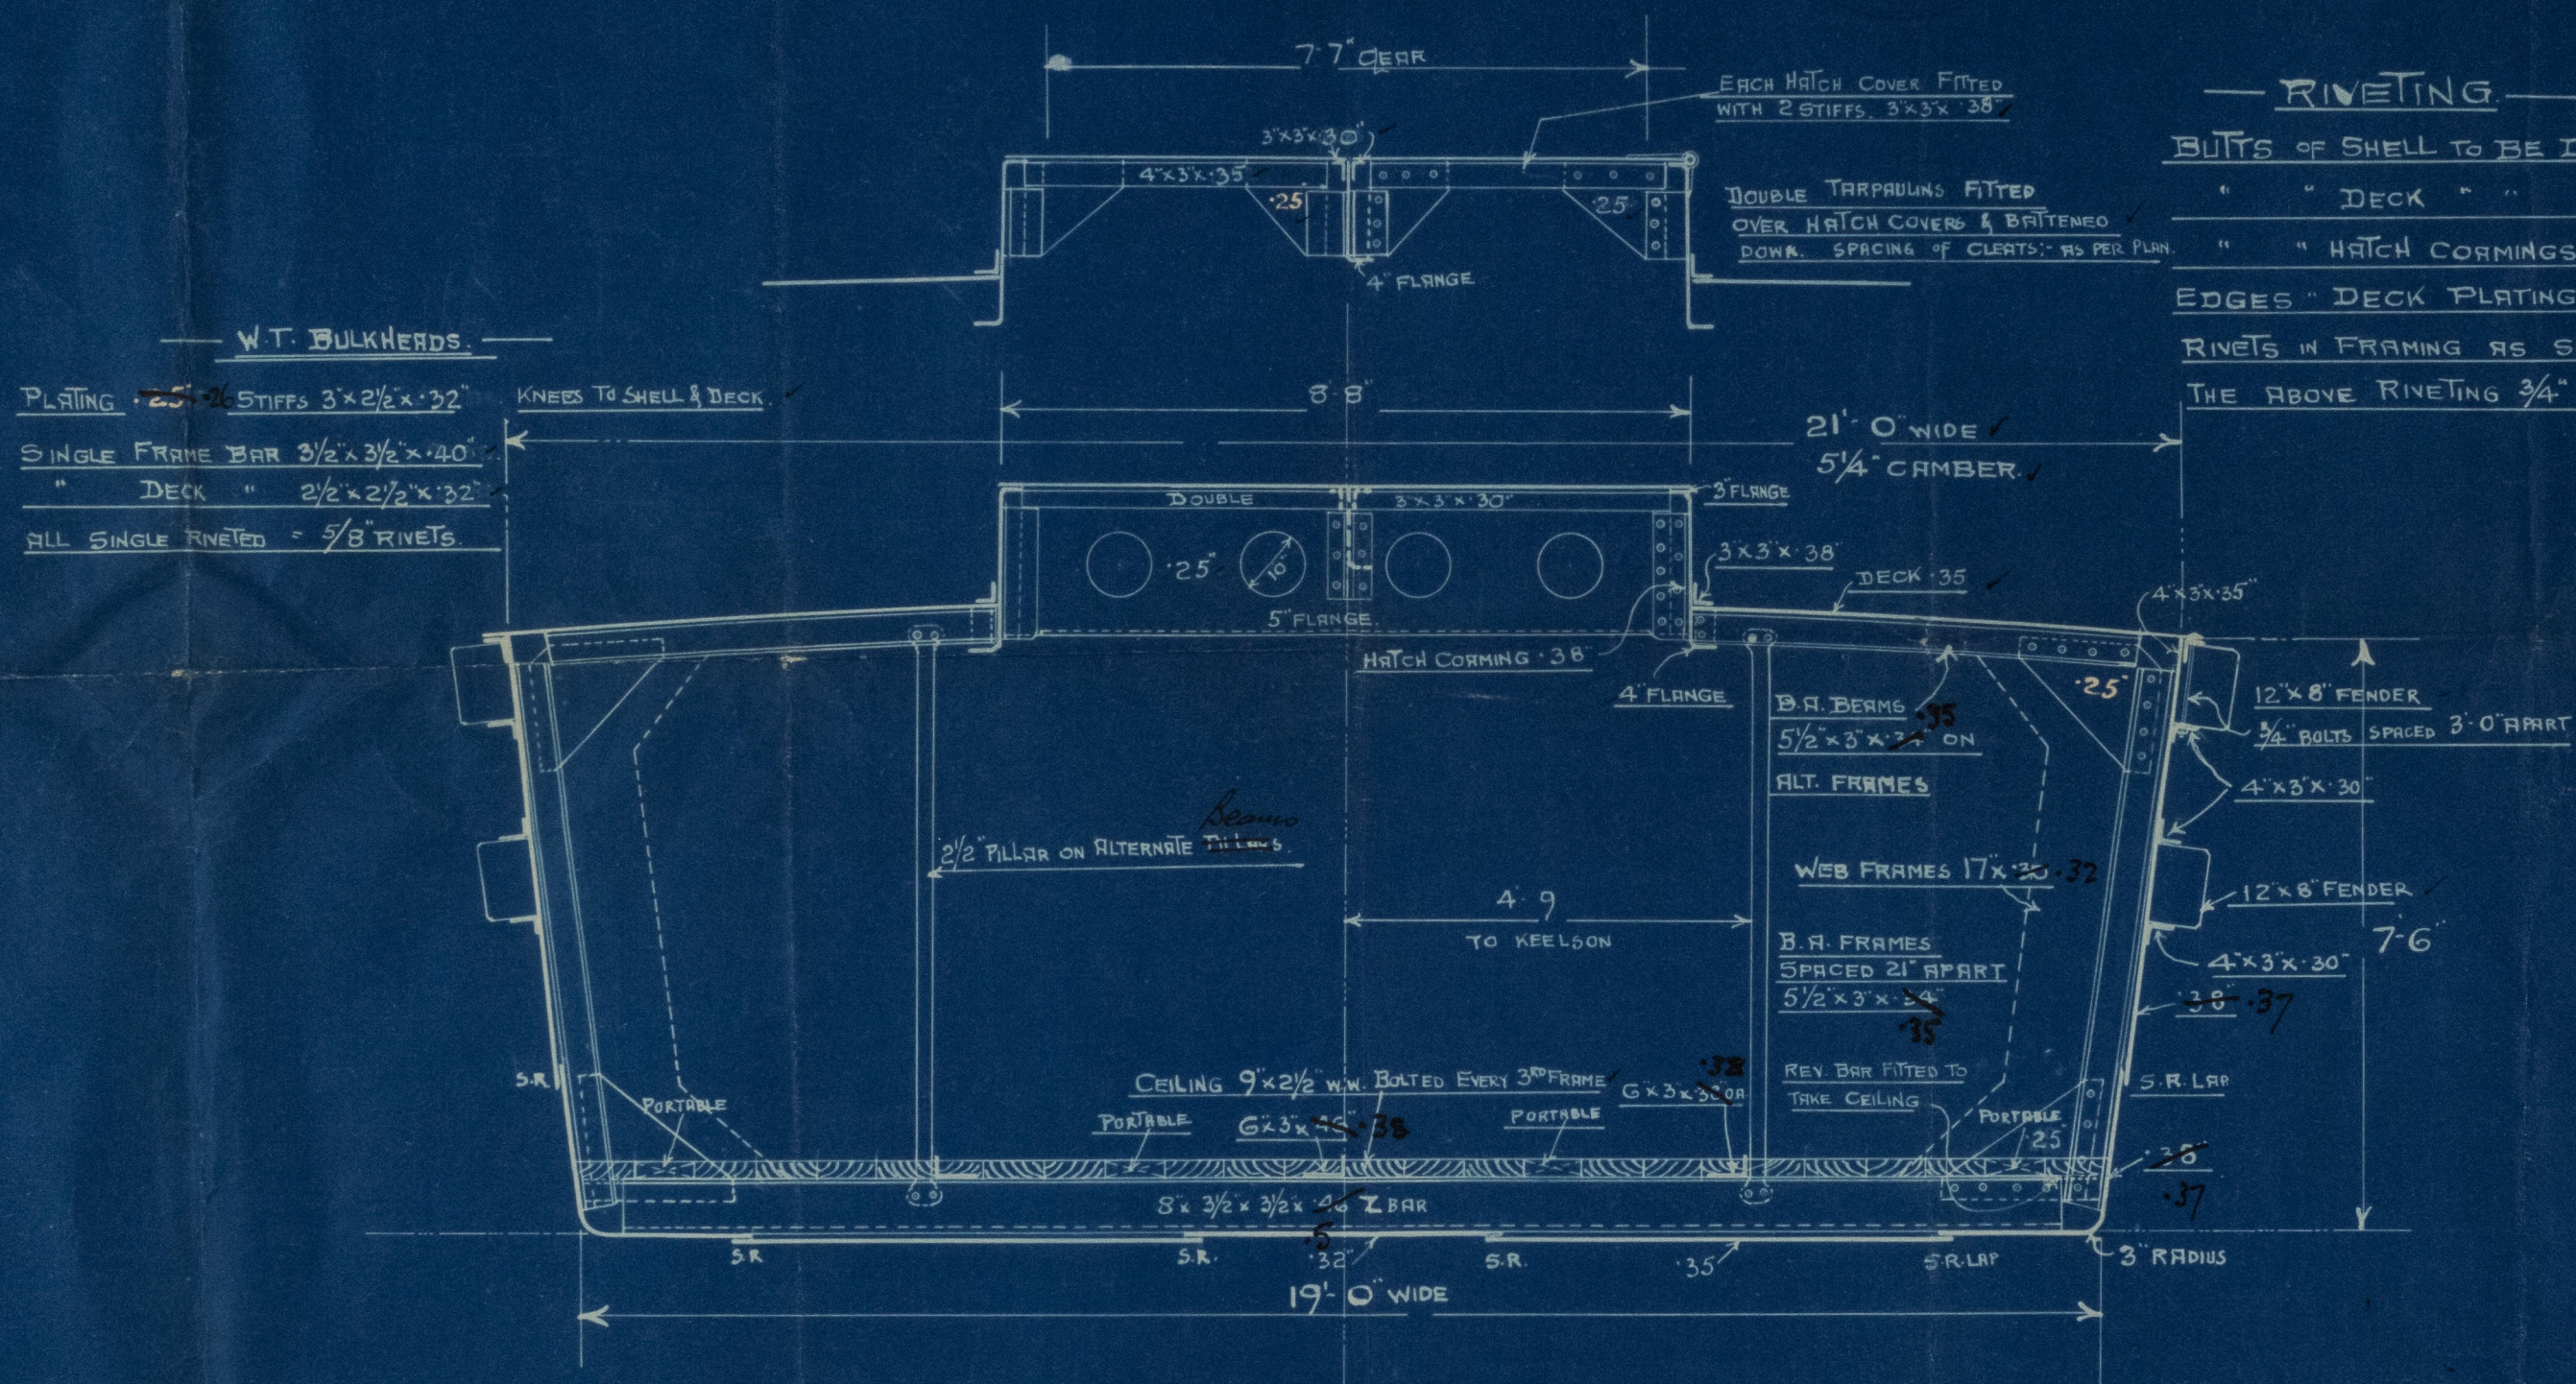

— RIVETING —
 BUTTS OF SHELL TO BE DOUBLE RIVETED
 " " DECK " " " "
 " " HATCH CORMINGS " "
 EDGES " DECK PLATING SINGLE " "
 RIVETS IN FRAMING AS SHOWN
 THE ABOVE RIVETING 3/4" THROUGHOUT.



© 2021
 Lloyd's Register
 Foundation

W1383-0137

~~Motor~~ Barge "Emelyn Hope"
Inside hip Section

RETAIN

W1383-0137

RETAIN



© 2021

Lloyd's Register
Foundation